

BOX BEAM GUARDRAIL  
STA. 168+75 TO 170+00, LT

REMOVAL AND DISPOSAL OF GUARDRAIL  
STA. 168+84 TO 170+00, LT  
75


DURABLE & TEMPORARY 4 INCH WHITE LINE  
(ALL LINES WILL INCLUDE EDGE LINE BREAKS  
AND RADII FOR SIDE ROADS)  
STA. 165+00 TO 170+00, SOLID LT & RT  
STA. 165+00 TO 170+00, DASHED LT (LANE LINE)  
STA. 165+00 TO 170+00, DASHED RT (LANE LINE)  
STA. 169+08 TO 170+00, DOTTED RT (LANE LINE)

DURABLE & TEMPORARY 4 INCH YELLOW LINE  
(ALL LINES WILL INCLUDE C BREAKS FOR SIDE ROADS)  
STA. 165+00 TO 170+00, SOLID LT & RT


DURABLE & TEMPORARY 8 INCH WHITE LINE  
STA. 166+65 TO 166+95, RT (HYDRANT) SEE SHEET 206

REMOVING SIGNS  
AS SHOWN - 5

DELINEATOR WITH STEEL POST  
STA. 166+67 TO 168+17, LT  
(4 EA INSTALLED AS SHOWN OR AS  
DIRECTED BY THE ENGINEER)

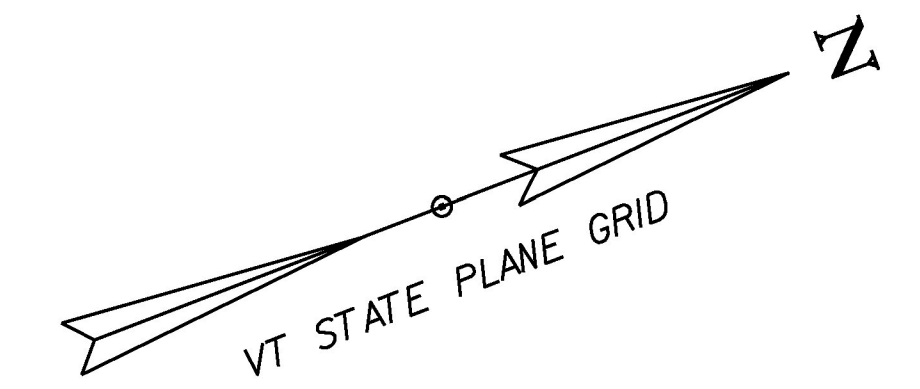

CURVE 5 DATA  
PC = 165+67.09  
PT = 170+79.28  
 $\Delta = 2^\circ 56' 04.78''$  LT  
D =  $0^\circ 34' 22.65''$   
R = 10000.00'  
T = 256.15'  
L = 512.20'  
E = 3.28'  
e = NC

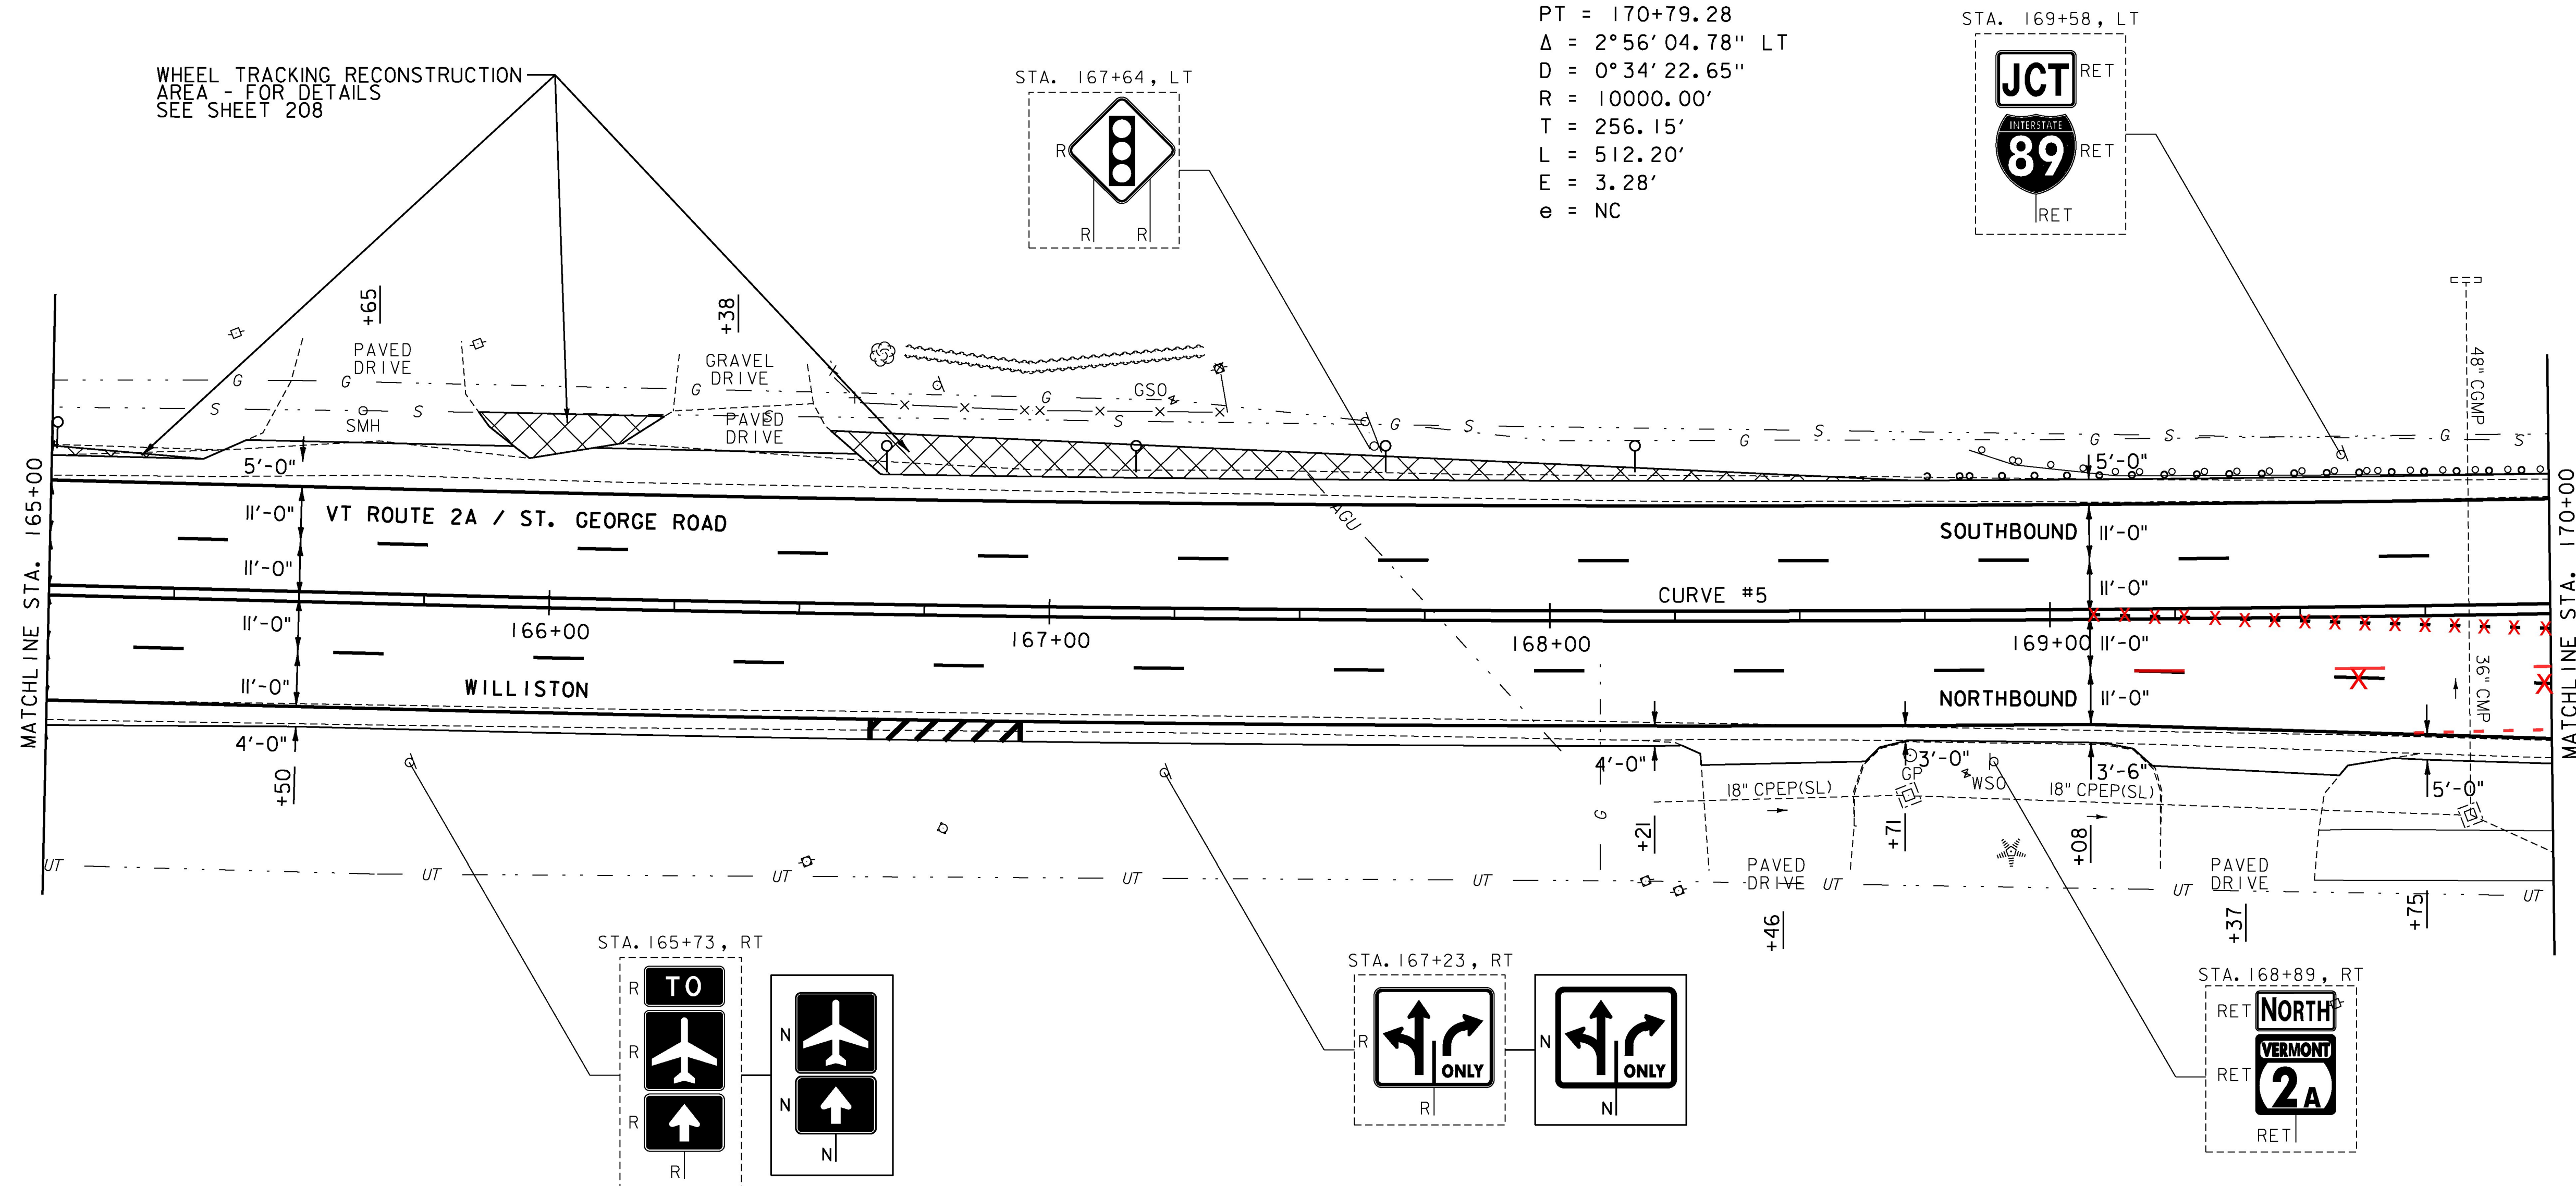

NOTES:

- FOR LEGENDS, SEE SHEETS 3-4.
- ALL EXISTING SIGNS NOT SHOWN ON THE PLANS SHALL BE RETAINED.



PROJECT NAME:	WILLISTON	PLOT DATE:	2/15/2017
PROJECT NUMBER:	NH 2949(I)	DRAWN BY:	D. BARNES
FILE NAME:	z12d224bdr.dgn	DESIGNED BY:	D. BARNES
PROJECT LEADER:	G. EDWARDS	CHECKED BY:	J. LITTLE
LAYOUT SHEET 5		SHEET	224 OF 249