

BOX BEAM GUARDRAIL
 STA. 170+00 TO 172+14.2, LT

REMOVAL AND DISPOSAL OF GUARDRAIL
 STA. 170+00 TO 171+60, LT

DURABLE & TEMPORARY 4 INCH WHITE LINE
 (ALL LINES WILL INCLUDE EDGE LINE BREAKS AND RADII FOR SIDE ROADS)
 STA. 170+00 TO 174+00, SOLID LT & RT
 STA. 170+00 TO 174+00, DASHED LT (LANE LINE)
 STA. 170+00 TO 171+33, DOTTED RT
 STA. 170+00 TO 171+33, DASHED RT (LANE LINE)
 STA. 171+33 TO 174+00, SOLID RT (LANE LINE)
 STA. 171+33 TO 174+00, SOLID RT (LANE LINE)



DURABLE & TEMPORARY 4 INCH YELLOW LINE
 (ALL LINES WILL INCLUDE C BREAKS FOR SIDE ROADS)
 STA. 170+00 TO 174+00, SOLID LT & RT

DURABLE & TEMPORARY 8 INCH WHITE LINE
 STA. 171+81 TO 172+11, RT (HYDRANT) SEE SHEET 206

DURABLE LETTER OR SYMBOL, TYPE D TAPE
 STA. 171+37, RT ARROW (3)
 STA. 172+33, RT "ONLY" (8)
 STA. 173+30, RT ARROW (3)

TEMPORARY LETTER OR SYMBOL, PAINT
 STA. 171+37, RT ARROW (3)
 STA. 173+30, RT ARROW (3)

DELINEATOR WITH STEEL POST
 STA. 172+75 TO 173+75, LT
 (3 EA INSTALLED AS SHOWN OR AS DIRECTED BY THE ENGINEER)

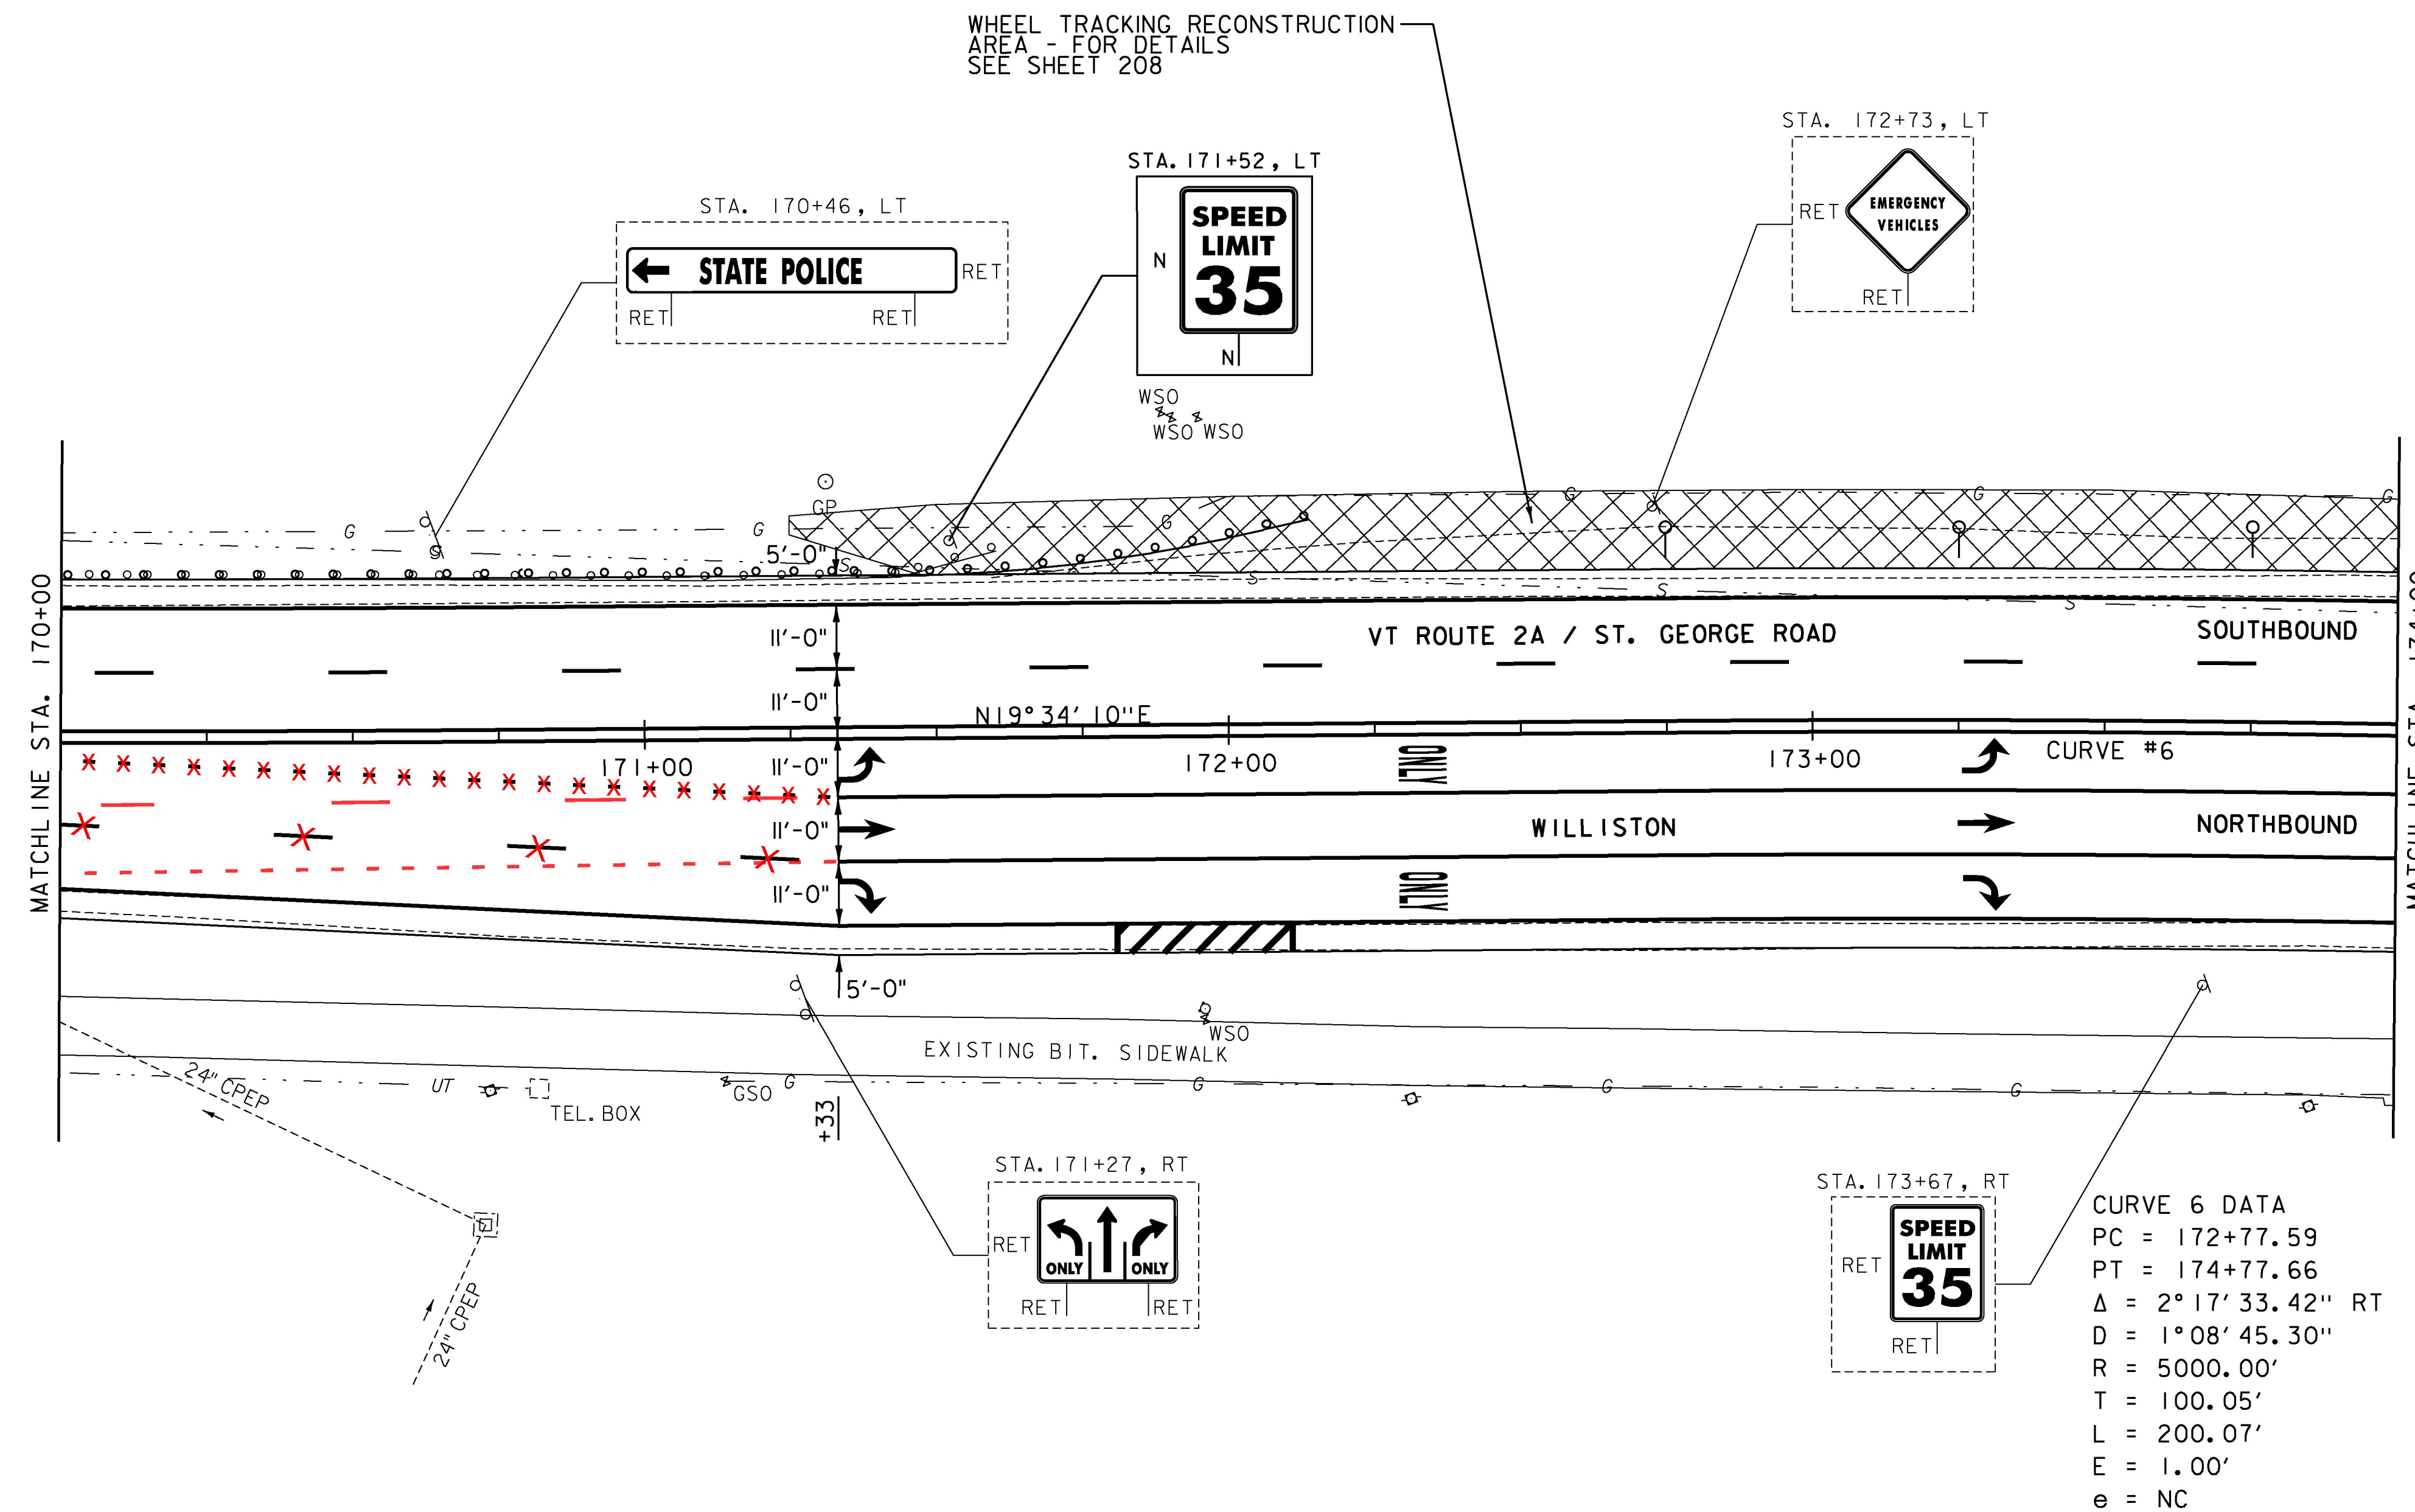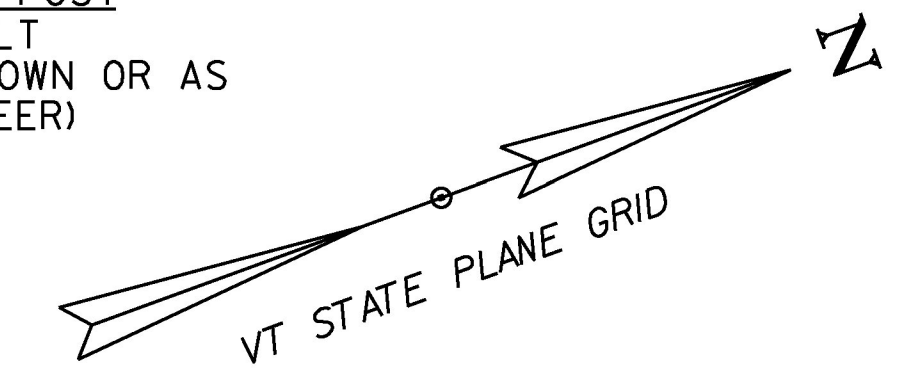

NOTES:

- FOR LEGENDS, SEE SHEETS 3-4.
- ALL EXISTING SIGNS NOT SHOWN ON THE PLANS SHALL BE RETAINED.



PROJECT NAME: WILLISTON	PLOT DATE: 2/15/2017
PROJECT NUMBER: NH 2949(1)	DRAWN BY: D. BARNES
FILE NAME: z12d224bdr.dgn	DESIGNED BY: D. BARNES
PROJECT LEADER: G. EDWARDS	CHECKED BY: J. LITTLE
LAYOUT SHEET 6	SHEET 225 OF 249