

**DURABLE & TEMPORARY 4 INCH WHITE LINE**  
 (ALL LINES WILL INCLUDE EDGE LINE BREAKS AND RADII FOR SIDE ROADS)  
 STA. 190+50 TO 194+50, SOLID LT & RT  
 STA. 190+50 TO 190+52, DOTTED RT  
 STA. 190+50 TO 191+89, SOLID LT (LANE LINE)  
 STA. 190+52 TO 194+50, SOLID RT (LANE LINE)  
 STA. 191+00 TO 192+80, DOTTED RT  
 STA. 191+89 TO 194+50, DASHED LT (LANE LINE)  
 STA. 192+80 TO 194+50, SOLID RT (LANE LINE)

**DURABLE & TEMPORARY 4 INCH YELLOW LINE**  
 (ALL LINES WILL INCLUDE C BREAKS FOR SIDE ROADS)  
 STA. 190+50 TO 194+50, SOLID LT & RT



**DURABLE & TEMPORARY 8 INCH WHITE LINE**  
 STA. 190+50 TO 190+67, RT (HYDRANT) SEE SHEET 206

**DURABLE LETTER OR SYMBOL, TYPE D TAPE**  
 STA. 190+56, RT ARROW  
 STA. 191+40, RT "ONLY"  
 STA. 192+23, RT ARROW  
 STA. 192+84, RT ARROW (2)  
 STA. 192+85, RT ARROW  
 STA. 193+35, RT "ONLY"  
 STA. 193+51, RT "ONLY"  
 STA. 193+86, RT ARROW  
 STA. 194+12, RT ARROW  
 STA. 194+17, RT ARROW  
 STA. 194+37, RT "ONLY"


**TEMPORARY LETTER OR SYMBOL, PAINT**  
 STA. 190+56, RT ARROW  
 STA. 192+23, RT ARROW  
 STA. 192+84, RT ARROW (2)  
 STA. 192+85, RT ARROW  
 STA. 193+86, RT ARROW  
 STA. 194+12, RT ARROW  
 STA. 194+17, RT ARROW

**REMOVING SIGNS**  
 AS SHOWN - 1

**ERECTING SALVAGED SIGNS**  
 AS SHOWN - 1

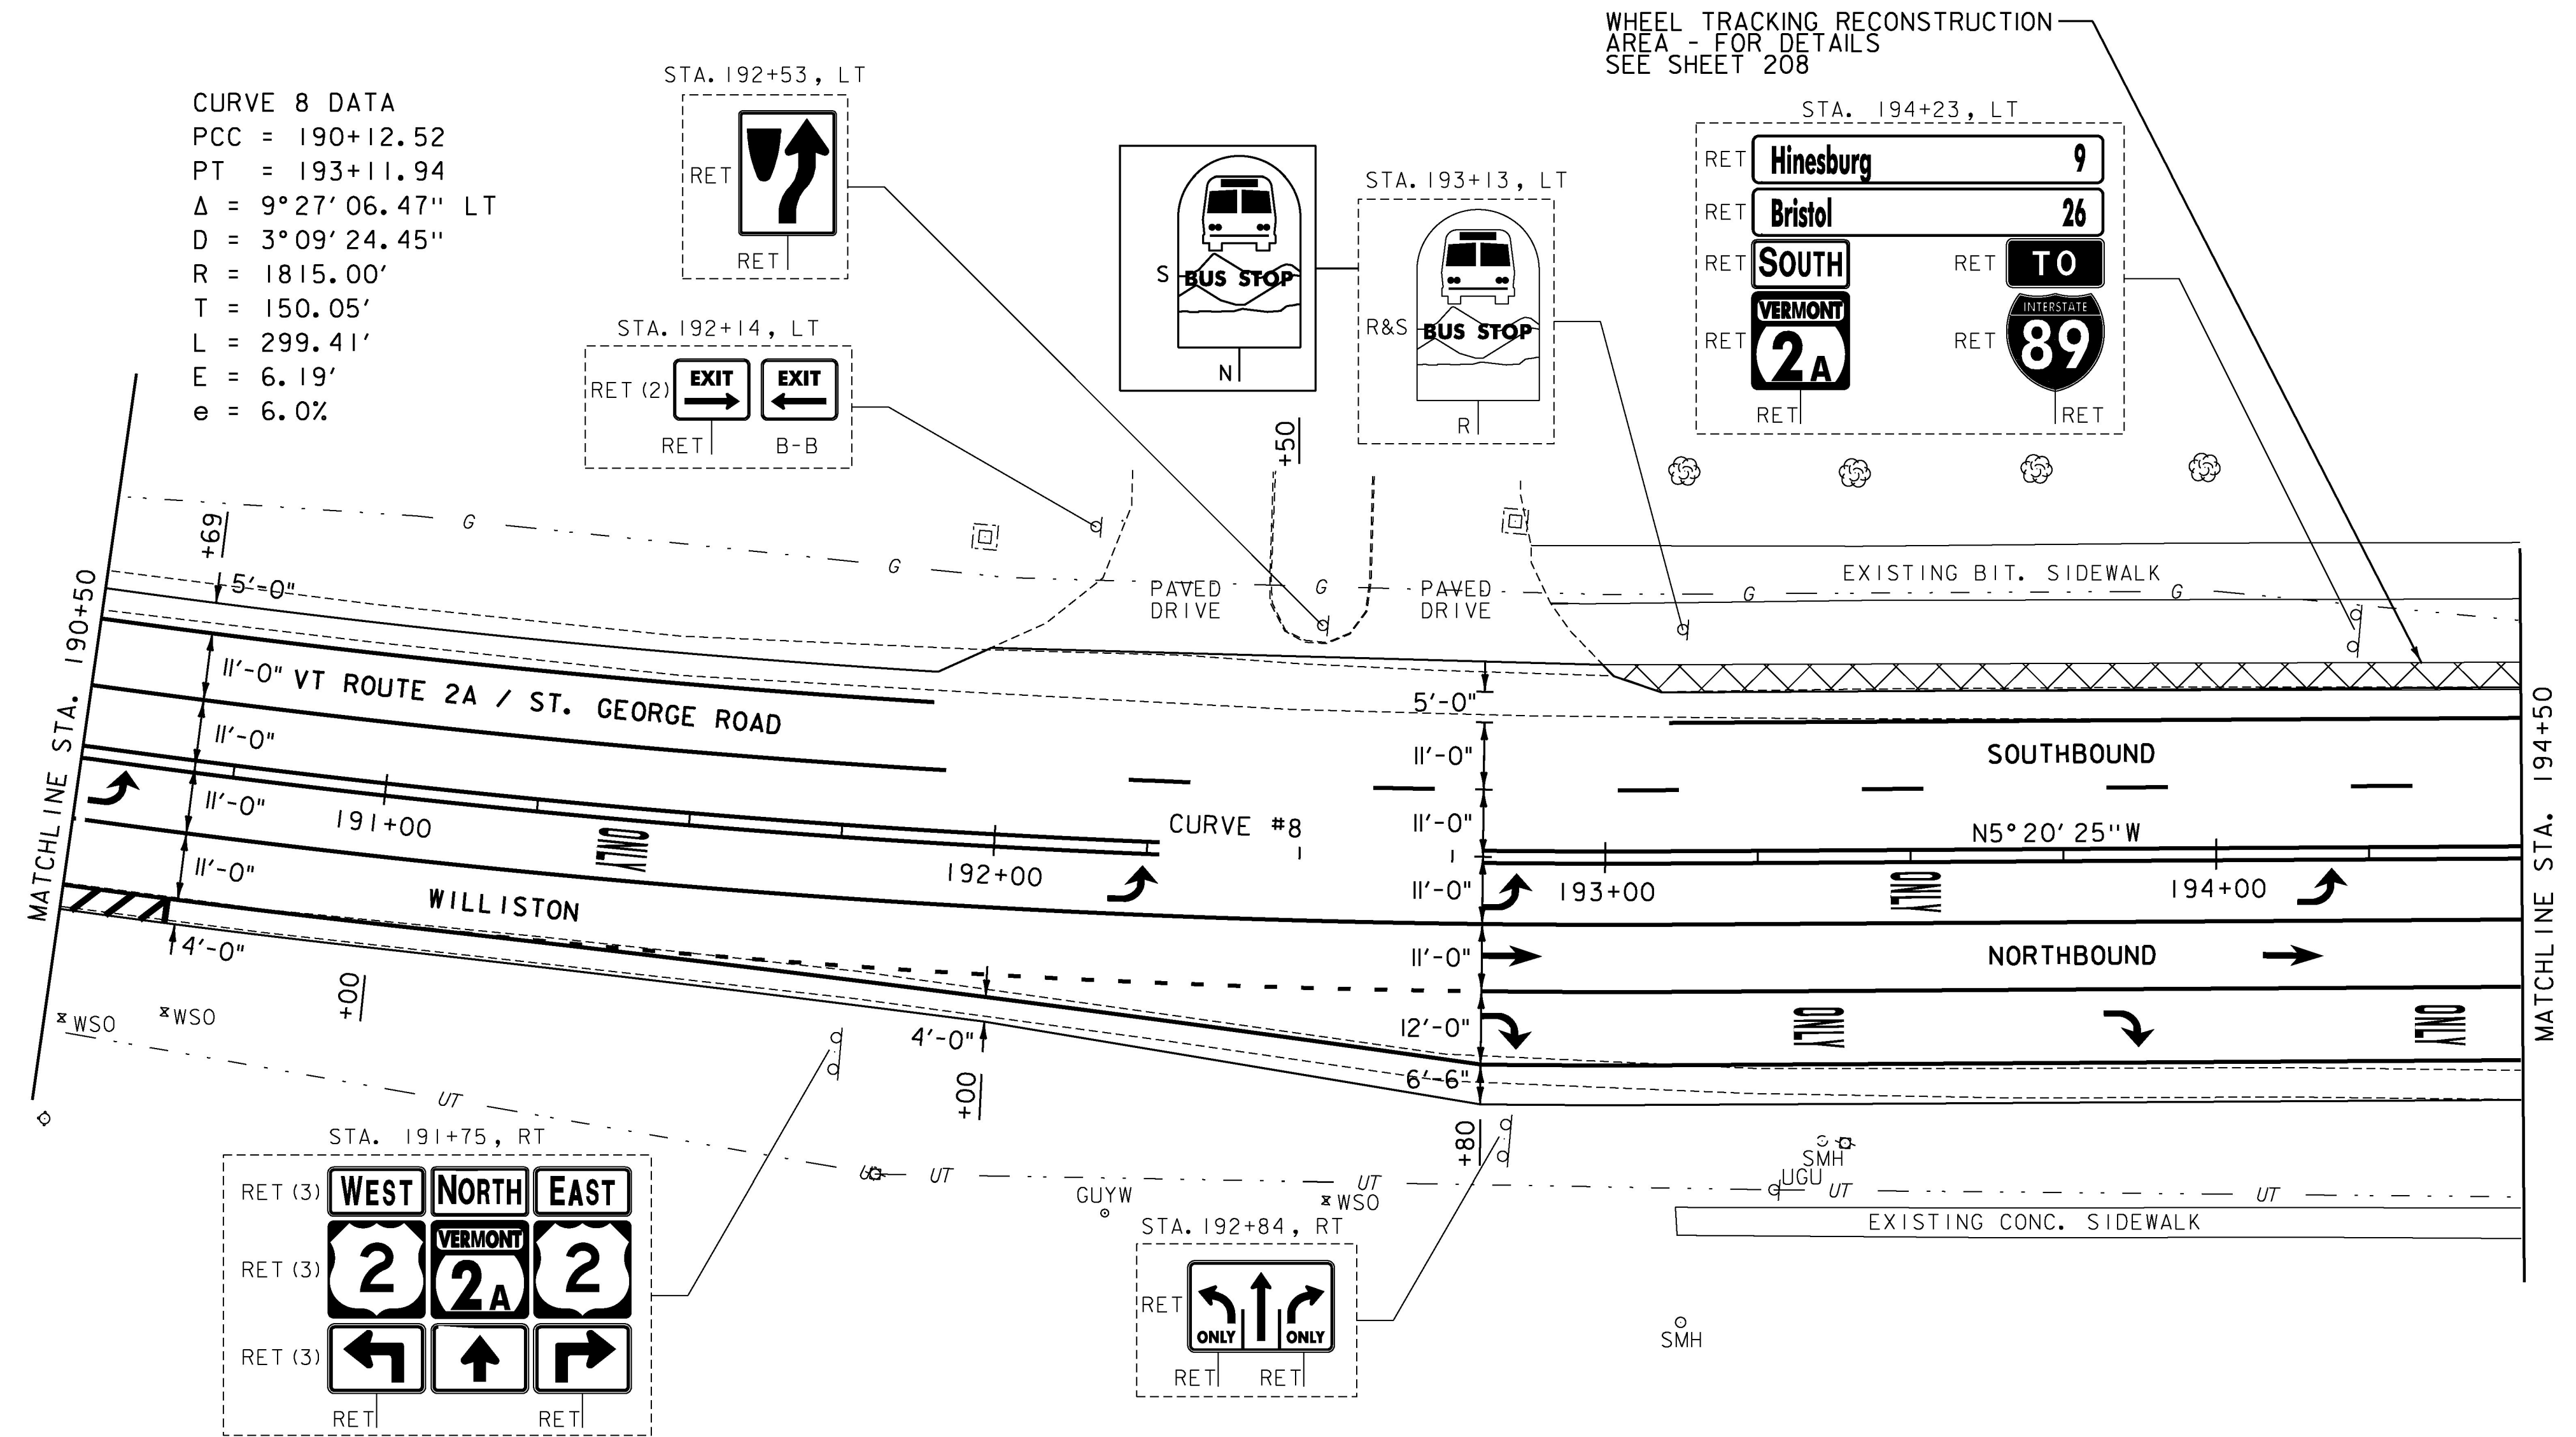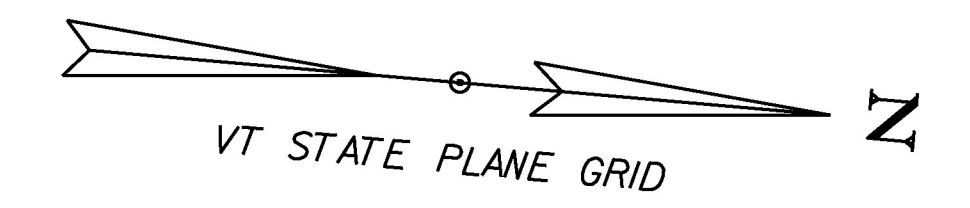

**NOTES:**  
 1. FOR LEGENDS, SEE SHEETS 3-4.  
 2. ALL EXISTING SIGNS NOT SHOWN ON THE PLANS SHALL BE RETAINED.

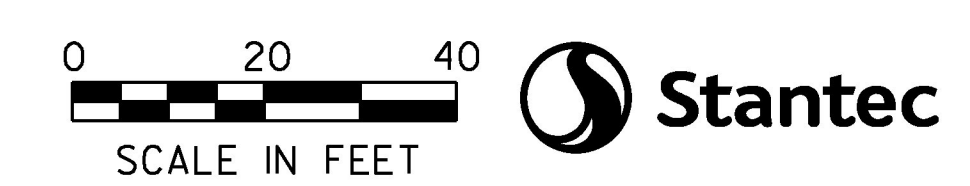

PROJECT NAME: WILLISTON	PLOT DATE: 2/15/2017
PROJECT NUMBER: NH 2949(I)	DRAWN BY: D. BARNES
FILE NAME: z12d224bdr.dgn	CHECKED BY: J. LITTLE
PROJECT LEADER: G. EDWARDS	SHEET 230 OF 249
DESIGNED BY: D. BARNES	
LAYOUT SHEET II	