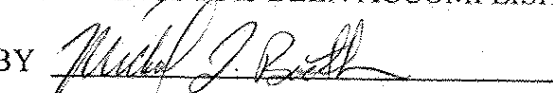


SEE SHEET 2 FOR
INDEX OF SHEETS AND LIST OF STANDARDS

STATE OF VERMONT AGENCY OF TRANSPORTATION

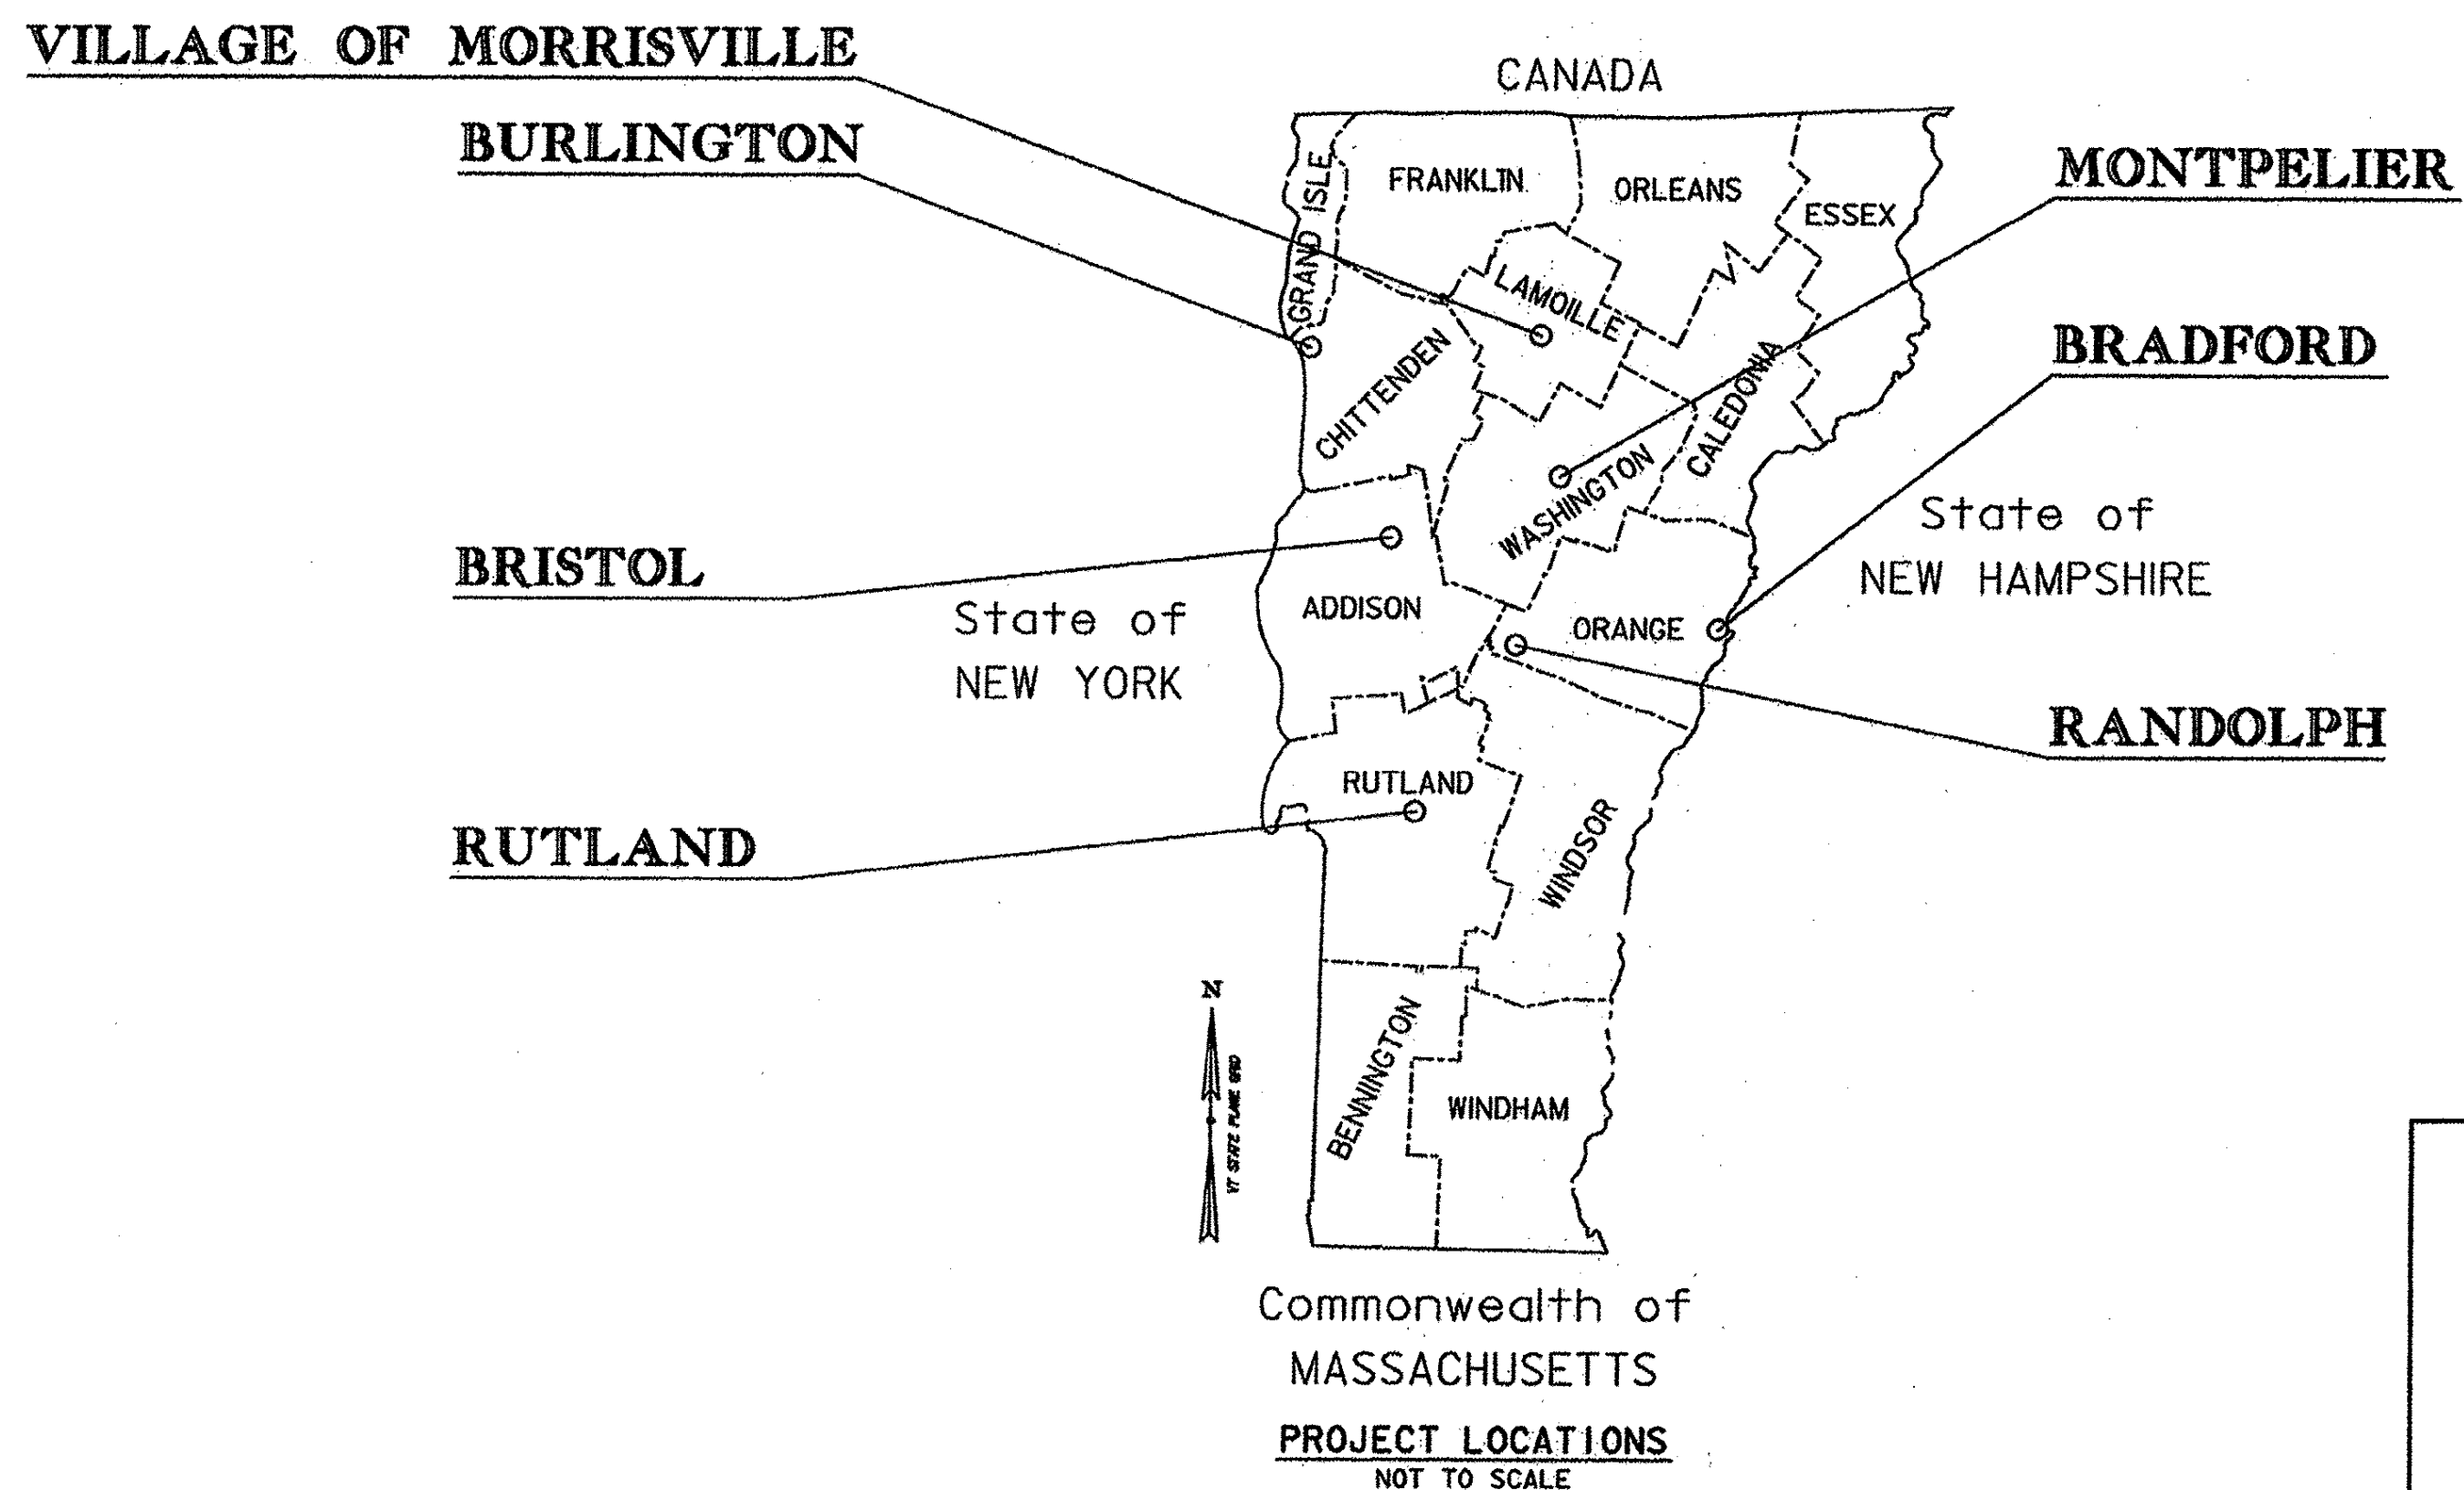


PROPOSED IMPROVEMENTS STATEWIDE ADA SIDEWALK VARIOUS LOCATIONS WITHIN 7 MUNICIPALITIES

RECORD PLANS	
CONTRACTOR:	ENGINEERS CONSTR., INC. - SO. BURLINGTON, VT
RESIDENT ENGINEER:	MIKE BOOTH
CONSTRUCTION BEGAN:	APRIL 18, 2014
CONSTRUCTION COMPLETE:	SEPTEMBER 22, 2014
RECORD PLANS BY:	MIKE BOOTH & CHIP PIERCE
I HEREBY CERTIFY THAT ALL THE CONSTRUCTION REQUIRED BY THIS SET OF DRAWINGS HAS BEEN ACCOMPLISHED AS INDICATED HEREIN.	
BY	 RESIDENT ENGINEER
DATE	4-15-16
NOTE: Any further information concerning final quantities, amounts or other details relative to this project may be found at Central Files in the electronic archives.	



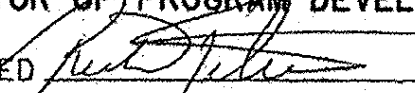
VARIOUS SITES LOCATED THROUGHOUT THE STATE OF VERMONT WITHIN 7 MUNICIPALITIES. THE MUNICIPALITIES INCLUDE BRADFORD, BRISTOL, BURLINGTON, MONTPELIER, VILLAGE OF MORRISVILLE, RANDOLPH AND RUTLAND.

THIS PROJECT INCLUDES SIDEWALK IMPROVEMENTS TO MEET THE REQUIREMENTS OF THE AMERICANS WITH DISABILITIES ACT 2010 STANDARDS FOR ACCESSIBLE DESIGN. IMPROVEMENTS INCLUDE SIDEWALK RECONSTRUCTION, HANDICAP RAMP RECONSTRUCTION, CURBING, PAVEMENT MARKINGS, INSTALLATION OF NEW SIGNS, AND PEDESTRIAN SIGNAL UPGRADES.



THESE PLANS ARE SUBJECT TO SUCH ENGINEERING CHANGES AS MAY BE REQUIRED BY THE FEDERAL HIGHWAY ADMINISTRATION OR THE DIRECTOR OF PROGRAM DEVELOPMENT.
CONSTRUCTION IS TO BE CARRIED ON IN ACCORDANCE WITH THESE PLANS AND THE STANDARD SPECIFICATIONS FOR CONSTRUCTION DATED 2011, AS APPROVED BY THE FEDERAL HIGHWAY ADMINISTRATION ON JULY 20, 2011 FOR USE ON THIS PROJECT, INCLUDING ALL SUBSEQUENT REVISIONS AND SUCH REVISED SPECIFICATIONS AND SPECIAL PROVISIONS AS ARE INCORPORATED IN THESE PLANS.

QUALITY ASSURANCE PROGRAM :	LEVEL 3
SURVEYED BY :	VERMONT SURVEY AND ENGINEERING
SURVEYED DATE :	MAY-DECEMBER 2012
DATUM	
VERTICAL	NAVD 88 (GEO1009) FT
HORIZONTAL	NAD 83 (CORS) 8FT

 	DIRECTOR OF PROGRAM DEVELOPMENT
	APPROVED  DATE 10-8-13
	PROJECT MANAGER : JONATHAN KAPLAN, P.E.
	PROJECT NAME : STATEWIDE PROJECT NUMBER : STP SDWK(II)
SHEET 1 OF 53 SHEETS	