


REMOVAL OF EXISTING SIDEWALK (SOLID ROCK EXCAVATION)	PORTLAND CEMENT CONCRETE SIDEWALK, 5 INCH	SEED
SITE 1 - WEST STREET - 78.89 SY	SITE 1 - WEST STREET - 47.70 SY	SITE 1 - WEST STREET AND SCHOOL STREET - 80 SY
SITE 1 - SCHOOL STREET - 39.42 SY	SITE 1 - SCHOOL STREET - 27.21 SY	
SITE 2 - WEST STREET - 102.73 SY	SITE 2 - WEST STREET - 88.33 SY	
BITUMINOUS CONCRETE PAVEMENT	5 INCH SIDEWALK RAMPS WITH DETECTABLE WARNING SURFACE	SPECIAL PROVISION (INLET PROTECTION, GEOTEXTILE FABRIC)
SITE 1 - SCHOOL STREET - 5.43 SY	SITE 1 - WEST STREET - 34 SF (TYPE 2)	SITE 1 - WEST STREET - 2 EACH
CHANGING ELEVATION OF DROP INLETS, CATCH BASINS, MANHOLES	SITE 1 - SCHOOL STREET - 20 SF (TYPE 1)	SITE 1 - SCHOOL STREET - 1 EACH
SITE 2 - WEST STREET - 1 EACH	SITE 2 - WEST STREET - 13 SF (TYPE 2)	SITE 2 - WEST STREET - 1 EACH
VERTICAL GRANITE CURB	SITE 2 - WEST STREET - 10 SF (TYPE 5)	
SITE 2 - WEST STREET - 86 LF	DURABLE 4 INCH WHITE LINE	SPECIAL PROVISION (CONCRETE STEPS WITH HANDRAIL EXTENSIONS)
PRECAST REINFORCED CONCRETE CURB, TYPE B	SITE 1 - WEST STREET - 79.6 FT (GORE)	SITE 2 - WEST STREET - 1 EACH
SITE 1 - WEST STREET - 57 LF	SITE 2 - WEST STREET - 197.6 FT (GORE)	SPECIAL PROVISION (REMOVE AND RESET BRICK PAVERS)
SITE 1 - SCHOOL STREET - 27 LF	SITE 2 - WEST STREET - 28.0 FT (PARKING)	SITE 2 - WEST STREET - 96 SF
REMOVAL OF EXISTING CURB	DURABLE 24 INCH STOP BAR	
SITE 2 - WEST STREET - 61 LF	SITE 1 - SCHOOL STREET - 20 LF	REMOVAL OF EXISTING PAVEMENT MARKINGS
	REMOVAL OF EXISTING PAVEMENT MARKINGS	SITE 2 - WEST STREET - 12 SF
	SITE 2 - WEST STREET - 12 SF	

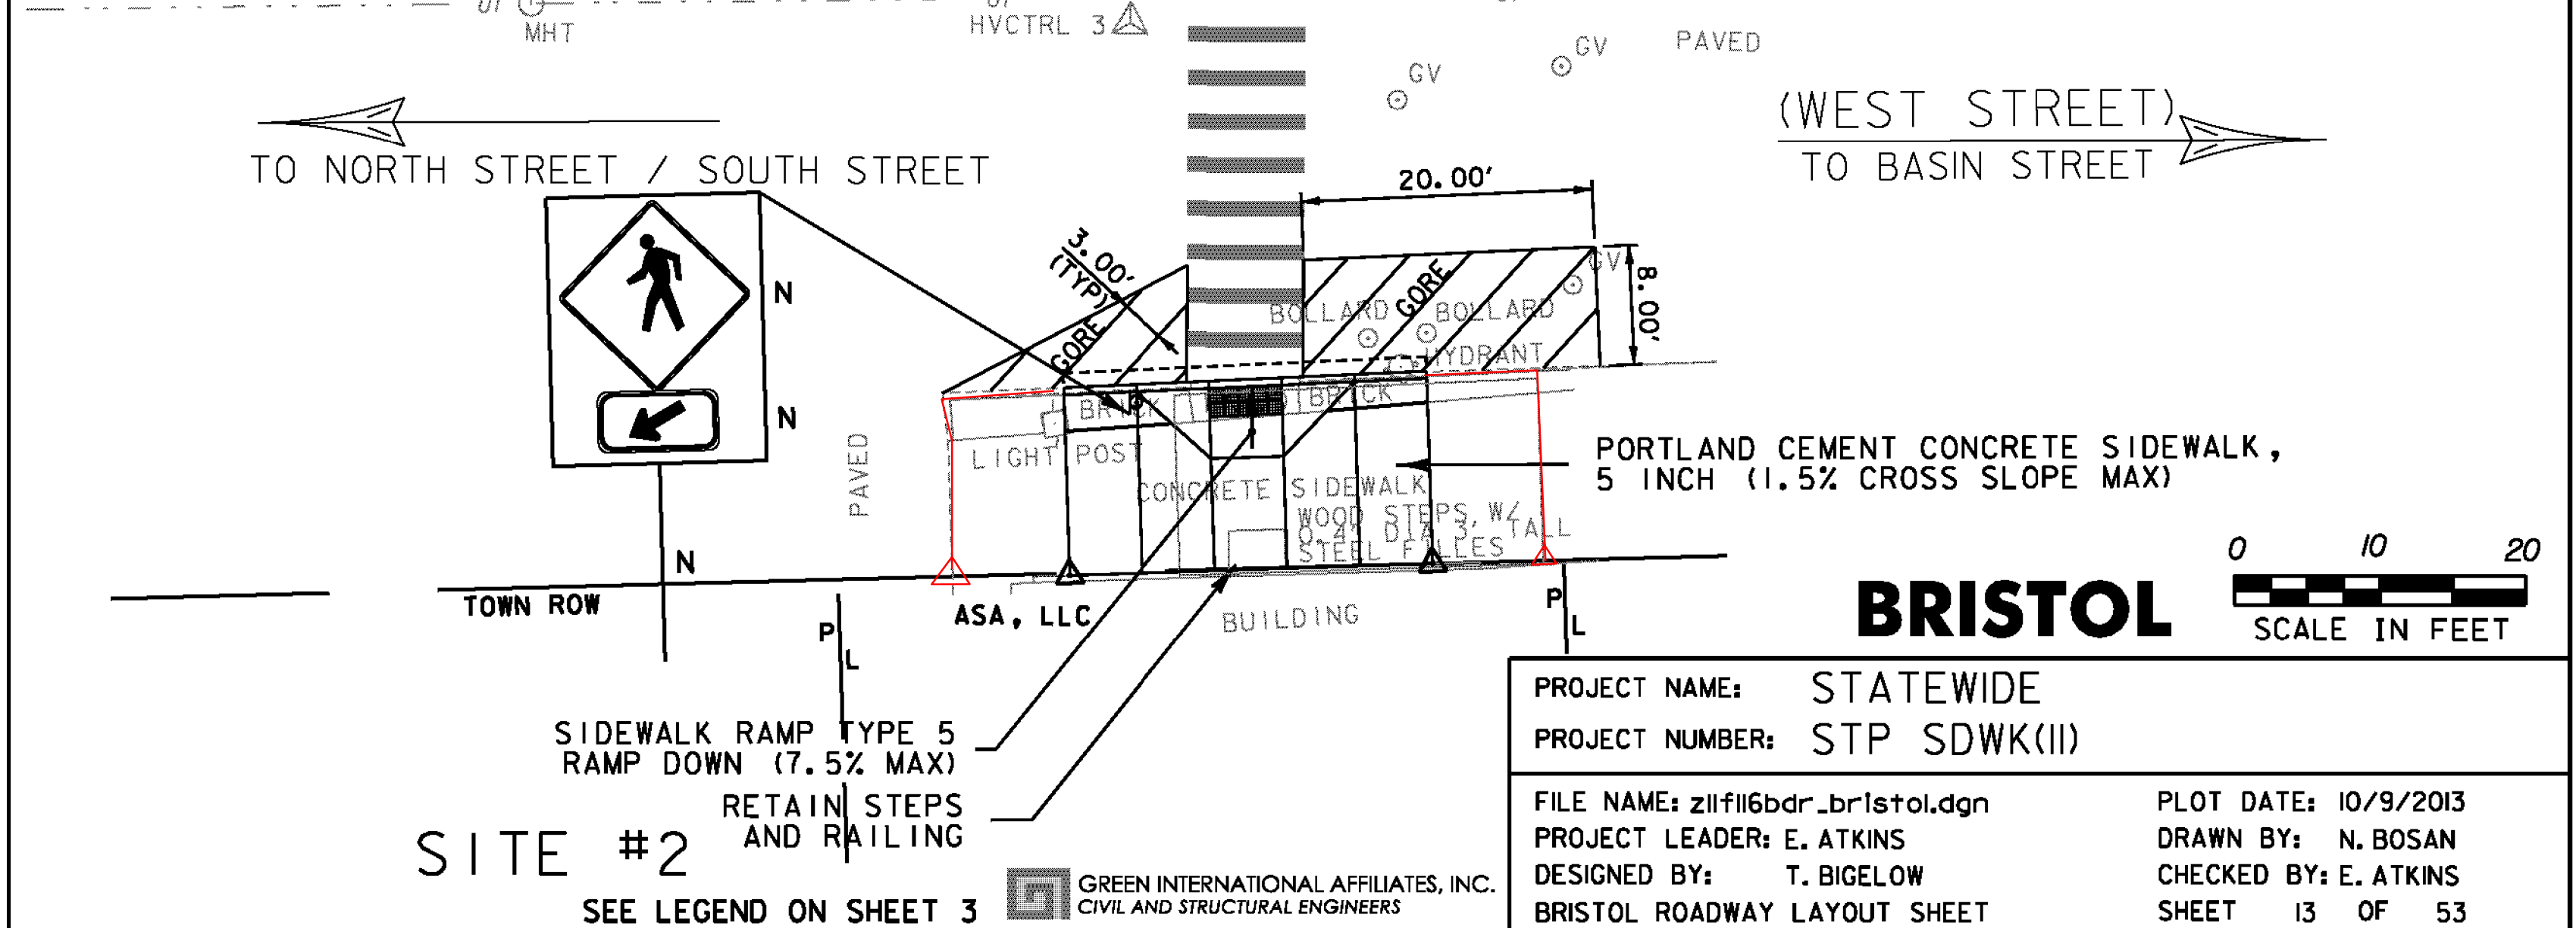

PROJECT NAME:	STATEWIDE
PROJECT NUMBER:	STP SDWK(II)
FILE NAME:	zlf116bdr_br1stol.dgn
PROJECT LEADER:	E. ATKINS
DESIGNED BY:	T. BIGELOW
BRISTOL ROADWAY LAYOUT SHEET	
PLOT DATE:	10/9/2013
DRAWN BY:	N. BOSAN
CHECKED BY:	E. ATKINS
SHEET	13 OF 53

GREEN INTERNATIONAL AFFILIATES, INC.
CIVIL AND STRUCTURAL ENGINEERS