


SITE #7

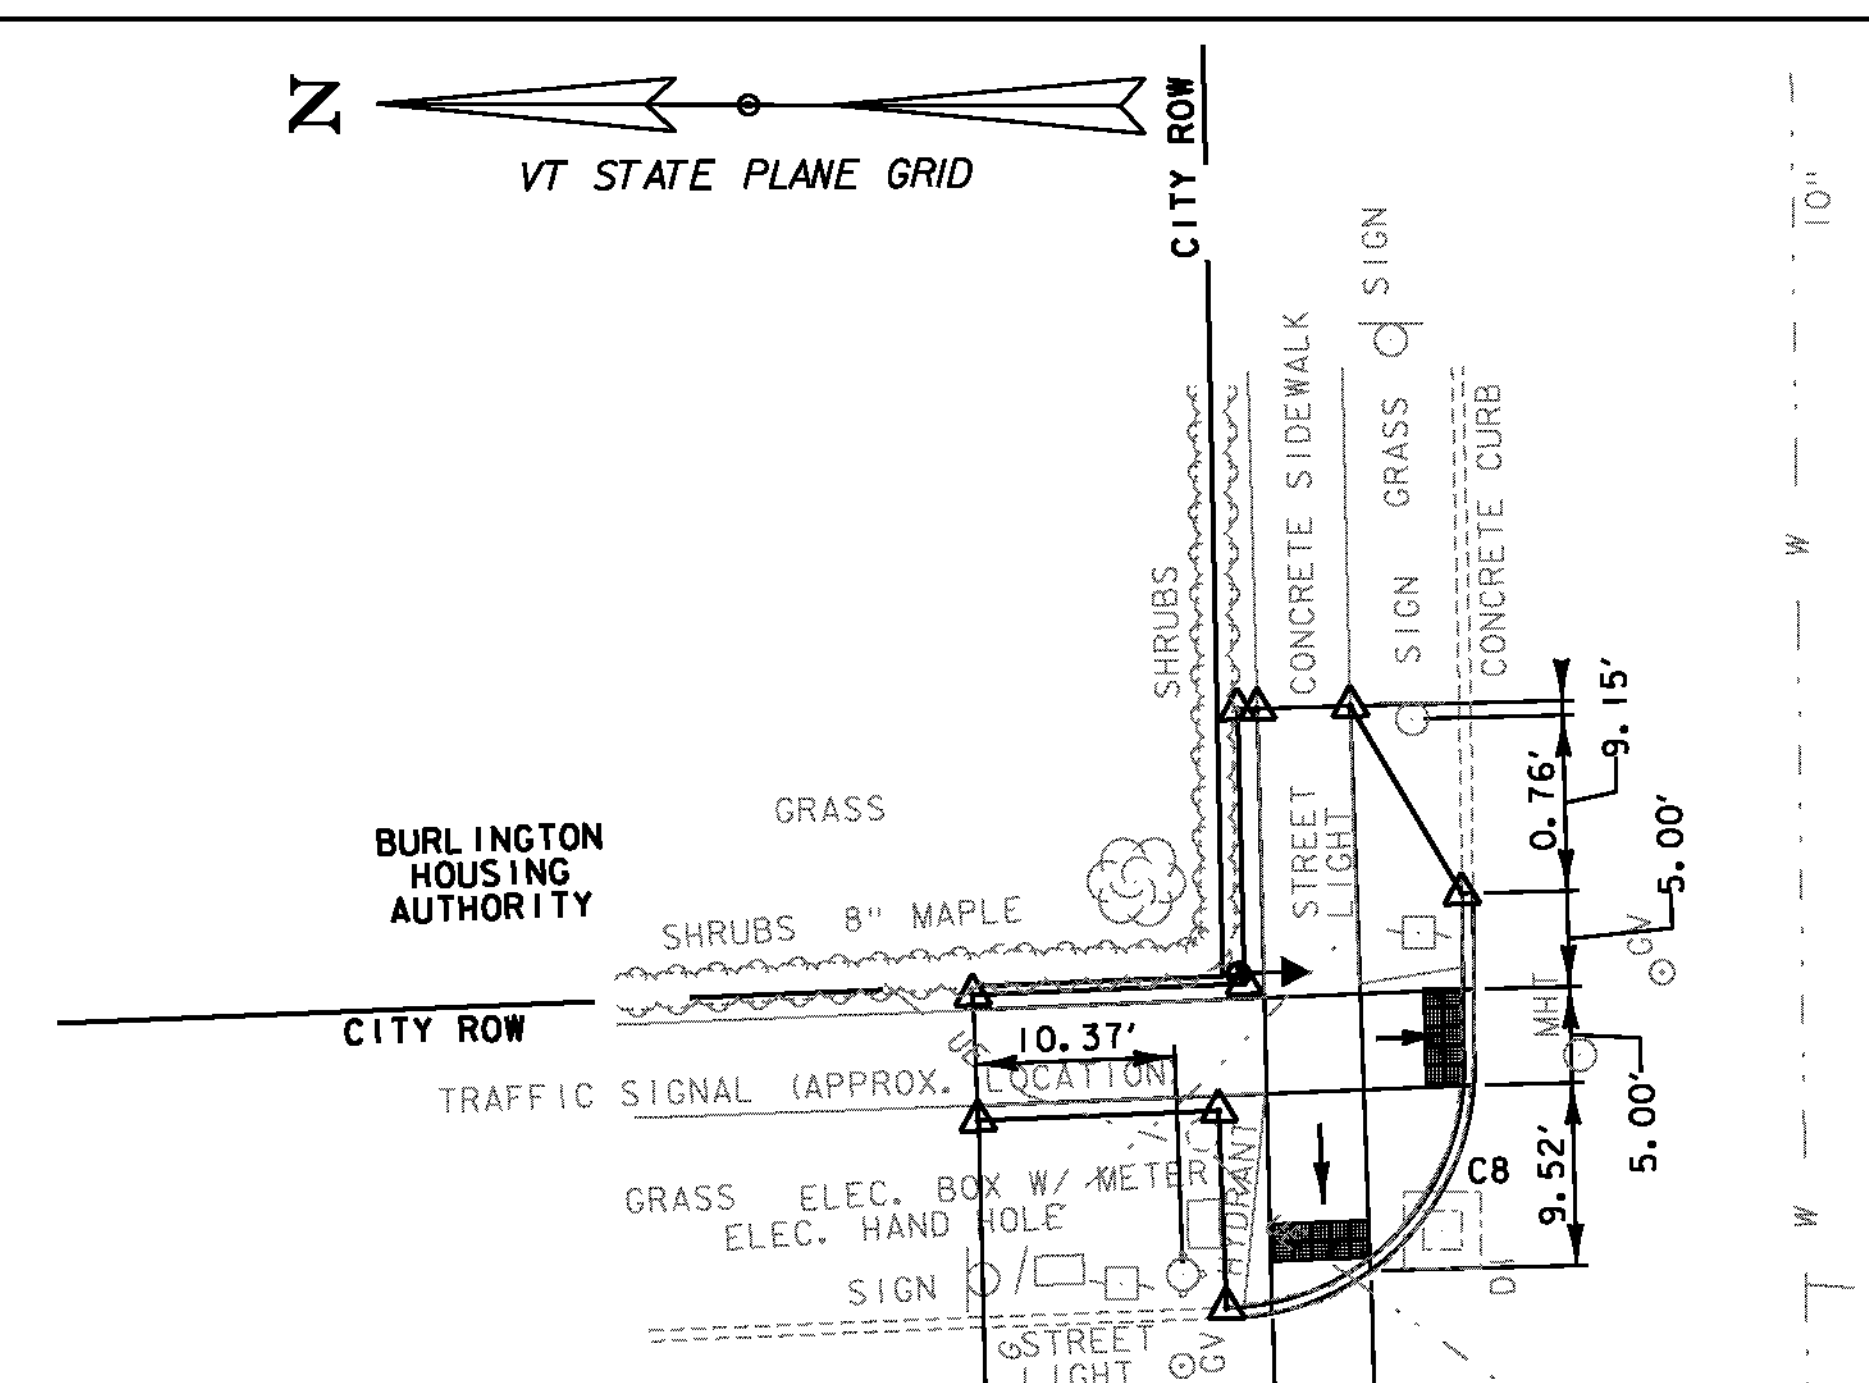


CURVE TABLE


LABEL	RADIUS (ft)	LENGTH (ft)
C8	13.00	21.09
C9	12.00	19.44

N. CHAMPLAIN STREET
CLASS 3 TOWN HIGHWAY

SITE #6

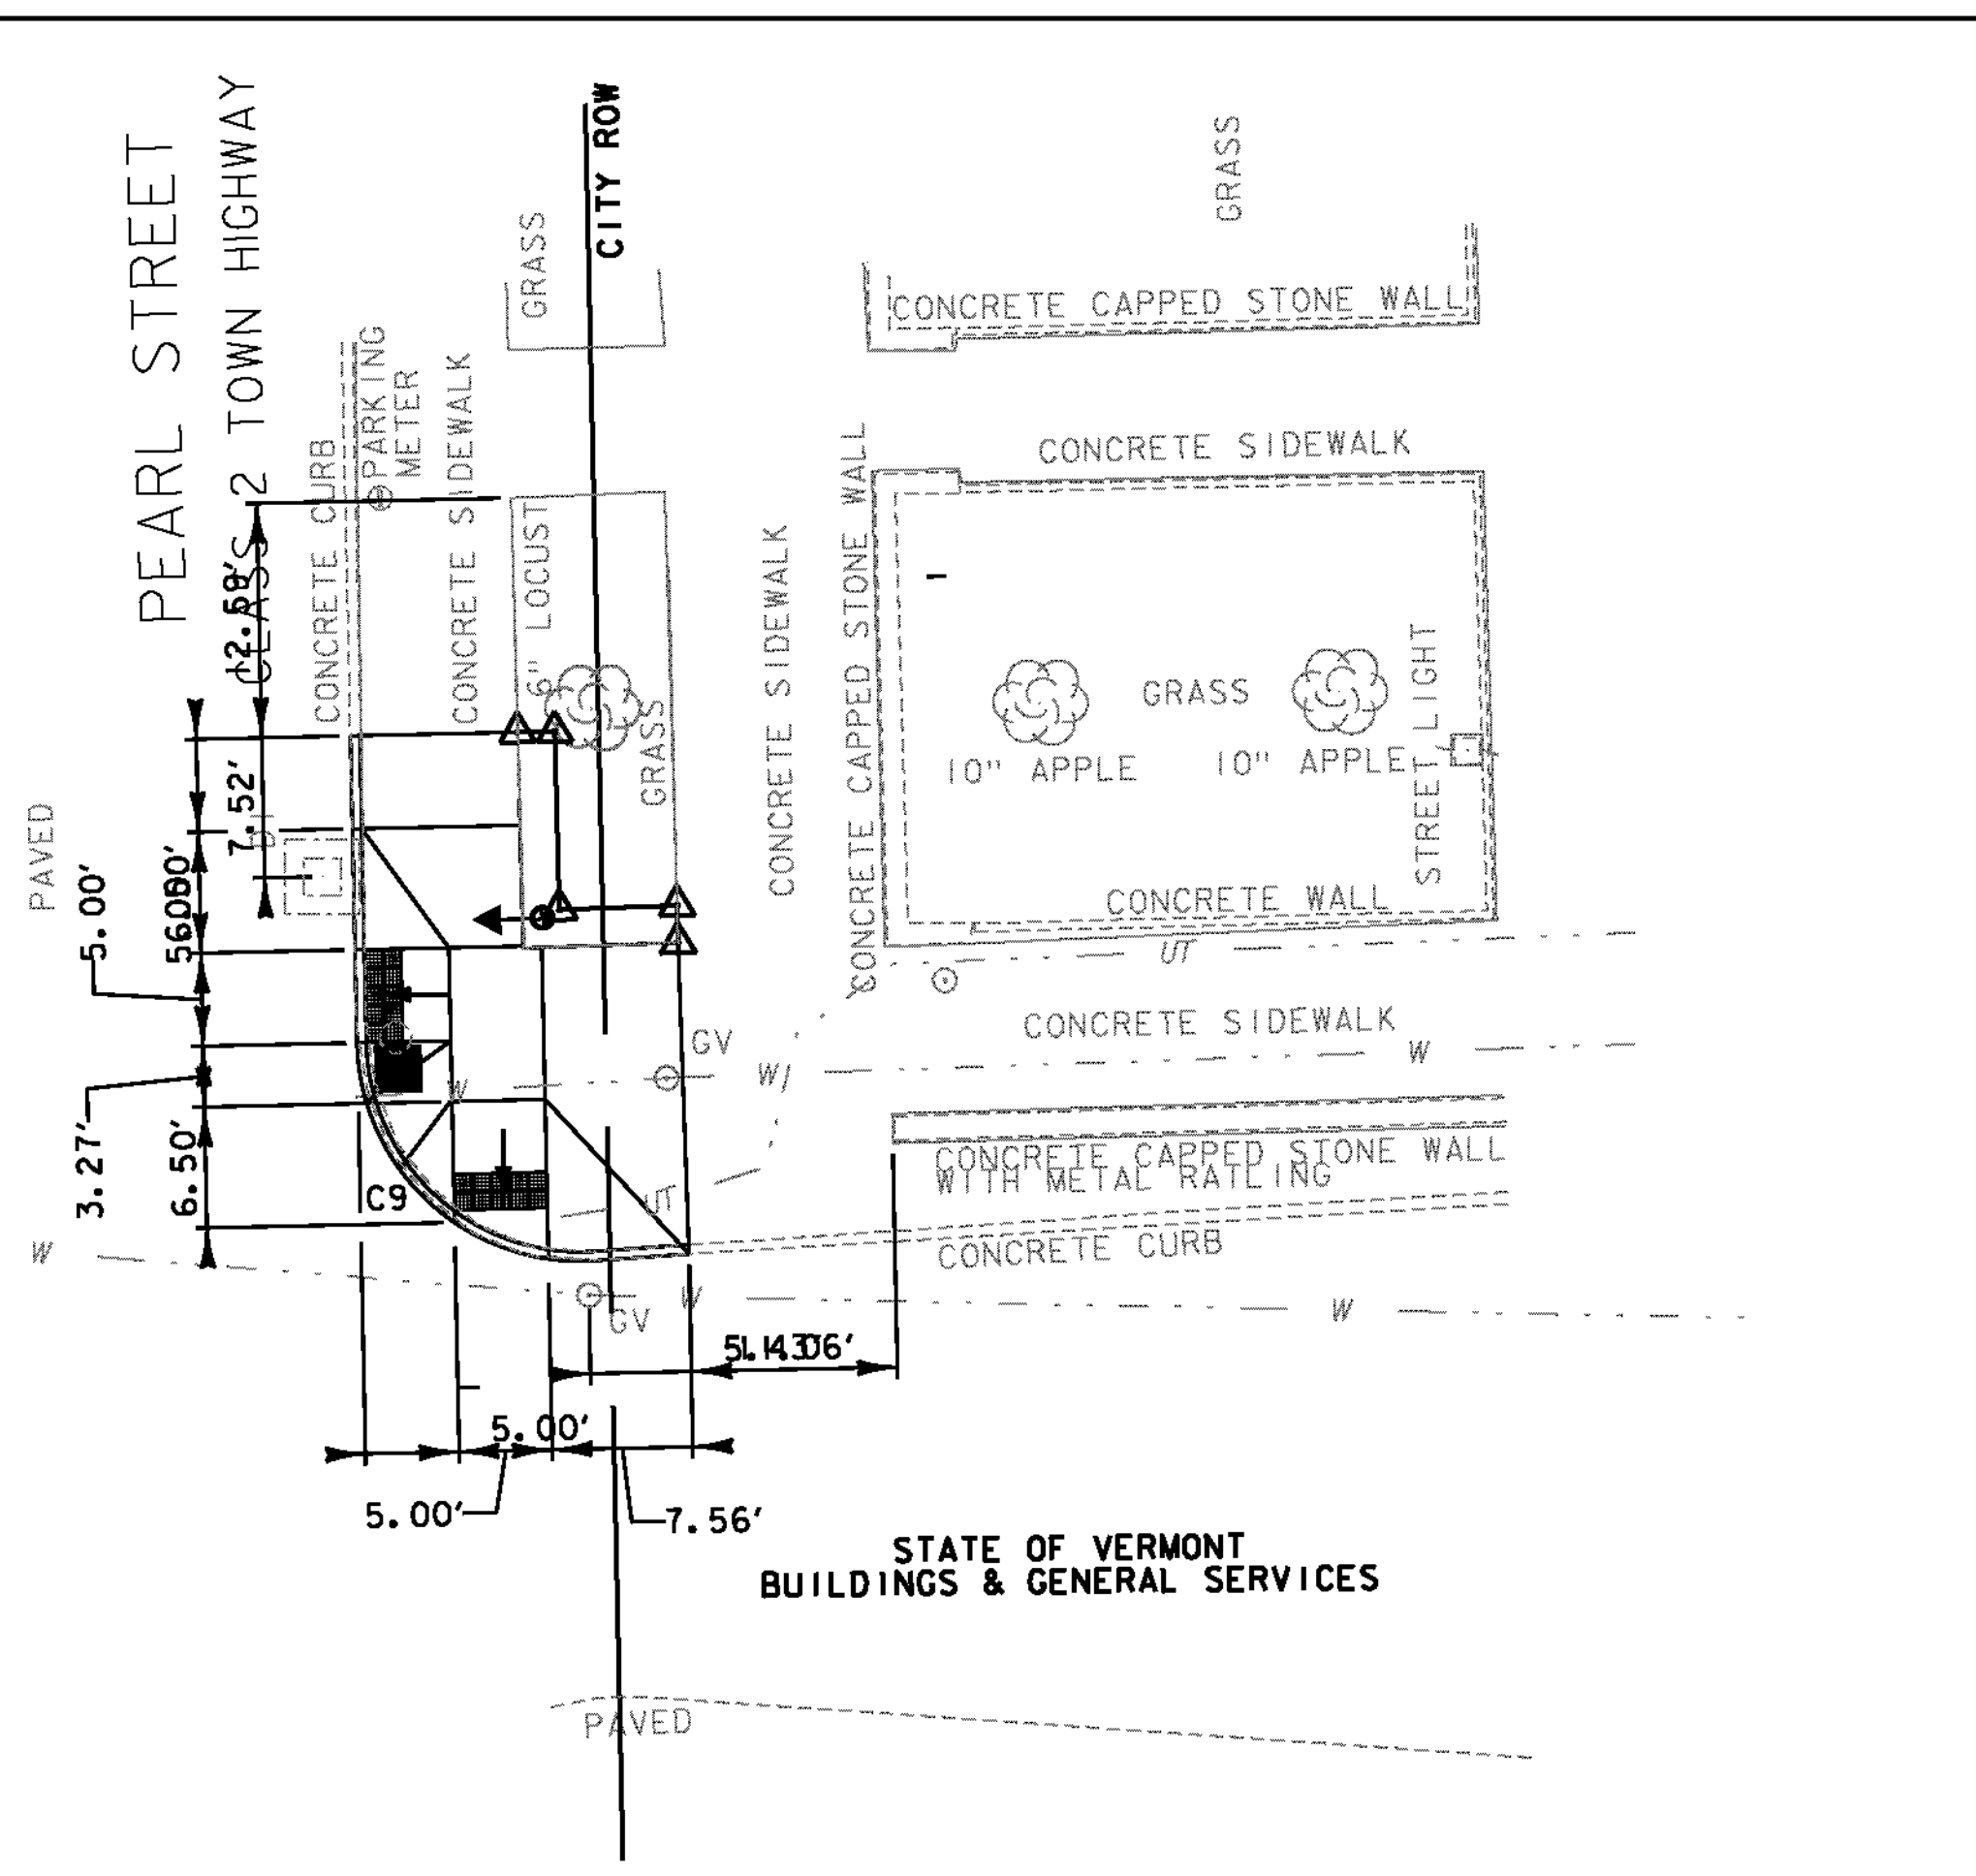

SITE #8

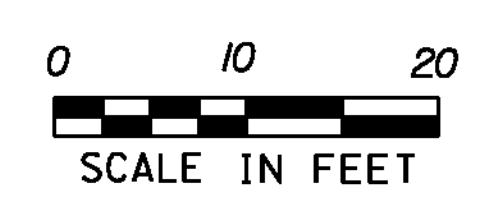

BURLINGTON

PROJECT NAME: STATEWIDE
 PROJECT NUMBER: STP SDWK(II)
 FILE NAME: z1f1i6curbldr_burlington.dgn PLOT DATE: 10/9/2013
 PROJECT LEADER: E. ATKINS DRAWN BY: A. SWEETMAN
 DESIGNED BY: T. BIGELOW CHECKED BY: E. ATKINS
 BURLINGTON CURB TIE & GRADING SHEET 3 SHEET 21 OF 53