


- EXISTING DRAINAGE**
- COURT ST 5+80.0 - 5+37.6 LT  
EXISTING 18" RCP - RETAIN
  - COURT ST 5+37.6 LT - ELM ST 1+28.2 LT  
EXISTING 24" CMP - RETAIN
  - ELM ST 1+28.2 LT - ELM ST 1+58.9 RT  
EXISTING 24" RCP - RETAIN
  - ELM ST 1+28.7 RT - ELM ST 1+58.9 RT  
EXISTING 12" RCP - RETAIN
  - ELM ST 1+90.9 LT - ELM ST 1+58.9 RT  
EXISTING 12" RCP - RETAIN
  - ELM ST 2+02.2 RT - ELM ST 1+74.7 RT  
EXISTING 12" RCP - RETAIN
  - ELM ST 1+58.9 RT - SCHOOL ST 10+61.5 LT  
EXISTING 30" RCP - RETAIN
- NEW DRAINAGE**
- ELM ST 1+28.2 LT - 1+31.5 LT  
•NEW 24" X 4" PCCSP .064 (2-2/3 X 1/2)  
W/ NEW CB @ ELM ST 1+28.2 LT
  - ELM ST 1+28.2 LT - 1+34.0 LT  
•NEW 24" X 4" PCCSP .064 (2-2/3 X 1/2)  
CONNECT TO NEW CB @ ELM STREET 1+28.2 LT
  - ELM ST 1+92.6 LT  
NEW 4" CB  
CONNECT TO EXISTING PIPES
  - ELM ST 1+74.7 RT - 1+58.9 RT  
EXISTING 12" RCP - RETAIN  
CONVERT CB TO MANHOLE

NOTE: PRIOR TO ORDERING THE NEW PIPE, CONTRACTOR SHALL FIELD VERIFY EXISTING PIPE MATERIAL. THE CONTRACTOR SHALL VERIFY WITH THE ENGINEER THAT NEW PIPE MATERIAL AND EXISTING PIPE MATERIAL WILL NOT CONFLICT.

- REMOVAL OF EXISTING SIDEWALK (SOLID ROCK EXCAVATION)**  
ELM ST 0+25.0 0+63JRT  
ELM ST 1+21.0 RT - SCHOOL ST 10+61.2 RT  
SCHOOL ST 10+42.8 LT - ELM ST 1+90JRT  
ELM ST 2+04JLT - COURT ST 5+55JRT  
COURT ST 5+52.3 LT - ELM ST 1+16.7 LT
- COLD PLANING, BITUMINOUS PAVEMENT**  
SCHOOL ST 10+35.7 RT - ELM ST 1+90.3 RT
- BITUMINOUS CONCRETE PAVEMENT**  
ELM ST 0+21.4 - 0+63JRT
- PRECAST REINFORCED CATCH BASIN WITH CAST IRON GRATE**  
ELM STREET - 1+27.6 LT  
ELM STREET - 1+93.2 LT
- REHAB DROP INLETS, CATCH BASINS, OR MANHOLES, CLASS 1**  
ELM STREET - 1+75.3 RT
- CAST IRON COVER WITH FRAME**  
ELM STREET - 1+75.3 RT
- VERTICAL GRANITE CURB**  
SCHOOL ST 10+42.8 LT - ELM ST 1+90JRT  
ELM ST 2+04JLT - COURT ST 5+16.5 RT  
COURT ST 5+34.7 RT - 5+54.5 RT  
COURT ST 5+51.2 LT - ELM ST 1+16.7 LT
- REMOVING AND RESETTING CURB**  
ELM STREET 0+25.0 - 0+63JRT  
ELM ST 1+21.0 RT - SCHOOL ST 10+61.2 RT
- REMOVAL OF EXISTING CURB**  
SCHOOL ST 10+42.8 LT - ELM ST 1+90JRT  
ELM ST 2+04JLT - COURT ST 5+16.5 RT  
COURT ST 5+34.7 - 5+54.5 RT  
COURT ST 5+51.2 LT - ELM ST 1+16.7 LT
- PORTLAND CEMENT CONCRETE SIDEWALK, 5 INCH**  
ELM ST 0+25.0 RT - SCHOOL ST 10+61.2 RT  
SCHOOL ST 10+42.8 LT - ELM ST 1+90JRT  
ELM ST 2+04JLT - COURT ST 5+53.4 RT  
COURT ST 5+52.3 LT - ELM ST 1+16.7 LT
- DURABLE 4 INCH WHITE LINE**  
ELM ST - 1+38.6 RT (TYPE 6)  
ELM ST - 1+73.5 RT (TYPE 6)  
ELM ST - 1+86.7 LT (TYPE 6)  
ELM ST - 1+35.7 LT (TYPE 6)
- DURABLE 24 INCH STOP BAR**  
ELM ST - 0+26.7 RT (8 FT)  
ELM ST - 0+47.7 RT (8 FT)
- DURABLE CROSSWALK MARKING**  
ELM ST - 1+37.3  
COURT ST - 5+34J  
ELM ST - 1+79.8  
SCHOOL ST - 10+20.9

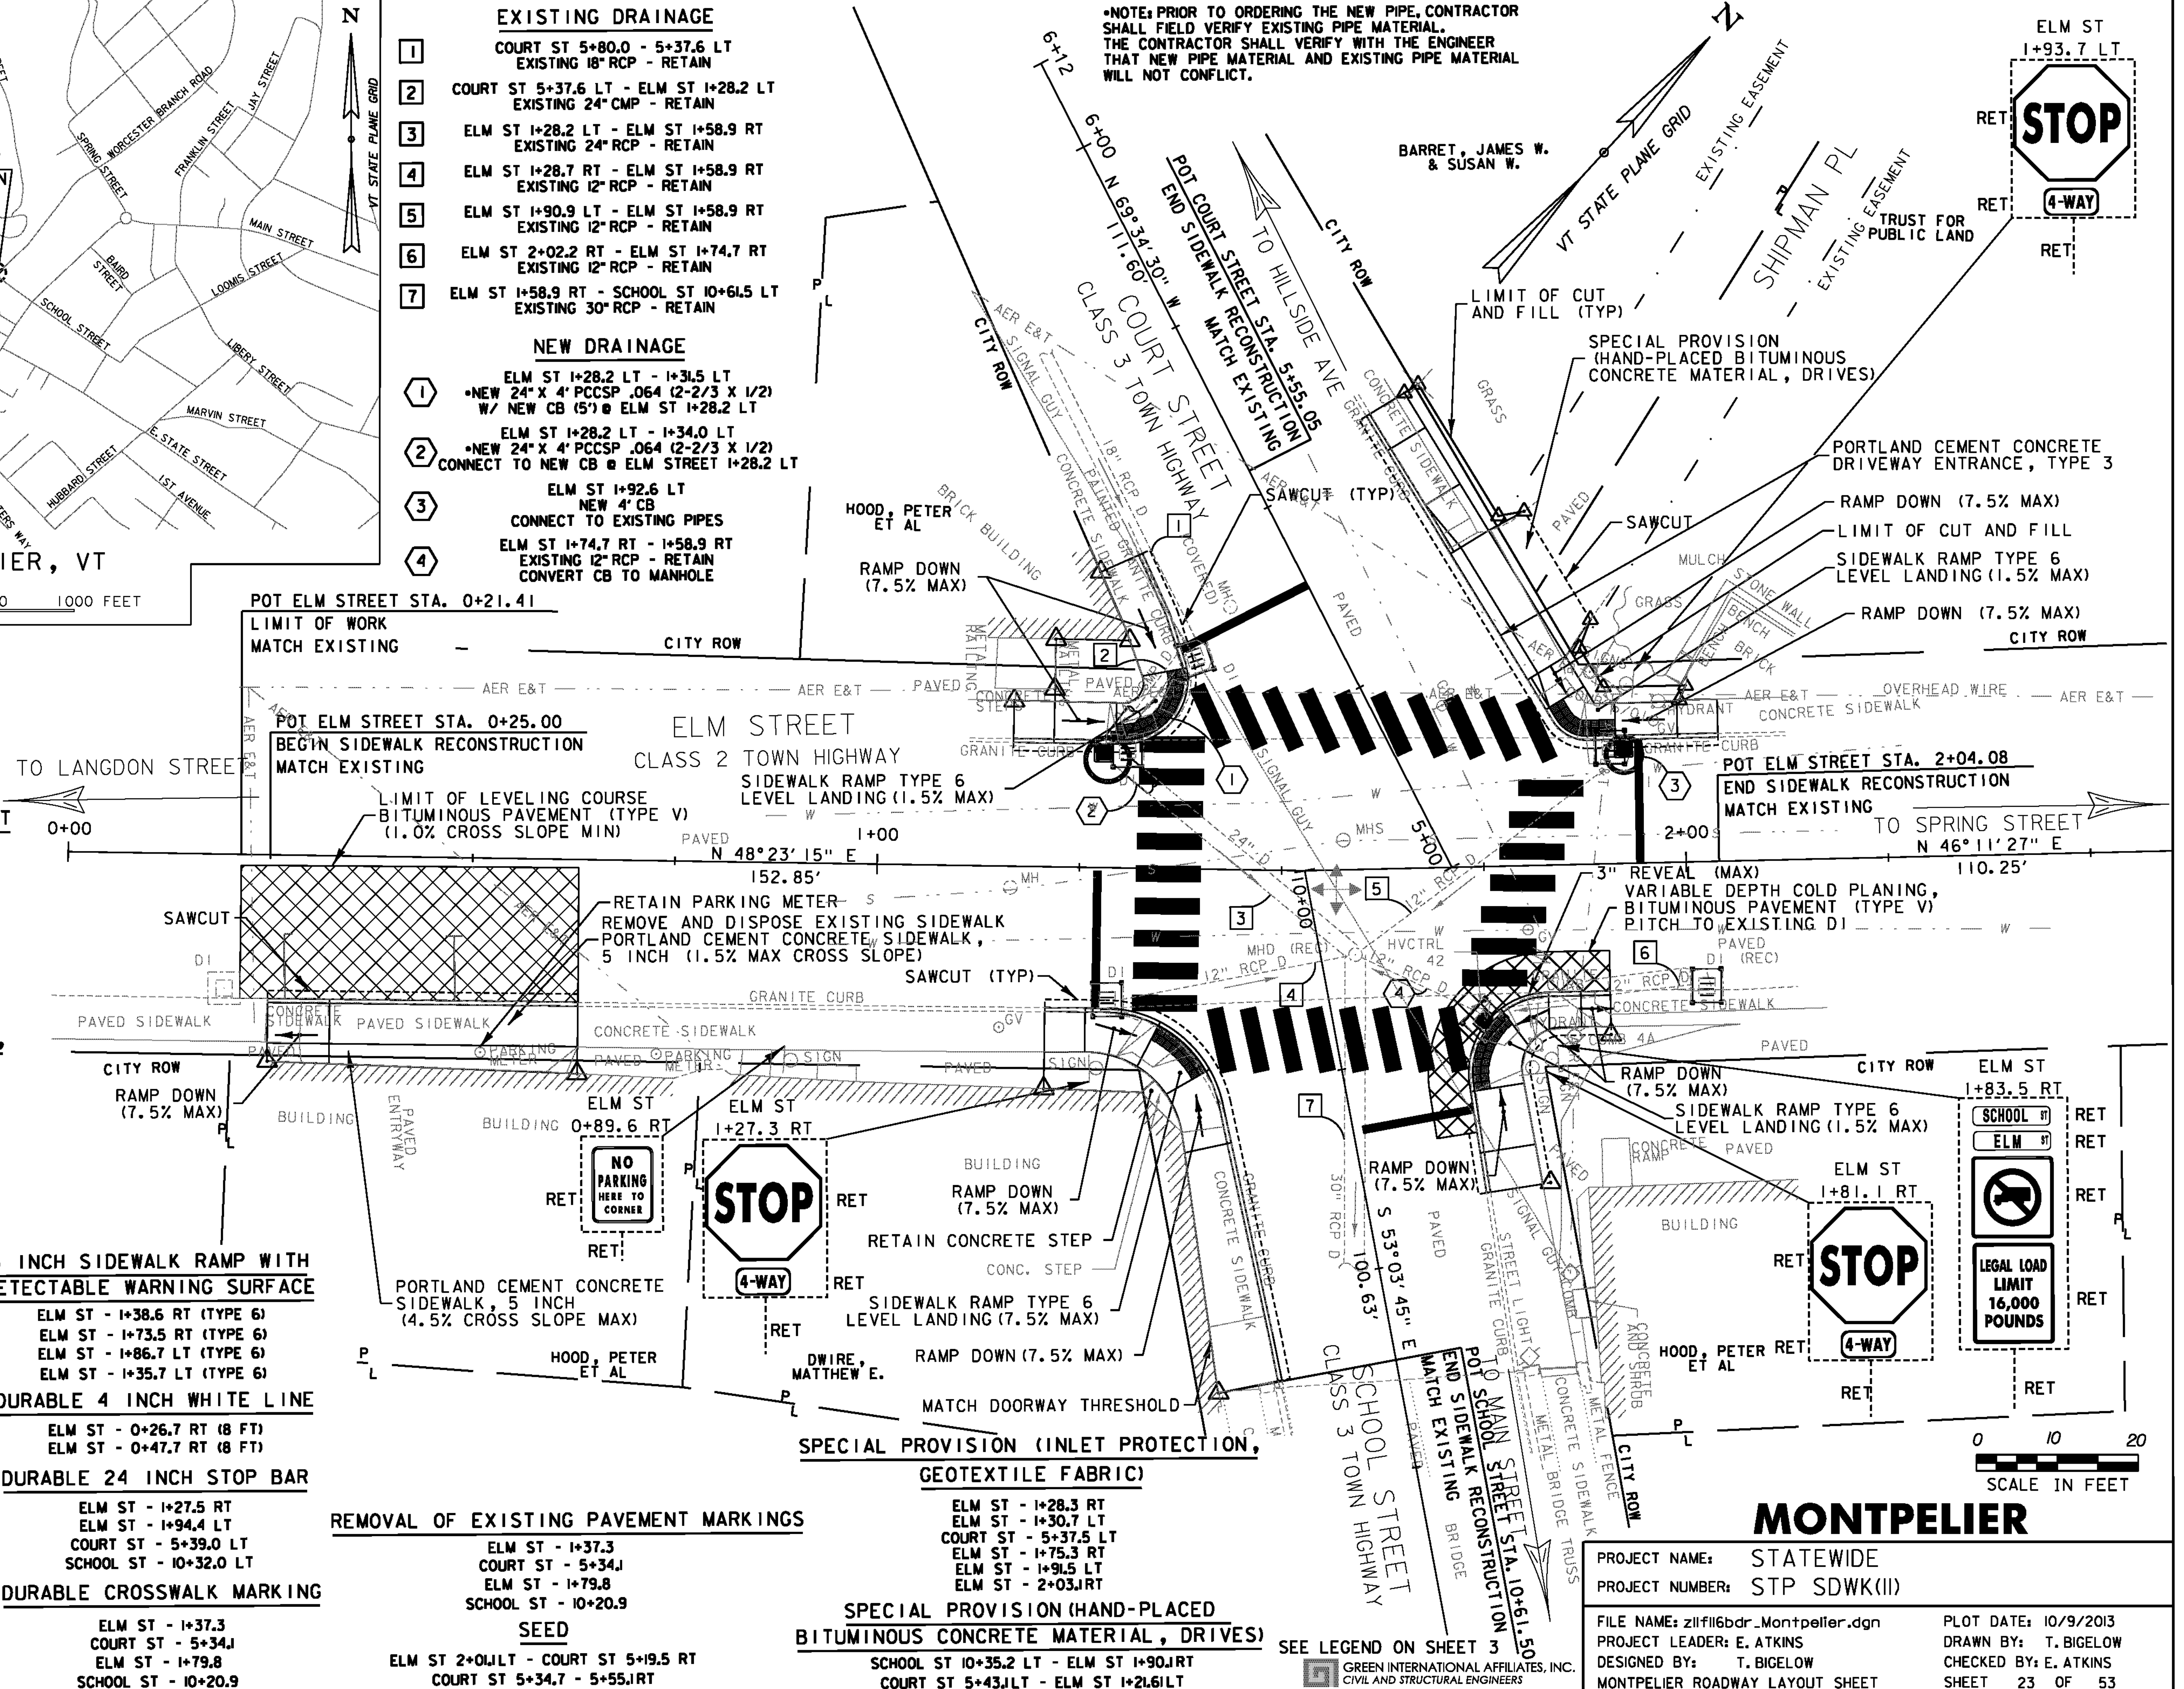

**MONTPELIER**

PROJECT NAME: STATEWIDE  
PROJECT NUMBER: STP SDWK(III)

FILE NAME: z1f116bdr\_Montpelier.dgn  
PROJECT LEADER: E. ATKINS  
DESIGNED BY: T. BIGELOW  
MONTPELIER ROADWAY LAYOUT SHEET

PLOT DATE: 10/9/2013  
DRAWN BY: T. BIGELOW  
CHECKED BY: E. ATKINS  
SHEET 23 OF 53

SEE LEGEND ON SHEET 3  
GREEN INTERNATIONAL AFFILIATES, INC.  
CIVIL AND STRUCTURAL ENGINEERS