


**CURVE TABLE**

LABEL	RADIUS (ft)	LENGTH (ft)
C10	15.00	20.19
C11	10.00	17.06
C12	5.00	5.23
C13	8.00	15.20

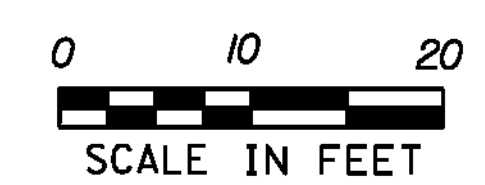

**MONTPELIER**

PROJECT NAME: STATEWIDE  
 PROJECT NUMBER: STP SDWK(II)  
 FILE NAME: zlf116curbbdr\_Montpelier.dgn  
 PROJECT LEADER: E. ATKINS  
 DESIGNED BY: T. BIGELOW  
 MONTPELIER CURB TIE & GRADING SHEET  
 PLOT DATE: 10/9/2013  
 DRAWN BY: A. SWEETMAN  
 CHECKED BY: E. ATKINS  
 SHEET 24 OF 53