



**REMOVAL OF EXISTING SIDEWALK
(SOLID ROCK EXCAVATION)**
PARK STREET 2+50.0 - 6+71.0 LT

AGGREGATE SHOULDERS
PARK STREET 2+48.0 - 2+74.0 LT
PARK STREET 5+62.0 - 5+80.1 LT
PARK STREET 6+26.1 - 6+65.3 LT

**PORTLAND CEMENT CONCRETE
SIDEWALK, 5 INCH**
PARK STREET 2+50.0 - 2+73.1 LT
PARK STREET 2+73.1 - 4+07.5 LT
PARK STREET 4+07.5 - 4+33.3 LT
PARK STREET - 4+33.3 - 4+95.9 LT
PARK STREET 4+95.9 - 5+17.2 LT
PARK STREET 5+17.2 - 5+62.7 LT
PARK STREET 5+62.7 - 5+82.5 LT
PARK STREET 5+82.5 - 6+30.6 LT
PARK STREET 6+30.6 - 6+62.8 LT
PARK STREET 6+62.8 - 6+71.0 LT

SEED
PARK STREET 2+68.1 - 4+12.6 LT
PARK STREET 2+68.1 - 4+12.6 LT
PARK STREET 4+28.3 - 5+00.9 LT
PARK STREET 4+28.3 - 5+00.9 LT
PARK STREET 5+12.2 - 5+67.7 LT
PARK STREET 5+12.2 - 5+67.9 LT
PARK STREET 5+76.6 - 6+31.8 LT
PARK STREET 5+77.5 - 6+35.6 LT
PARK STREET 6+57.8 - 6+71.0 LT
PARK STREET 6+57.8 - 6+71.0 LT

REMOVING SIGNS
PARK STREET - 5+53.4 LT
**SPECIAL PROVISION (HAND-PLACED
BITUMINOUS CONCRETE MATERIAL, DRIVES)**
PARK STREET 2+50.0 - 2+68.1 LT
PARK STREET 4+12.6 - 4+28.3 LT
PARK STREET 4+51.7 - 4+55.8 LT
PARK STREET 4+81.3 - 4+85.6 LT
PARK STREET 5+00.9 - 5+12.2 LT
PARK STREET 5+67.9 - 5+77.5 LT
PARK STREET 6+35.6 - 6+57.8 LT
PARK STREET 6+62.1 - 6+65.8 LT

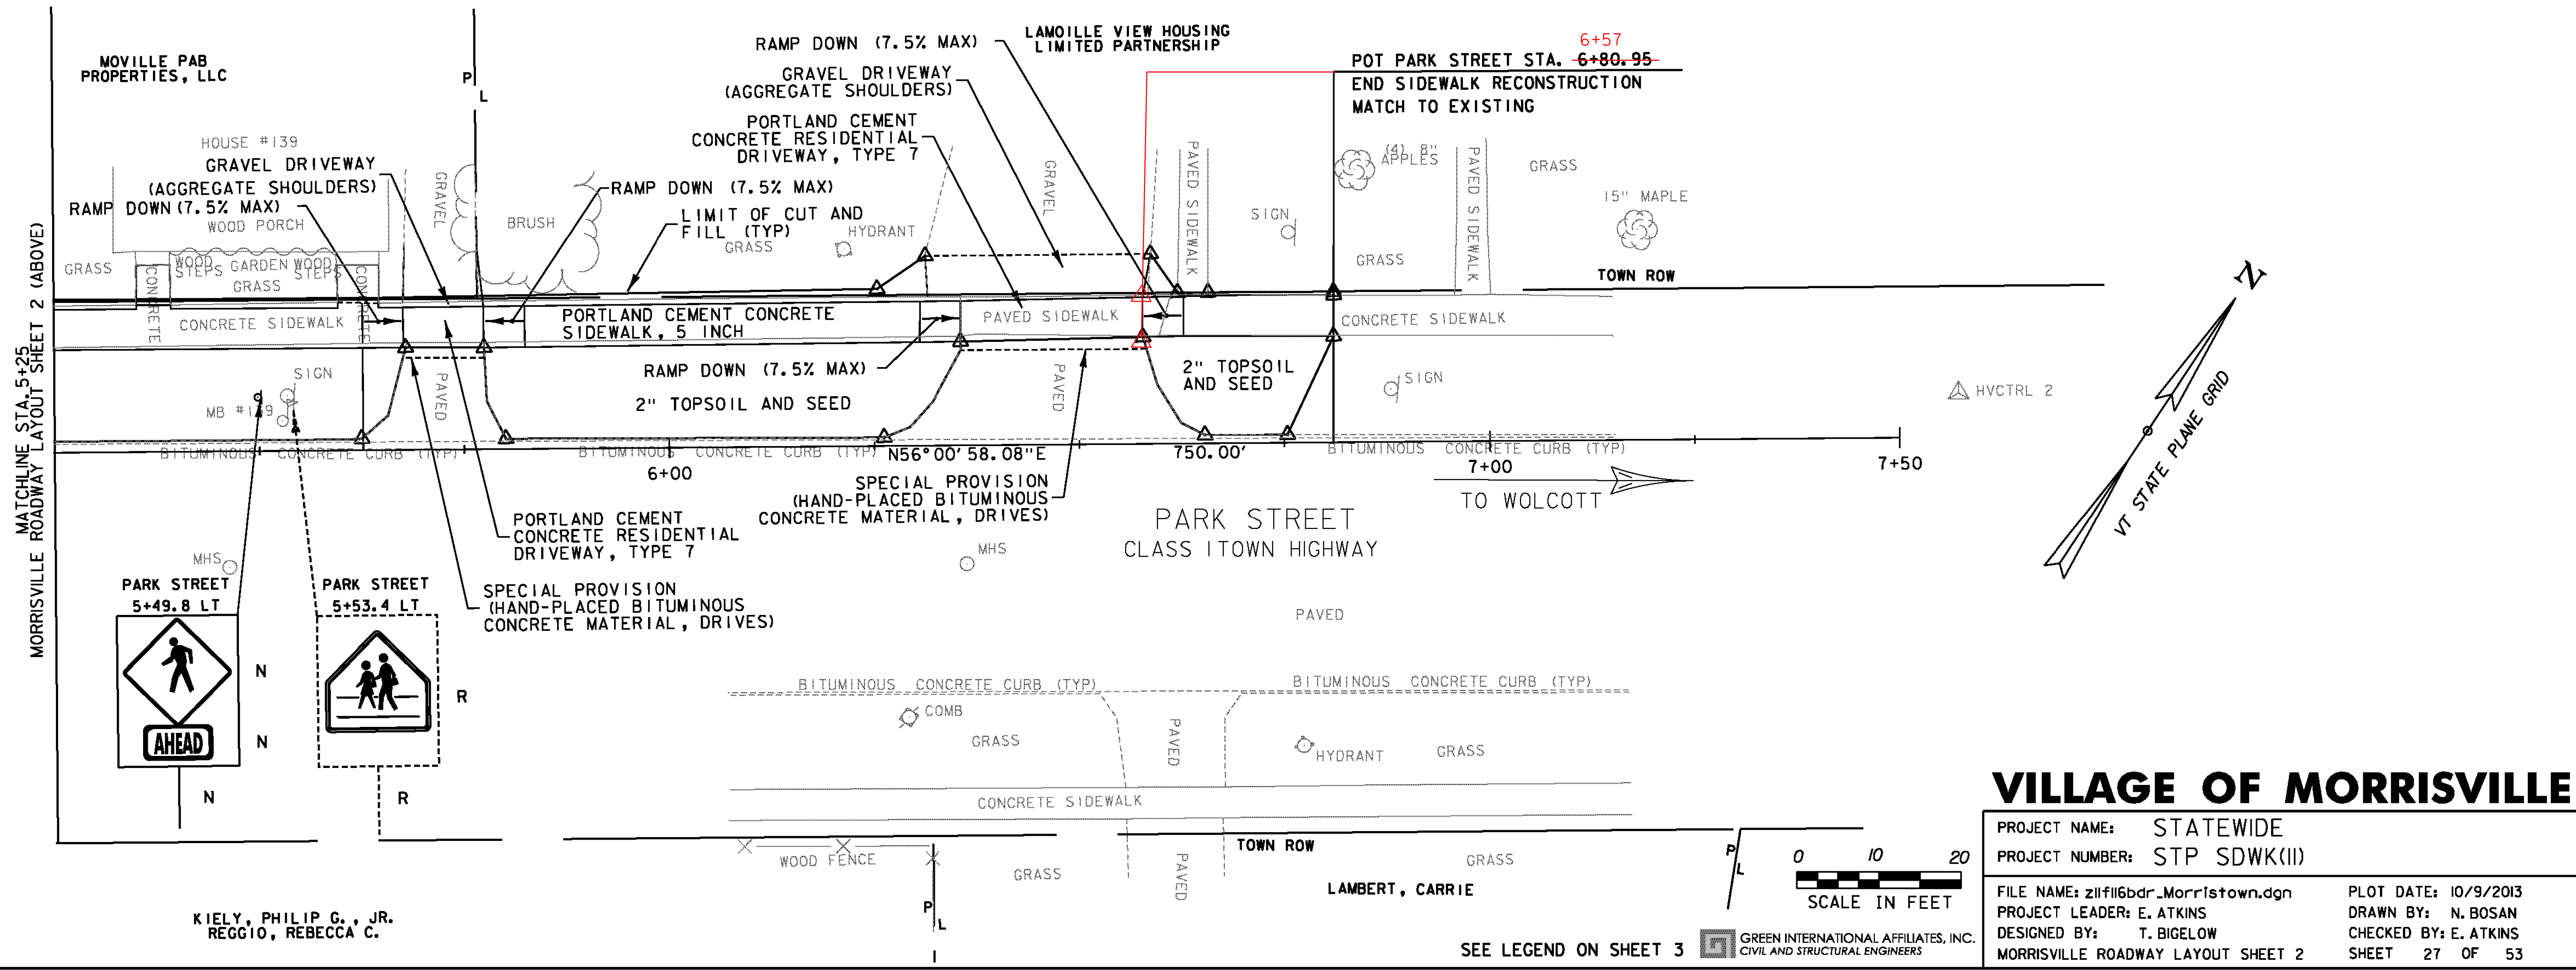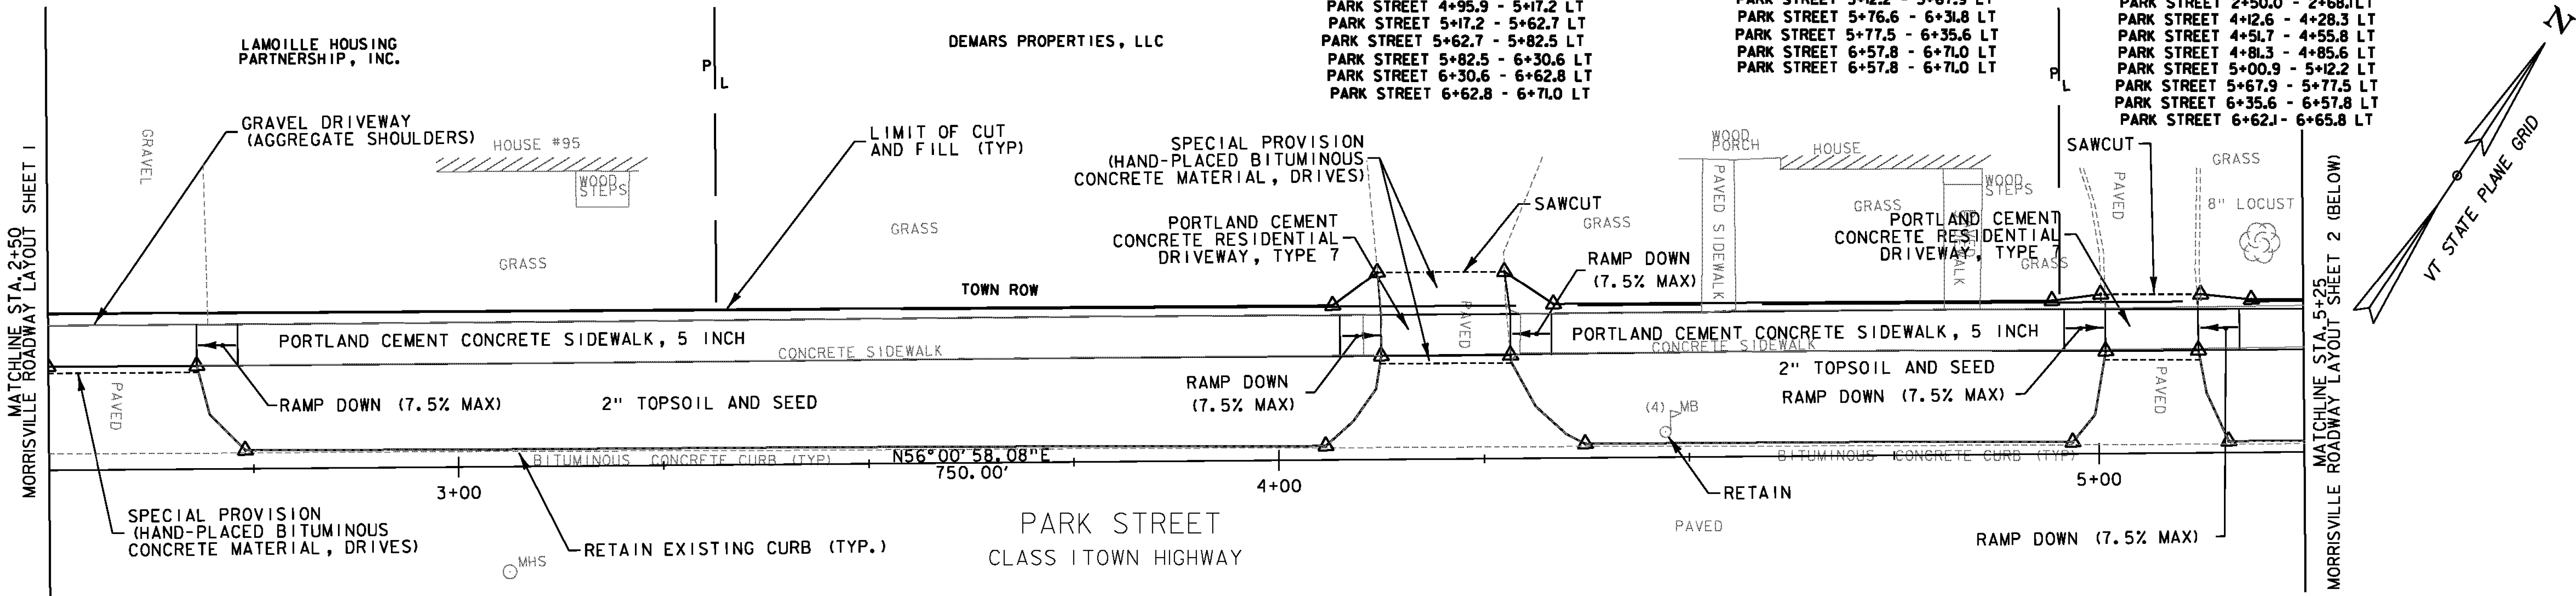

VILLAGE OF MORRISVILLE

PROJECT NAME: STATEWIDE
PROJECT NUMBER: STP SDWK(II)
FILE NAME: zllf116bdr_MorrisTown.dgn
PROJECT LEADER: E. ATKINS
DESIGNED BY: T. BIGELOW
MORRISVILLE ROADWAY LAYOUT SHEET 2

PLOT DATE: 10/9/2013
DRAWN BY: N. BOSAN
CHECKED BY: E. ATKINS
SHEET 27 OF 53

KIELY, PHILIP G., JR.
REGGIO, REBECCA C.

GREEN INTERNATIONAL AFFILIATES, INC.
CIVIL AND STRUCTURAL ENGINEERS