
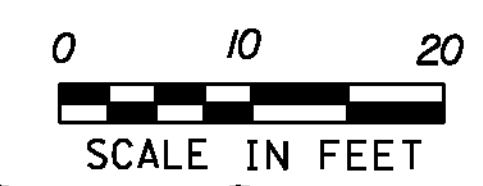


MATCHLINE STA. 2+50  
MORRISVILLE CURB TIE & GRADING SHEET 2

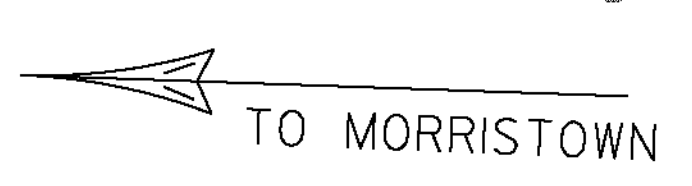

## VILLAGE OF MORRISVILLE

PROJECT NAME:	STATEWIDE
PROJECT NUMBER:	STP SDWK(II)
FILE NAME:	zlf116curbbdr_Morr1stow.dgn
PROJECT LEADER:	E. ATKINS
DESIGNED BY:	T. BIGELOW
MORRISVILLE CURB TIE & GRADING SHEET 1	SHEET 28 OF 53

GREEN INTERNATIONAL AFFILIATES, INC.  
CIVIL AND STRUCTURAL ENGINEERS

PLOT DATE: 10/9/2013  
DRAWN BY: A. SWEETMAN  
CHECKED BY: E. ATKINS