

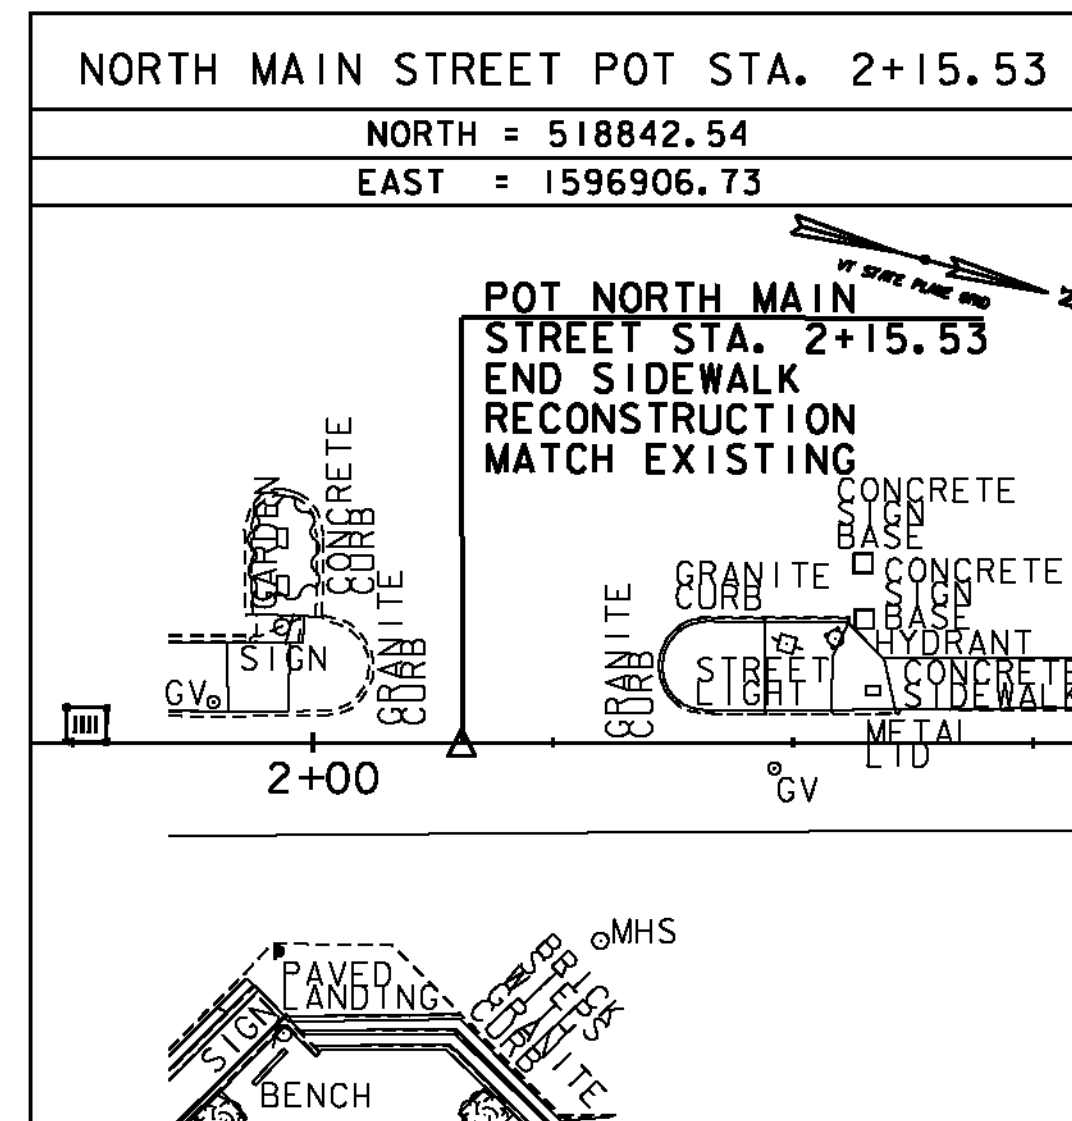


ALIGNMENT TIES

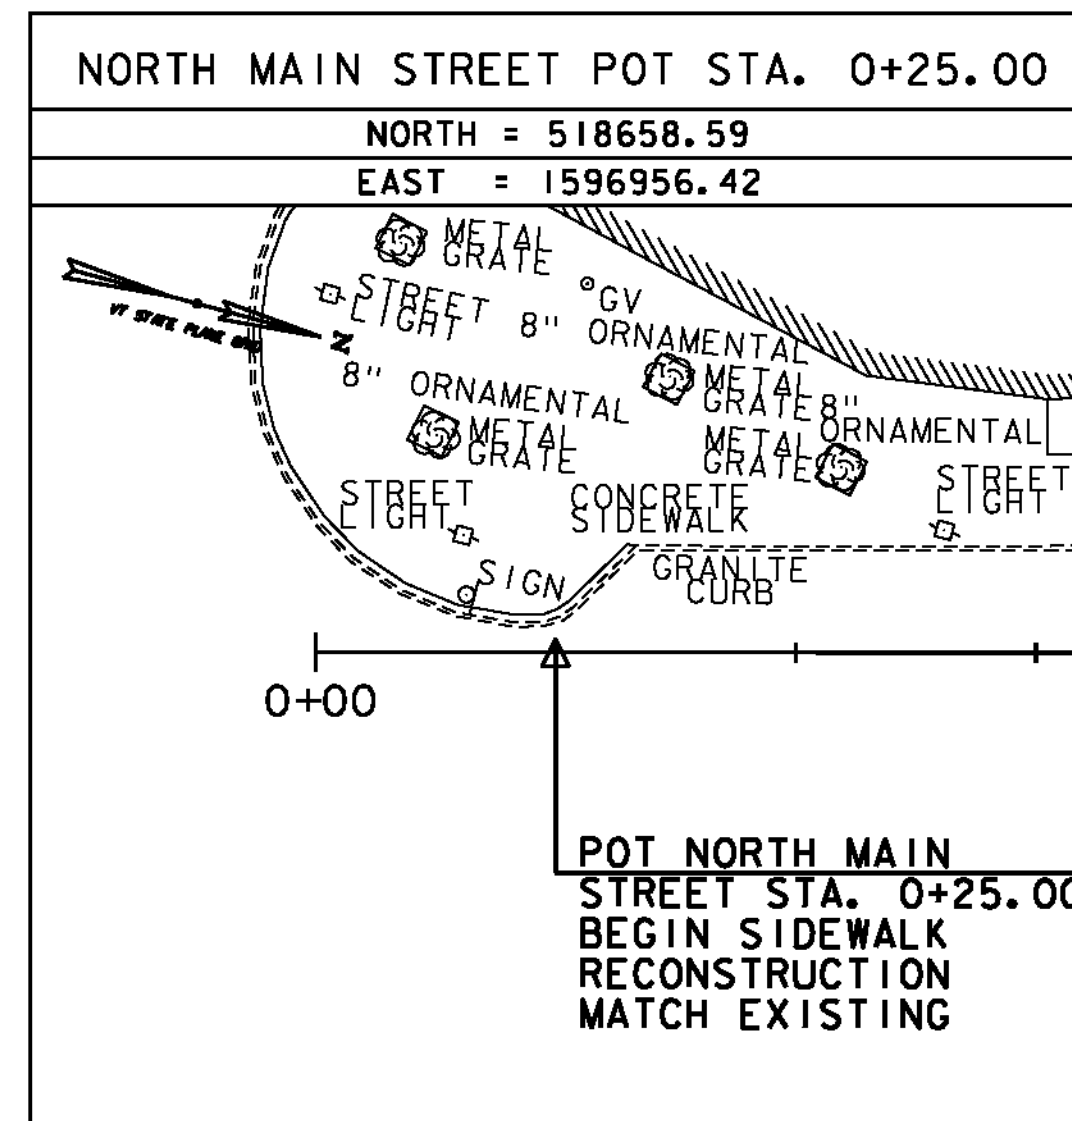

DATUM	
VERTICAL	NAVD 88(GEOD09) FT
HORIZONTAL	NAD 83(CORS) SFT
ADJUSTMENT	NONE

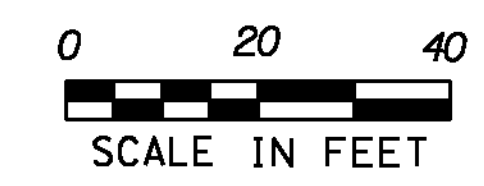

GREEN INTERNATIONAL AFFILIATES, INC.
 CIVIL AND STRUCTURAL ENGINEERS

RANDOLPH

PROJECT NAME:	STATEWIDE
PROJECT NUMBER:	STP SDWK(II)
FILE NAME:	z11f116+1_Randolph.dgn
PROJECT LEADER:	E. ATKINS
DESIGNED BY:	T. BIGELOW
RANDOLPH TIE SHEET 2	
PLOT DATE:	10/9/2013
DRAWN BY:	S. MUSTO
CHECKED BY:	E. ATKINS
SHEET	31 OF 53