


MATCHLINE STA. 3+25
RANDOLPH CURB TIE & GRADING SHEET 2

CURVE TABLE

LABEL	RADIUS (ft)	LENGTH (ft)
C14	18.00	27.98
C15	16.00	27.47

SITE #1

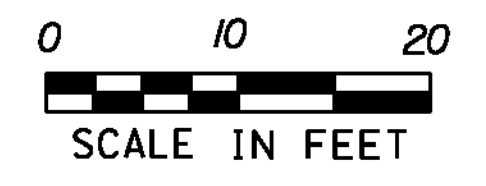

RANDOLPH

PROJECT NAME: STATEWIDE
 PROJECT NUMBER: STP SDWK(III)
 FILE NAME: z1f1i6curbdr_Randolph.dgn
 PROJECT LEADER: E. ATKINS
 DESIGNED BY: T. BIGELOW
 RANDOLPH CURB TIE & GRADING SHEET 1

PLOT DATE: 10/9/2013
 DRAWN BY: T. BIGELOW
 CHECKED BY: E. ATKINS
 SHEET 35 OF 53

GREEN INTERNATIONAL AFFILIATES, INC.
 CIVIL AND STRUCTURAL ENGINEERS