


MATCHLINE STA. 3+25
RANDOLPH CURB TIE & GRADING SHEET 1

CURVE TABLE

LABEL	RADIUS (ft)	LENGTH (ft)
C16	15.00	13.07
C17	20.00	24.02
C18	4.00	3.66
C19	15.00	13.56

TRILLIUM 2000 LTD.
PLEASANT STREET PARTNERS LLC
TRUMAN, ERIC J.
RICH, IRENE C.

SITE #1

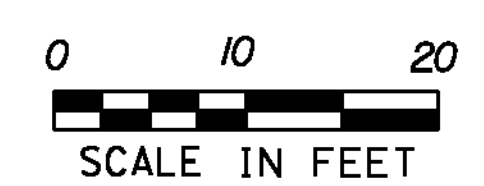

RANDOLPH

PROJECT NAME: STATEWIDE
PROJECT NUMBER: STP SDWK(III)

FILE NAME: z11f16curbbdr_Randolph.dgn
PROJECT LEADER: E. ATKINS
DESIGNED BY: T. BIGELOW
RANDOLPH CURB TIE & GRADING SHEET 2

PLOT DATE: 10/9/2013
DRAWN BY: A. SWEETMAN
CHECKED BY: E. ATKINS
SHEET 36 OF 53