



WORK IN THIS AREA IS NOT IN CONTRACT

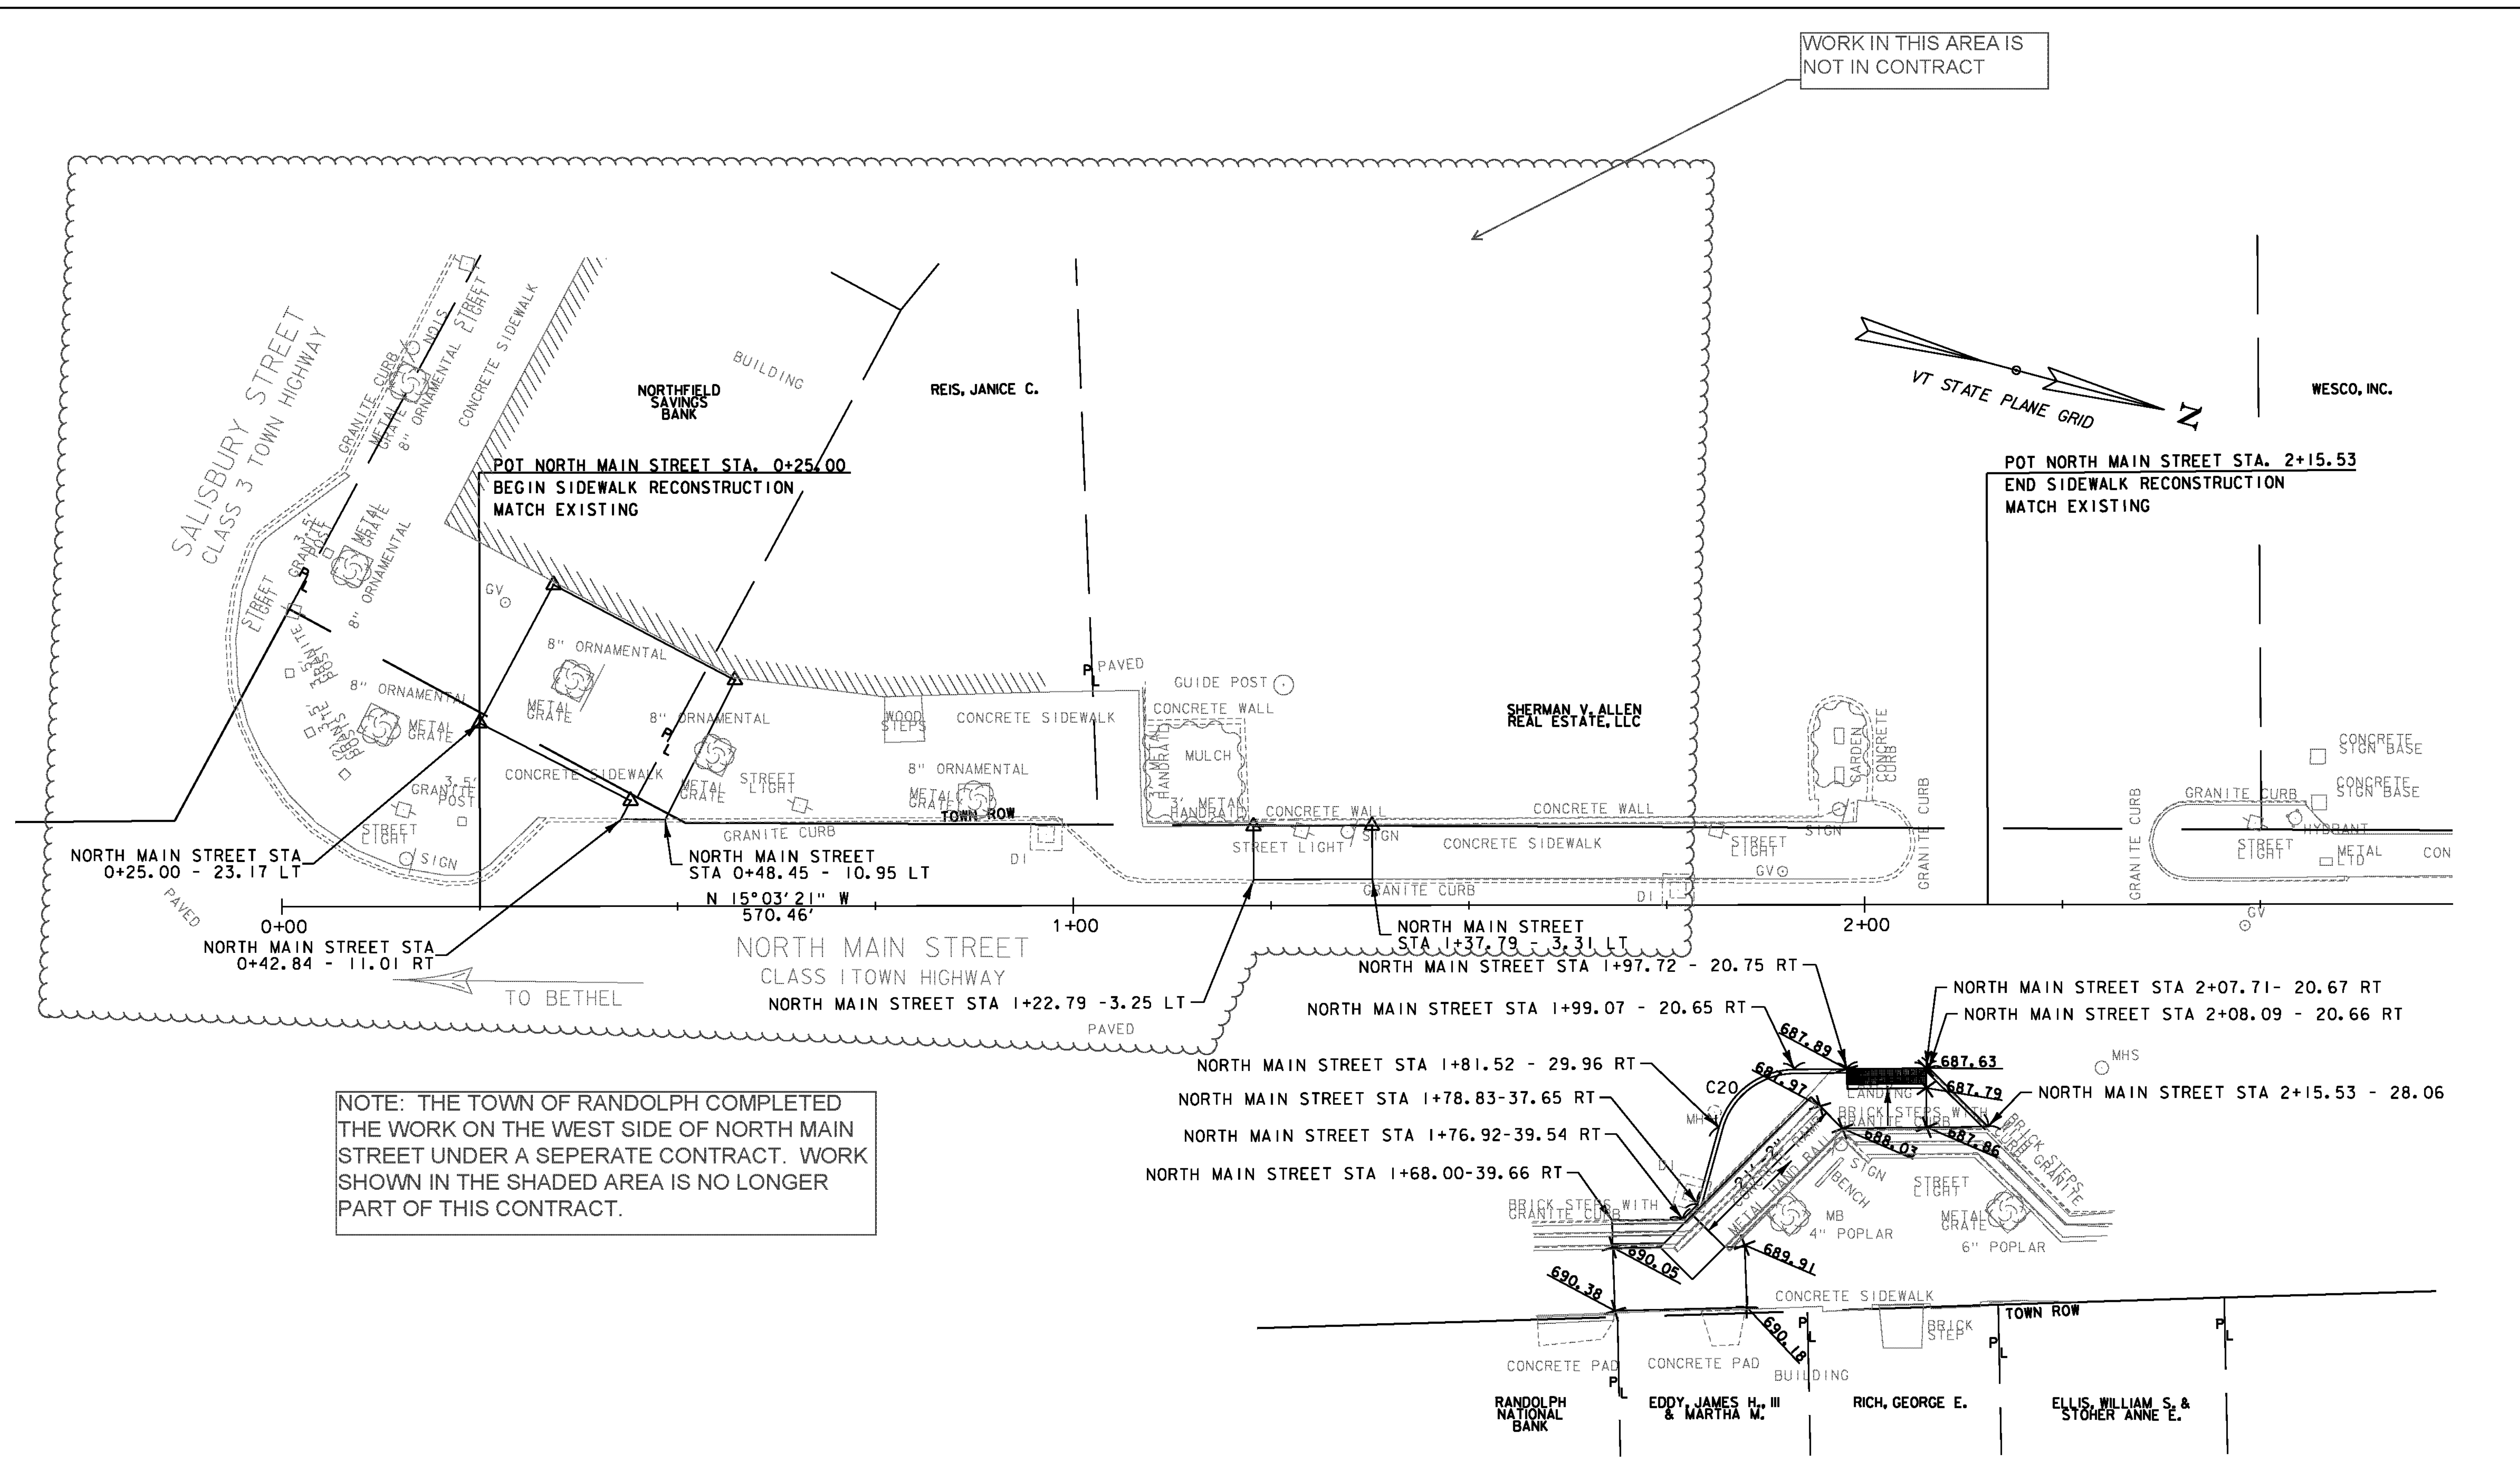


NOTE: THE TOWN OF RANDOLPH COMPLETED THE WORK ON THE WEST SIDE OF NORTH MAIN STREET UNDER A SEPERATE CONTRACT. WORK SHOWN IN THE SHADED AREA IS NO LONGER PART OF THIS CONTRACT.

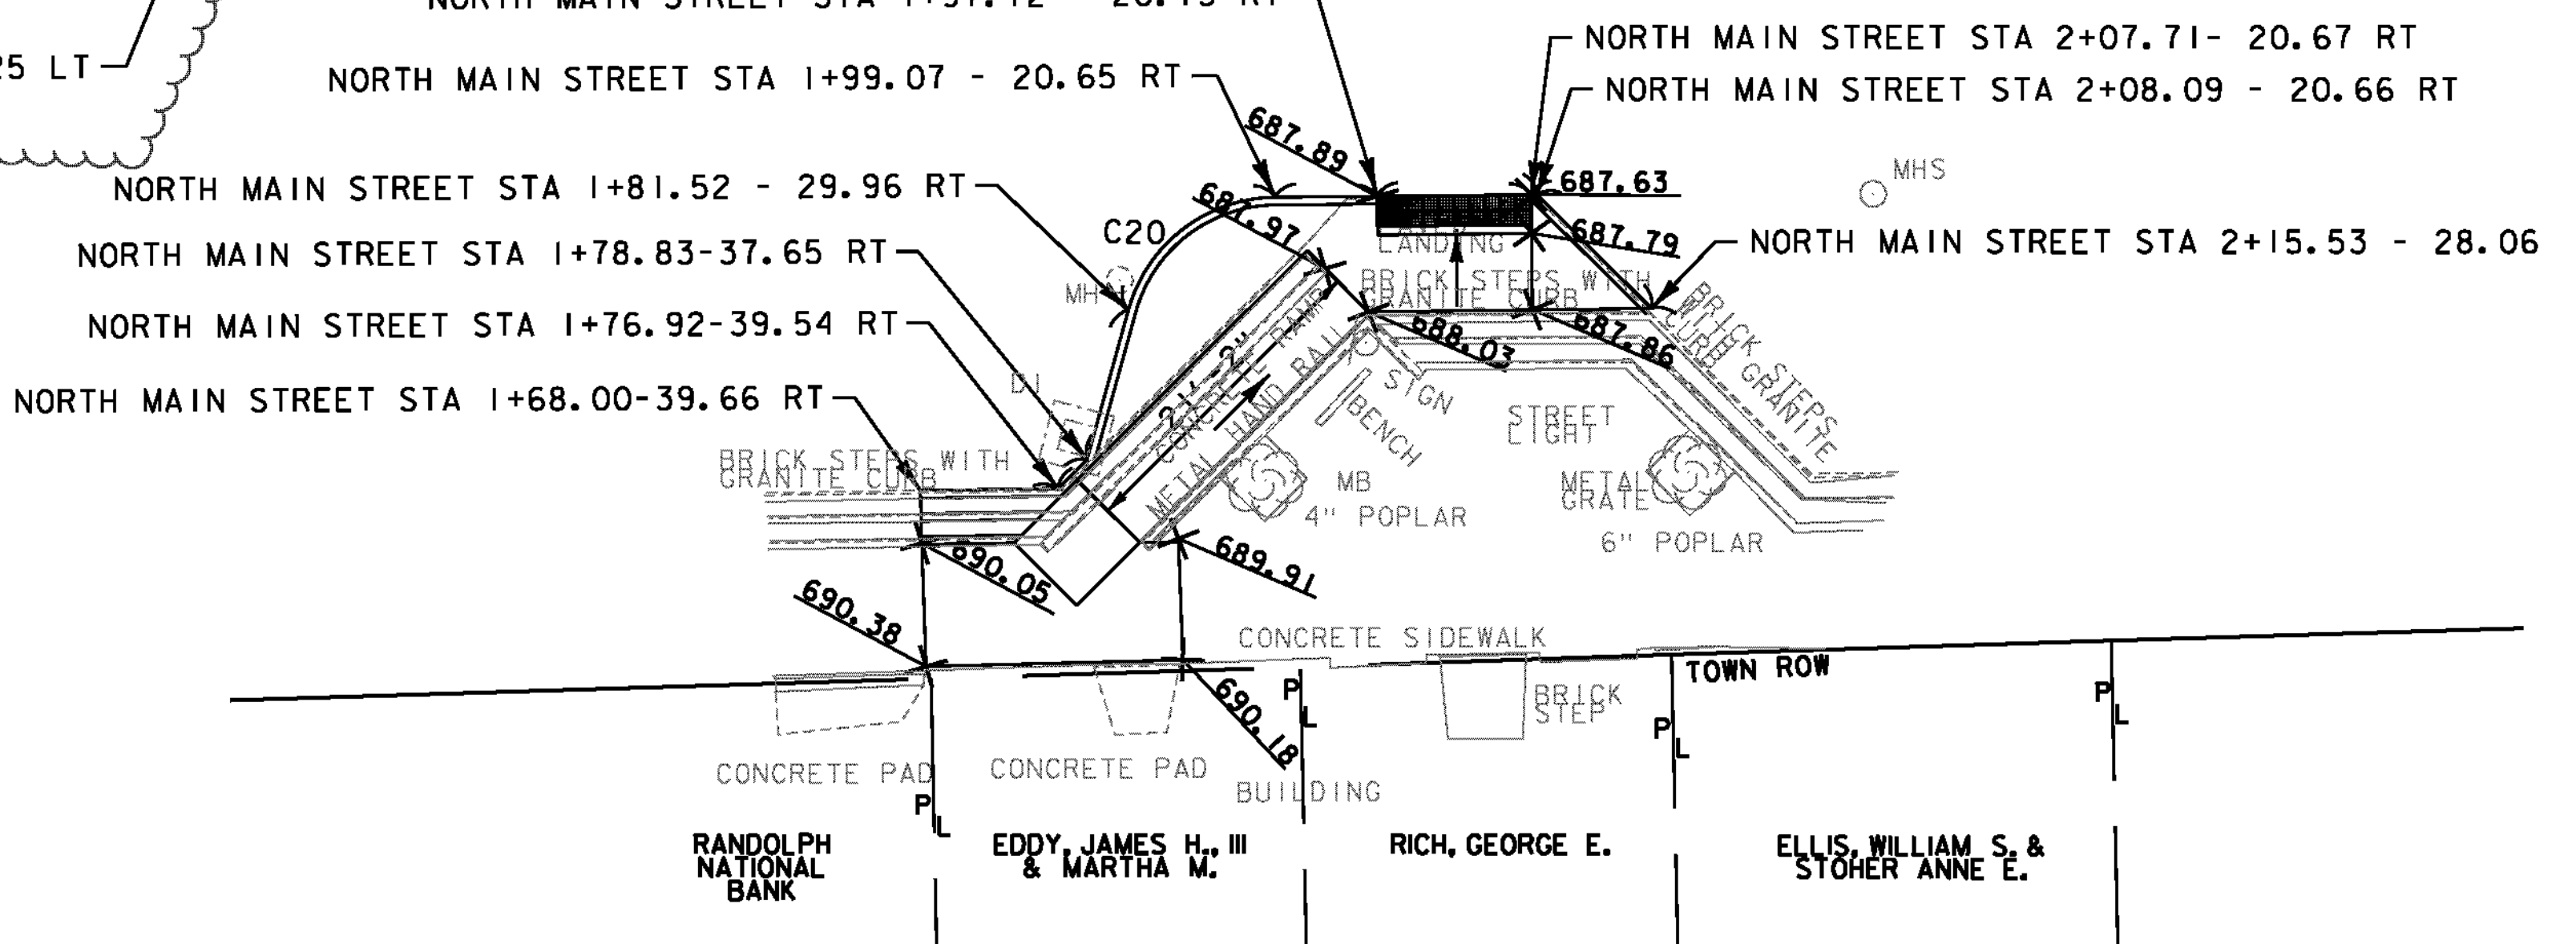

CURVE TABLE

LABEL	RADIUS (ft)	LENGTH (ft)
C20	10.00	12.91

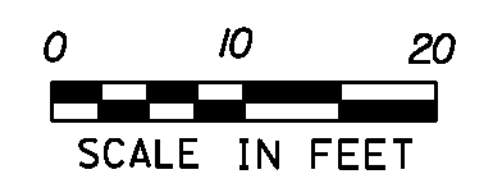

RANDOLPH

PROJECT NAME: STATEWIDE
 PROJECT NUMBER: STP SDWK(II)
 FILE NAME: z11f16curbbdr_Randolph.dgn
 PROJECT LEADER: E. ATKINS
 DESIGNED BY: T. BIGELOW
 RANDOLPH CURB TIE & GRADING SHEET 3
 PLOT DATE: 10/9/2013
 DRAWN BY: A. SWEETMAN
 CHECKED BY: E. ATKINS
 SHEET 37 OF 53