


CURVE TABLE

LABEL	RADIUS	LENGTH
	(ft)	(ft)
C22	10.00	15.88
C23	13.00	20.25
C24	13.00	20.60

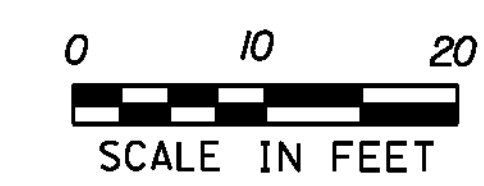

RUTLAND

PROJECT NAME: STATEWIDE
 PROJECT NUMBER: STP SDWK(II)
 FILE NAME: z11f16curbldr_Rutland.dgn
 PLOT DATE: 10/9/2013
 PROJECT LEADER: E. ATKINS
 DRAWN BY: N. BOSAN
 DESIGNED BY: T. BIGELOW
 CHECKED BY: E. ATKINS
 RUTLAND CURB TIE & GRADING SHEET
 SHEET 40 OF 53

GREEN INTERNATIONAL AFFILIATES, INC.
 CIVIL AND STRUCTURAL ENGINEERS