

DURABLE 4 INCH WHITE LINE, POLYUREA
MM 3.480 TO 3.852, SOLID LT. & RT.


TEMPORARY 4 INCH WHITE LINE, PAINT
MM 3.480 TO 3.852, SOLID LT. & RT.

DURABLE 4 INCH YELLOW LINE, POLYUREA
MM 3.480 TO 3.852, SOLID LT. & RT.

TEMPORARY 4 INCH YELLOW LINE, PAINT
MM 3.480 TO 3.852, SOLID LT. & RT.

DURABLE LETTER OR SYMBOL, POLYUREA
MM 3.700, RT. - 'SCHOOL'

TEMPORARY LETTER OR SYMBOL, PAINT
MM 3.700, RT. - 'SCHOOL'

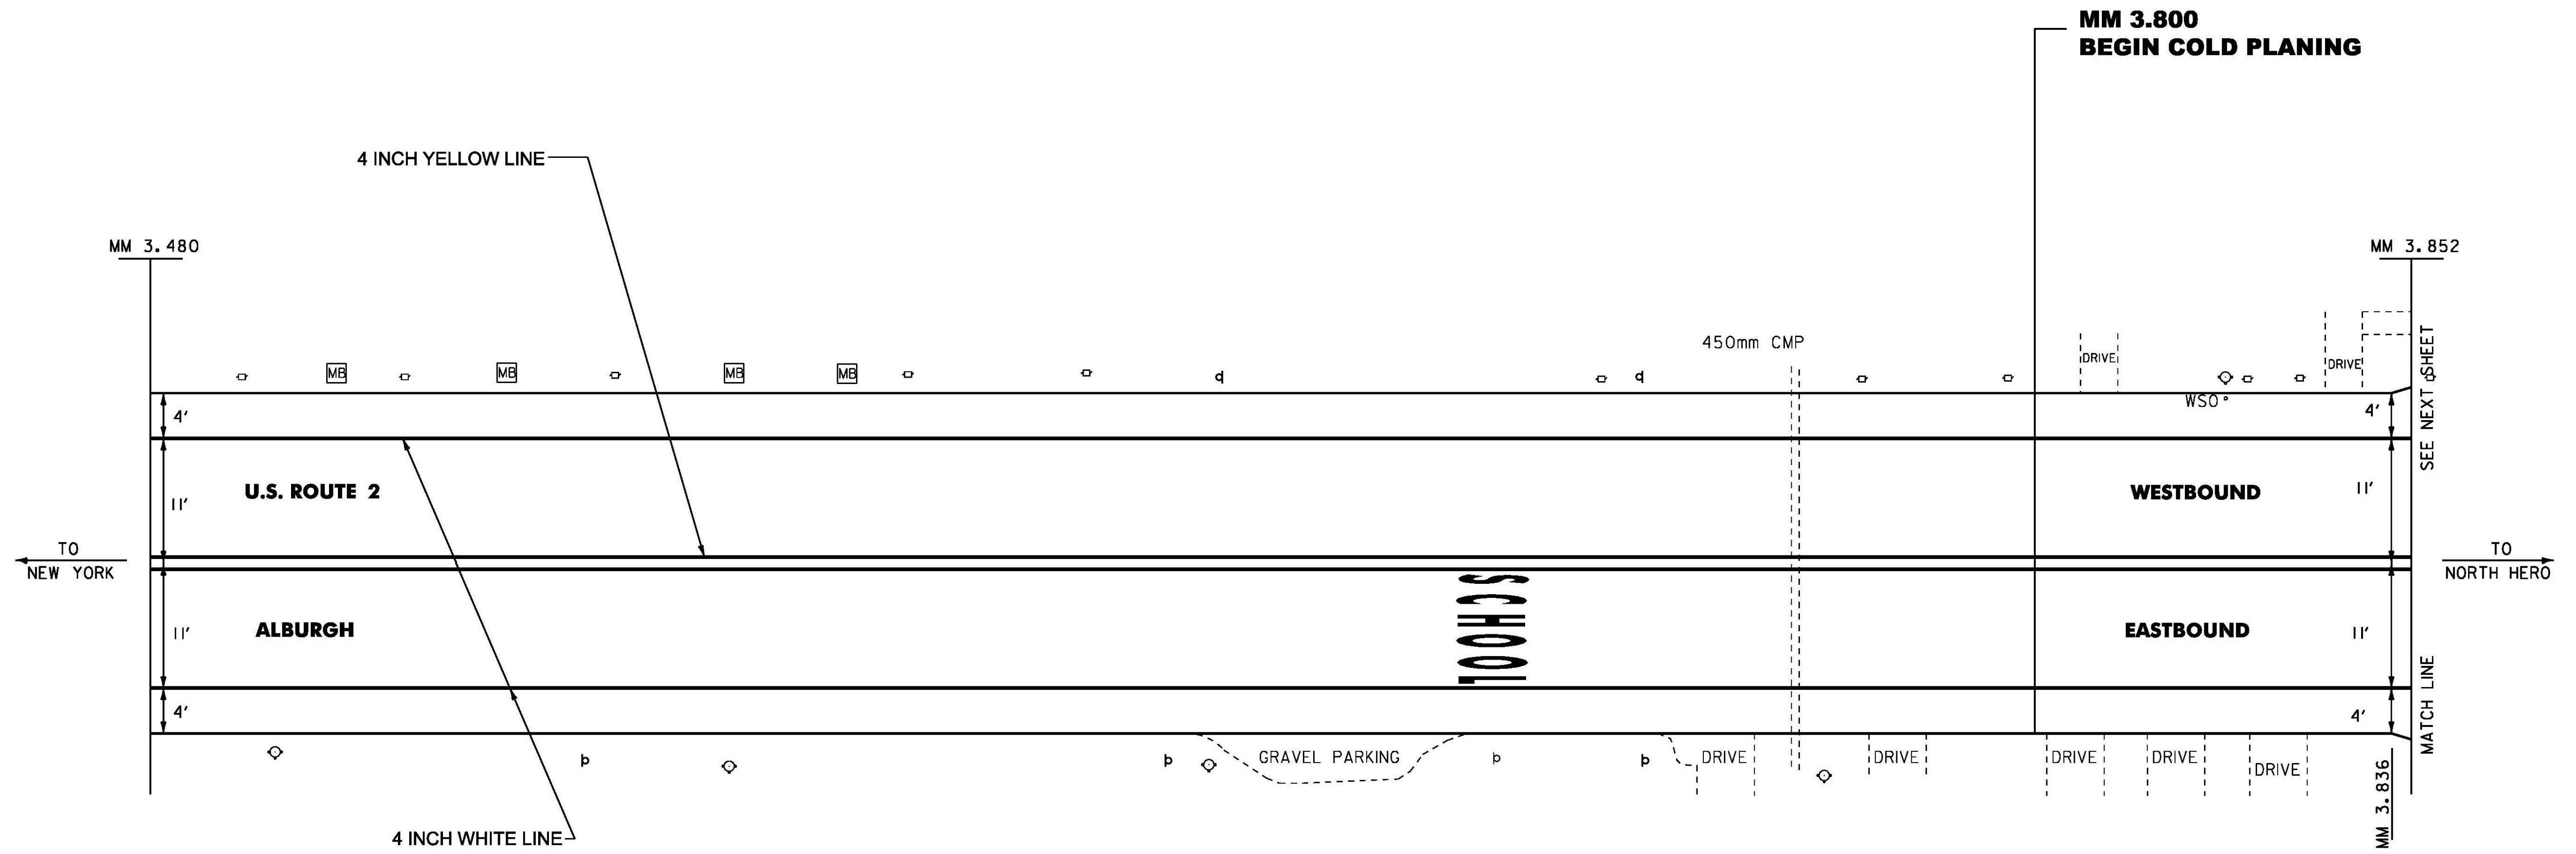

NOT TO SCALE

**PAVEMENT
MARKING
DETAIL
SHEET 1**

PROJECT NAME: ALBURGH
PROJECT NUMBER: NH SURF(35)

FILE NAME: I2b320.dgn
PROJECT LEADER: FOWLER
DESIGNED BY: PM
pI2b320 II.1

PLOT DATE: 25-APR-2013
DRAWN BY: PM
CHECKED BY: PM
SHEET 18 OF 70

NOTE:
1. MM 3.852 ~ MM 4.100: COLD PLANE 1.0", LEVEL WITH 0.5" TYPE IVS, THEN PAVE WEARING SURFACE.
2. SEE QUANTITY SHEETS FOR DURABLE MARKING OPTIONS.