


DURABLE 4 INCH WHITE LINE, POLYUREA
 MM 4.350 TO 4.785, SOLID LT. & RT.
 (WITH EDGELINE BREAKS FOR JARVIS AVE.
 & WINTERS LN.)

TEMPORARY 4 INCH WHITE LINE, PAINT
 MM 4.350 TO 4.785, SOLID LT. & RT.
 (WITH EDGELINE BREAKS FOR JARVIS AVE.
 & WINTERS LN.)

DURABLE 4 INCH YELLOW LINE, POLYUREA
 MM 4.350 TO 4.785, SOLID LT. & RT.
 (WITH CENTERLINE BREAKS FOR JARVIS
 AVE. & WINTERS LN.)

TEMPORARY 4 INCH YELLOW LINE, PAINT
 MM 4.350 TO 4.785, SOLID LT. & RT.
 (WITH CENTERLINE BREAKS FOR JARVIS
 AVE. & WINTERS LN.)

CHANGING ELEVATION OF DI'S CB'S OR MH'S
 MM 4.516, RT.

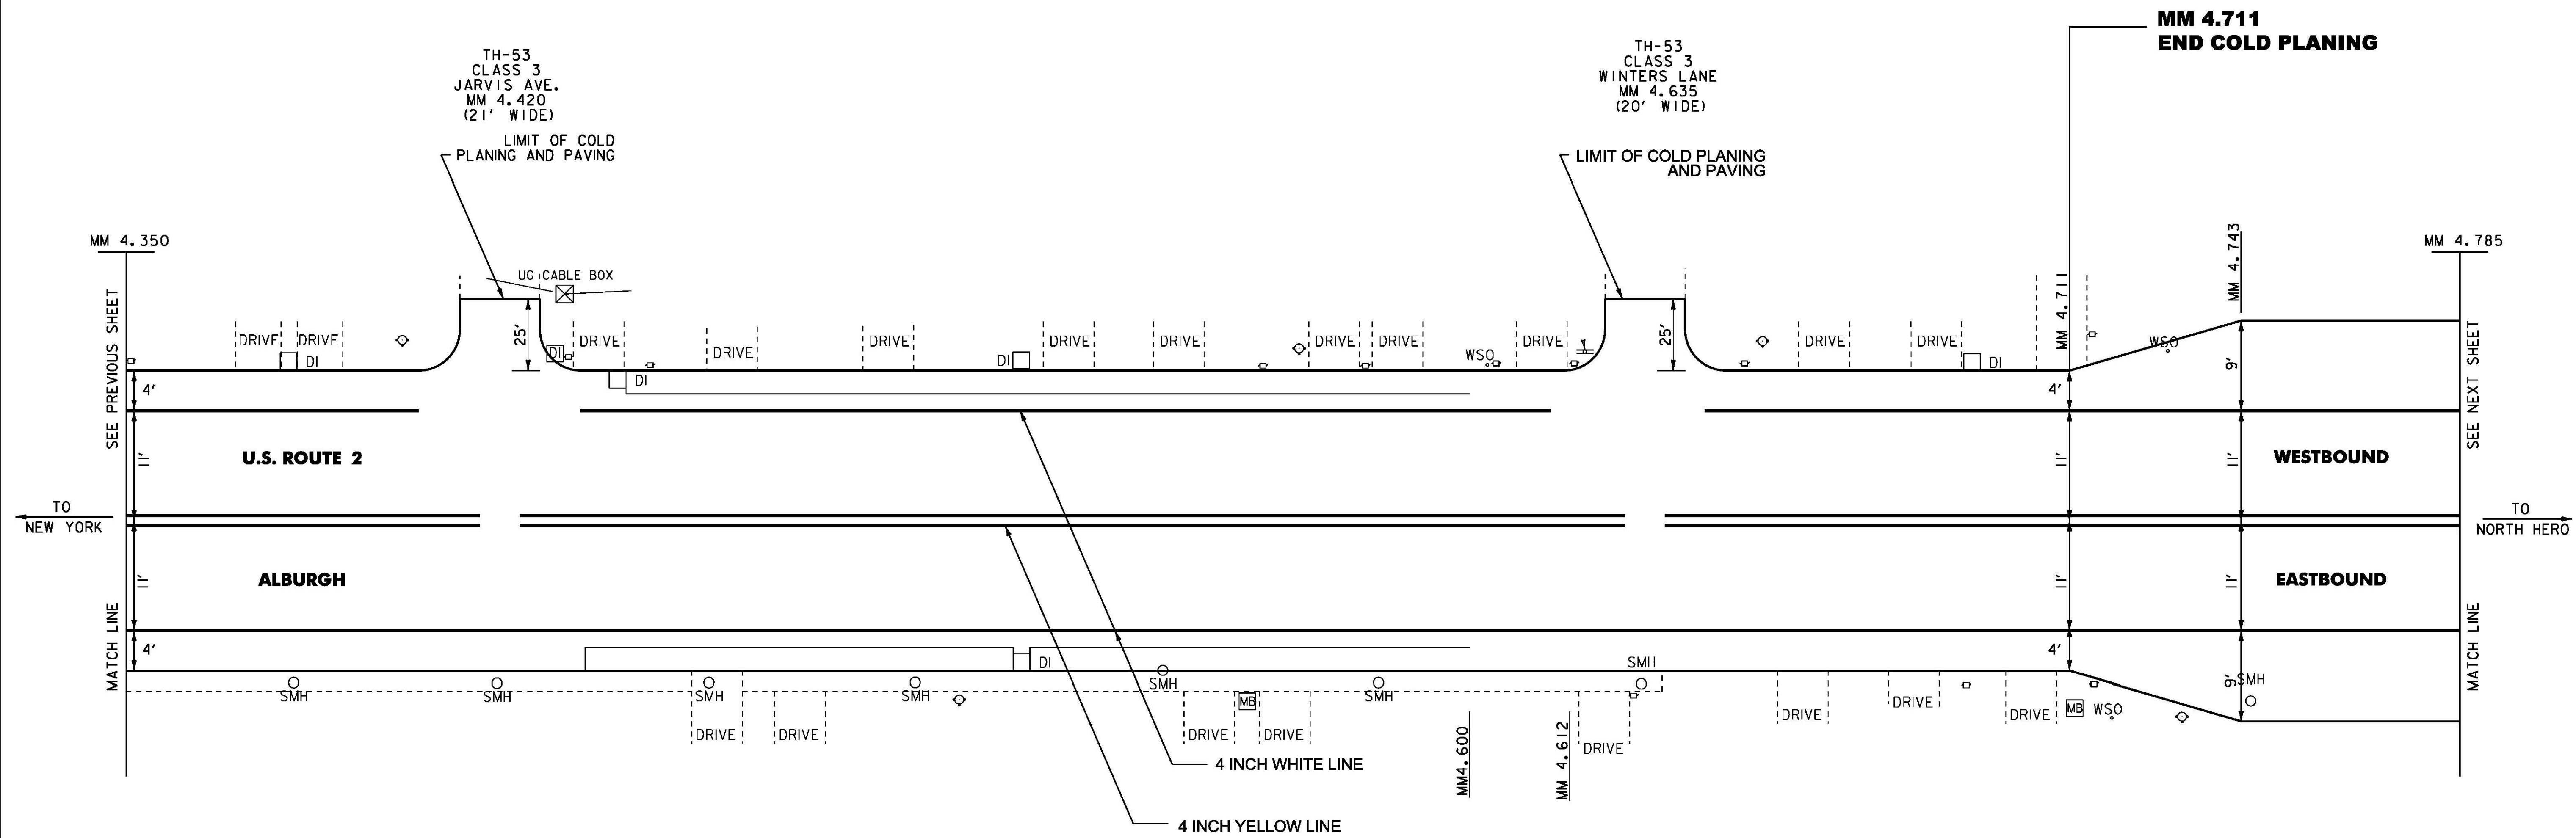

NOTE:
 1. MM 4.350 ~ MM 4.711: COLD PLANE 1.0", LEVEL WITH 0.5" TYPE IVS, THEN PAVE WEARING SURFACE.
 2. SEE QUANTITY SHEETS FOR DURABLE MARKING OPTIONS.

NOT TO SCALE

**PAVEMENT
 MARKING
 DETAIL
 SHEET 4**

PROJECT NAME: ALBURGH	PLOT DATE: 25-APR-2013
PROJECT NUMBER: NH SURF(35)	DRAWN BY: PM
FILE NAME: I2b320.dgn	DESIGNED BY: PM
PROJECT LEADER: FOWLER	CHECKED BY: PM
DESIGNED BY:	SHEET 21 OF 70
I2b320 13.1	