
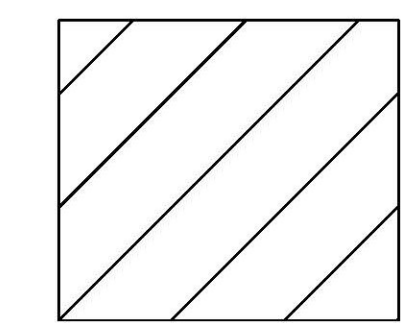


**MM 6.263
BEGIN PROJECT
STP SURF(36)**

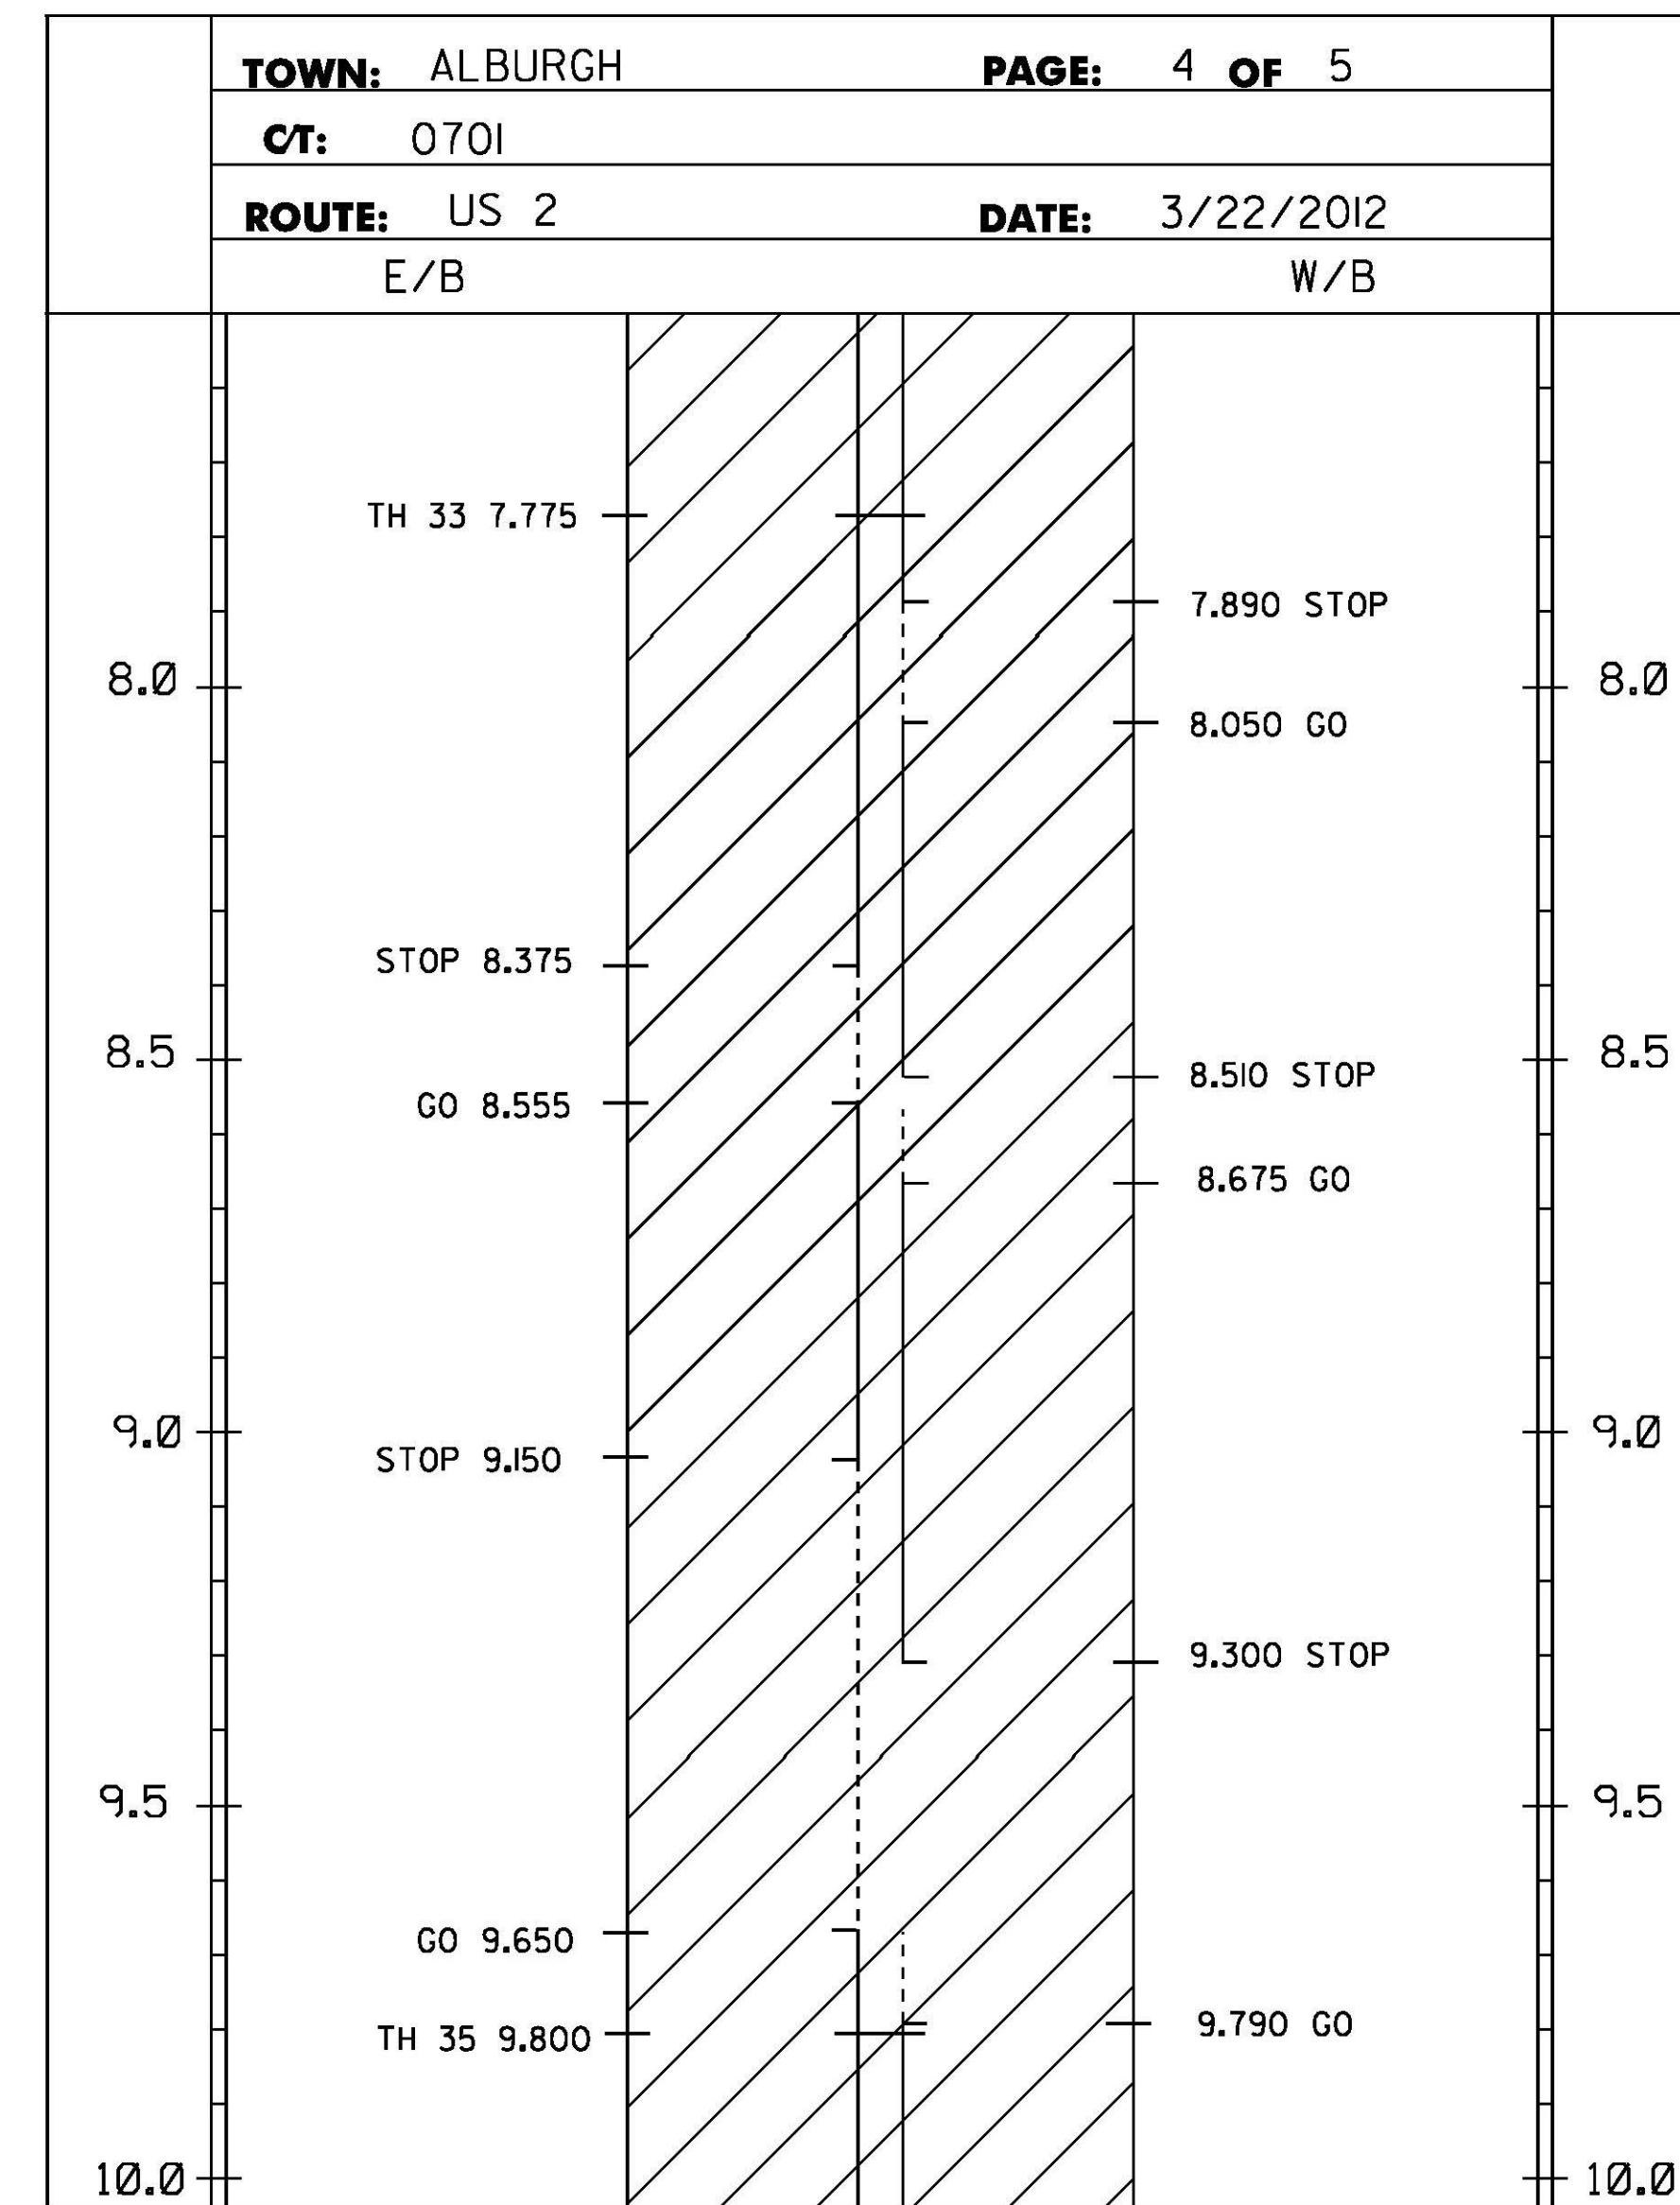

PROJECT AREA

LEGEND

- TWBH-THROUGHWAY BEGINS HERE
- TWEH-THROUGHWAY ENDS HERE
- SHB-STATE HIGHWAY BEGINS
- SHE-STATE HIGHWAY ENDS
- SL-SPEED LIMIT
- C/4 TH- CLASS 4 TOWN HIGHWAY
- T/L-TOWN LINE

NOTES:
1. THIS SHEET TO BE USED FOR THE LAYOUT OF ALL CENTERLINE PAVEMENT MARKINGS.
THE RESIDENT ENGINEER MAY CONTACT KEITH SWEET, PAVEMENT MARKING SUPERVISOR
AT (802) 828-5573 FOR ASSISTANCE LAYING OUT THE CENTERLINE DURING CONSTRUCTION.

NOT TO SCALE CENTERLINE MARKING DETAIL SHEET 1	PROJECT NAME: ALBURGH-COLCHESTER	
	PROJECT NUMBER: STP SURF(36)	
	FILE NAME: I2b322.dgn	PLOT DATE: 25-APR-2013
DESIGNED BY: PVT. MGT.	DRAWN BY: PVT. MGT.	
I2b322md01.l	CHECKED BY: PVT. MGT.	SHEET 33 OF 70