

DURABLE 4 INCH WHITE LINE, POLYUREA
MM 0.326, LT. (BRIDGE RD EDGELINES.)

DURABLE 4 INCH YELLOW LINE, POLYUREA
MM 0.326 LT. (BRIDGE RD.)

DURABLE 24 INCH STOP BAR, POLYUREA
MM 0.326, LT. (BRIDGE RD.)


DURABLE LETTER OR SYMBOL, POLYUREA
MM 0.326, LT. - "STOP"

TEMPORARY 4 INCH WHITE LINE
MM 0.326, LT. (BRIDGE RD EDGELINES.)

TEMPORARY 4 INCH YELLOW LINE
MM 0.326 LT. (BRIDGE RD.)

TEMPORARY 24 INCH STOP BAR
MM 0.326, LT. (BRIDGE RD.)

TEMPORARY LETTER OR SYMBOL
MM 0.326, LT. - "STOP"

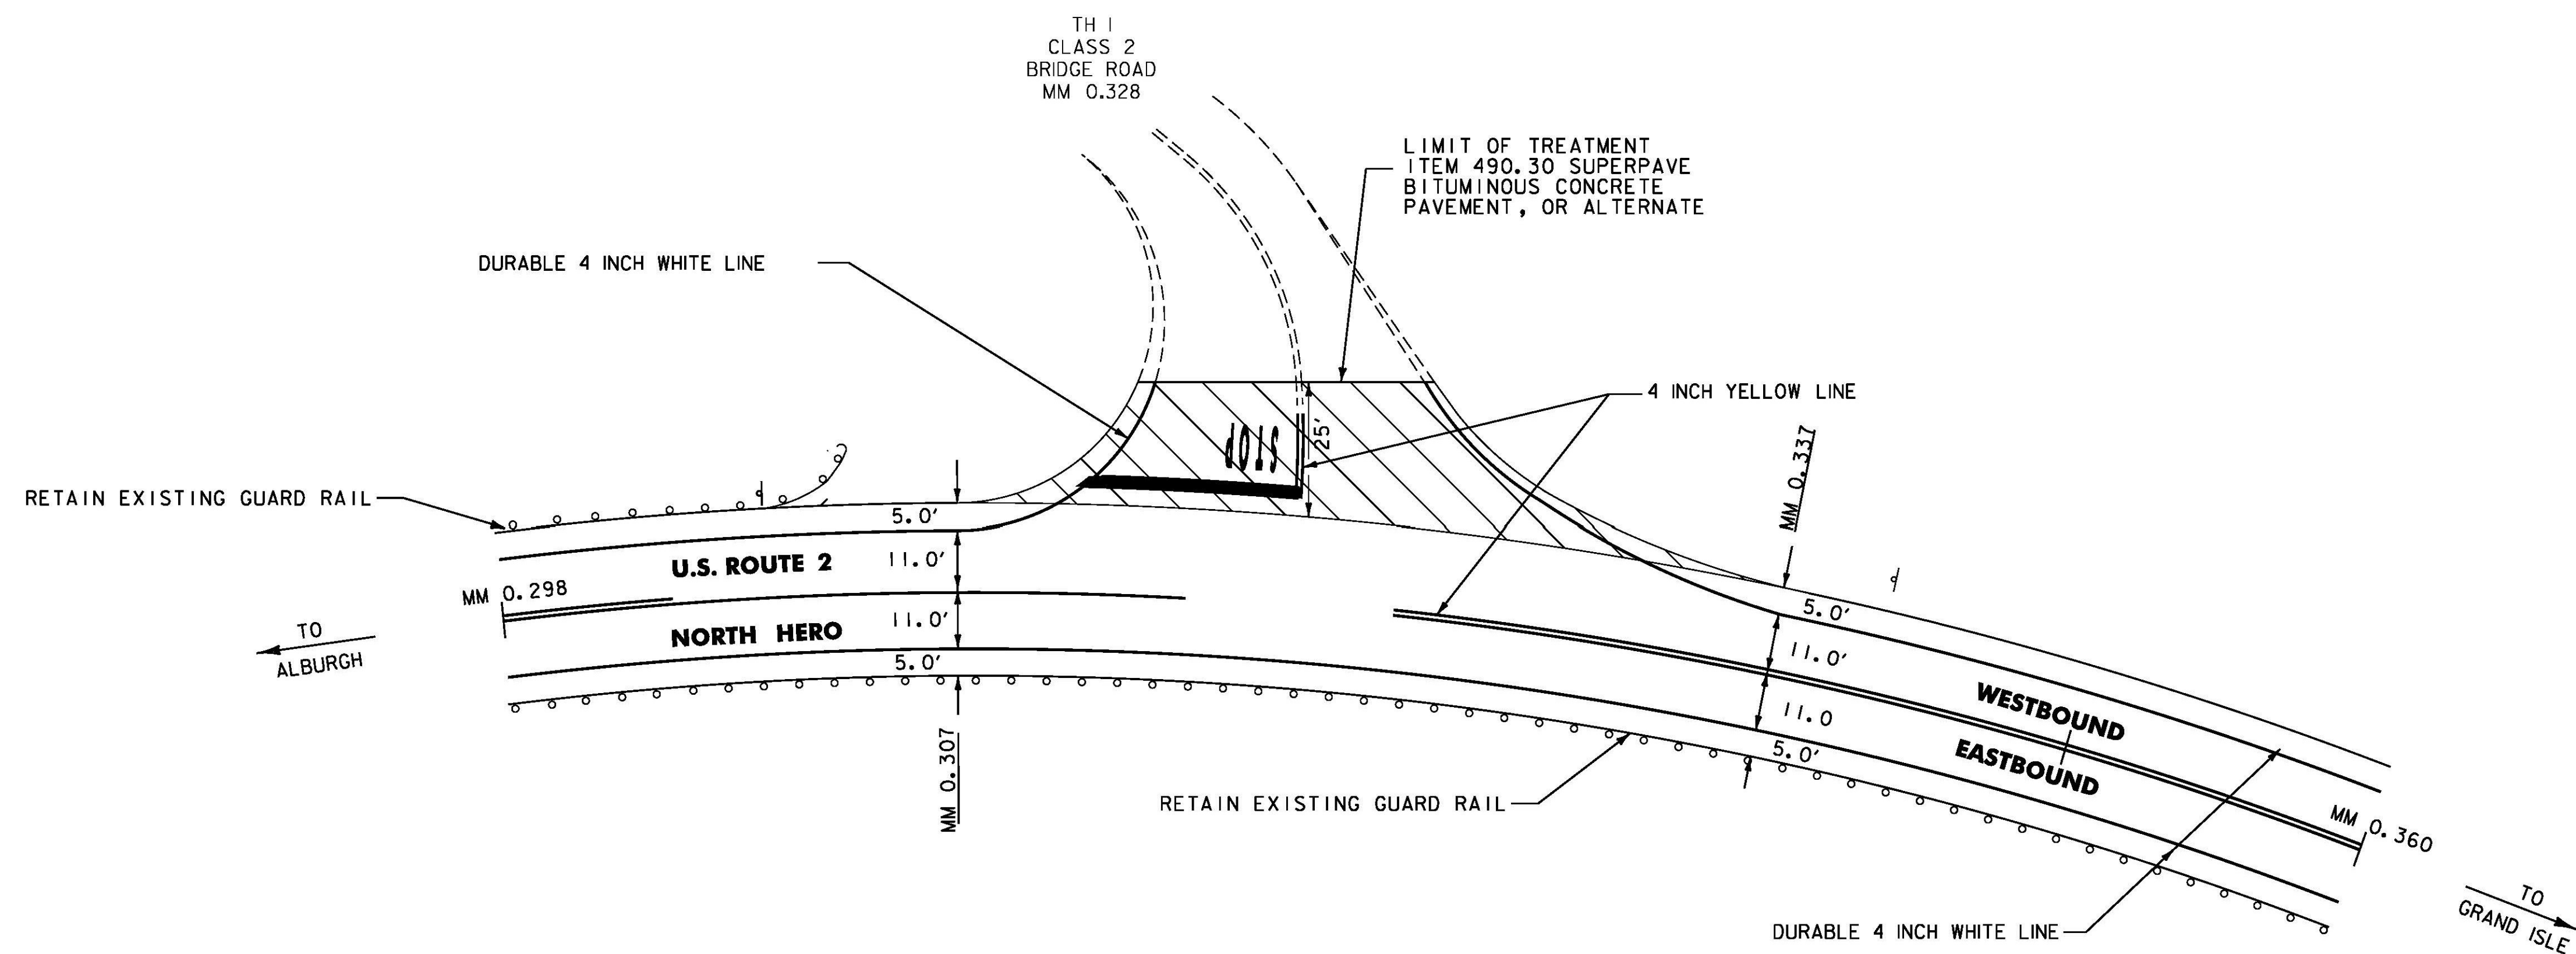

U.S. ROUTE 2 /T.H.6 - BRIDGE ROAD INTERSECTION
MM 0.328

NOT TO SCALE

NORTH HERO DETAIL SHEET 1	PROJECT NAME: ALBURGH - COLCHESTER
	PROJECT NUMBER: STP SURF(36)
	FILE NAME: I2b322.dgn
	PLOT DATE: 25-APR-2013
DESIGNED BY: PVT. MGT.	CHECKED BY: PVT. MGT.
I2b322nhds02.1	SHEET 43 OF 70