



DURABLE LETTER OR SYMBOL,  
POLYUREA  
MM 4.536, LT. - "STOP"  
TEMPORARY LETTER OR SYMBOL  
MM 4.536, LT. - "STOP"

DURABLE 24 INCH STOP BAR,  
POLYUREA  
MM 4.536, LT.  
TEMPORARY 24 INCH STOP BAR  
MM 4.536, LT.

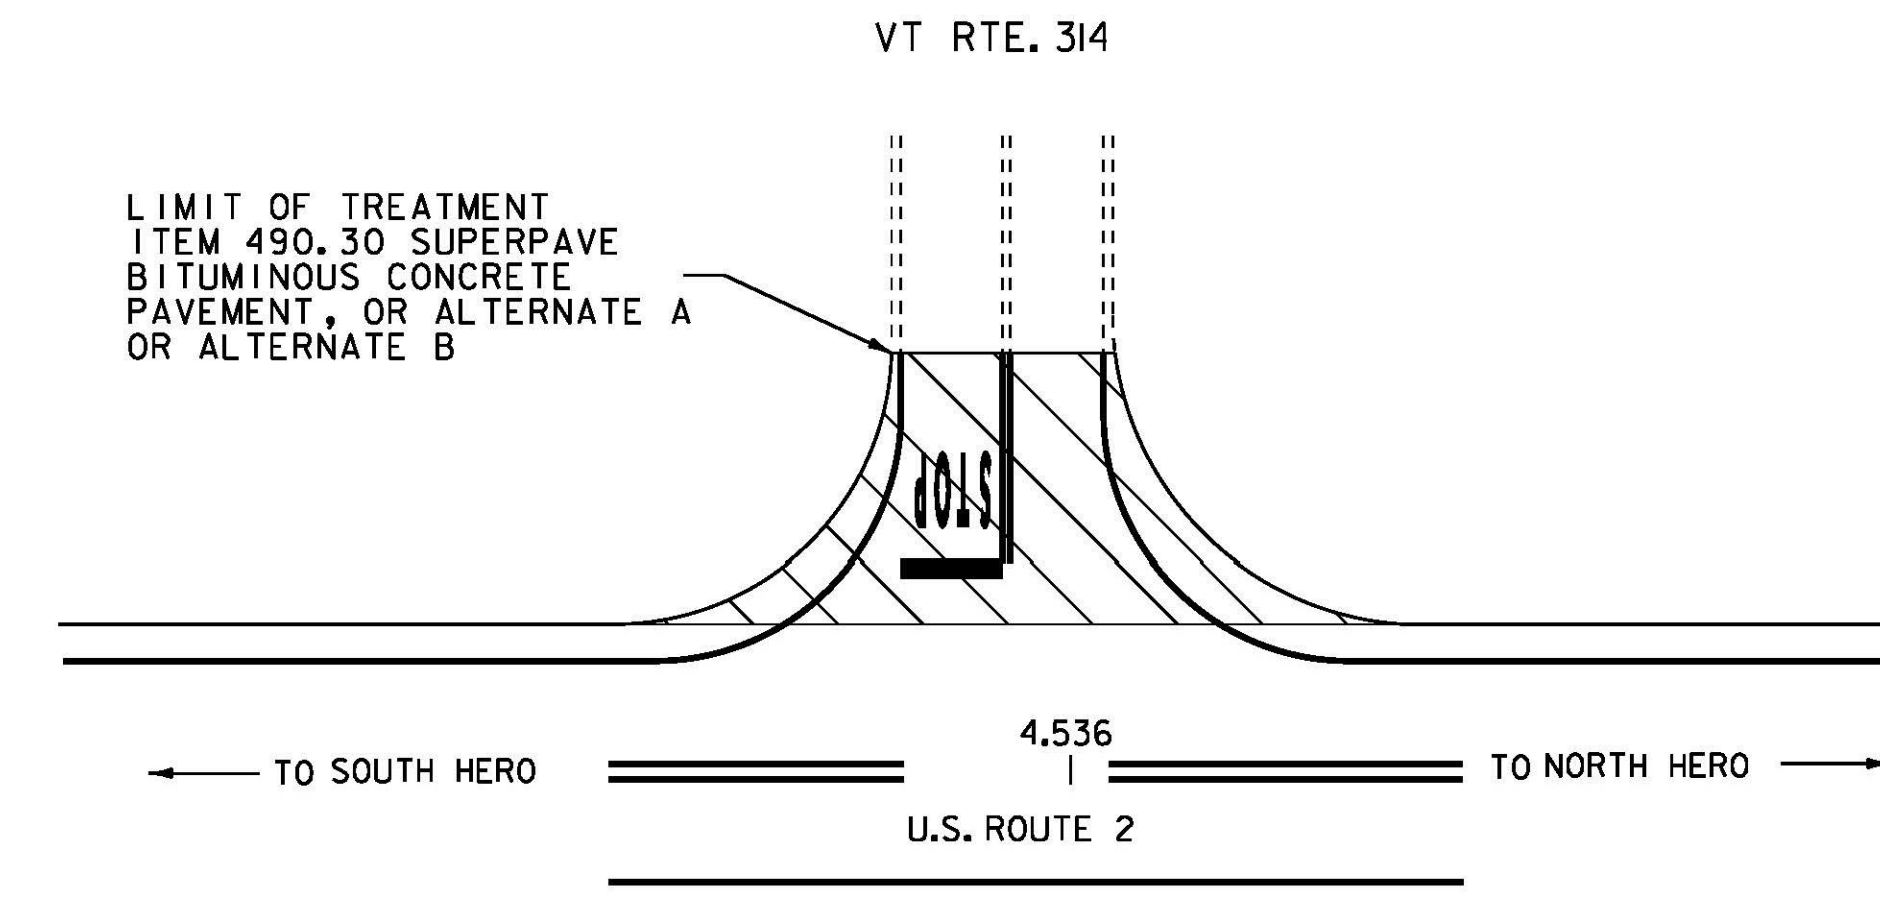

**INTERSECTION DETAIL  
U.S. ROUTE 2 / VT ROUTE 314**

MM 4.536

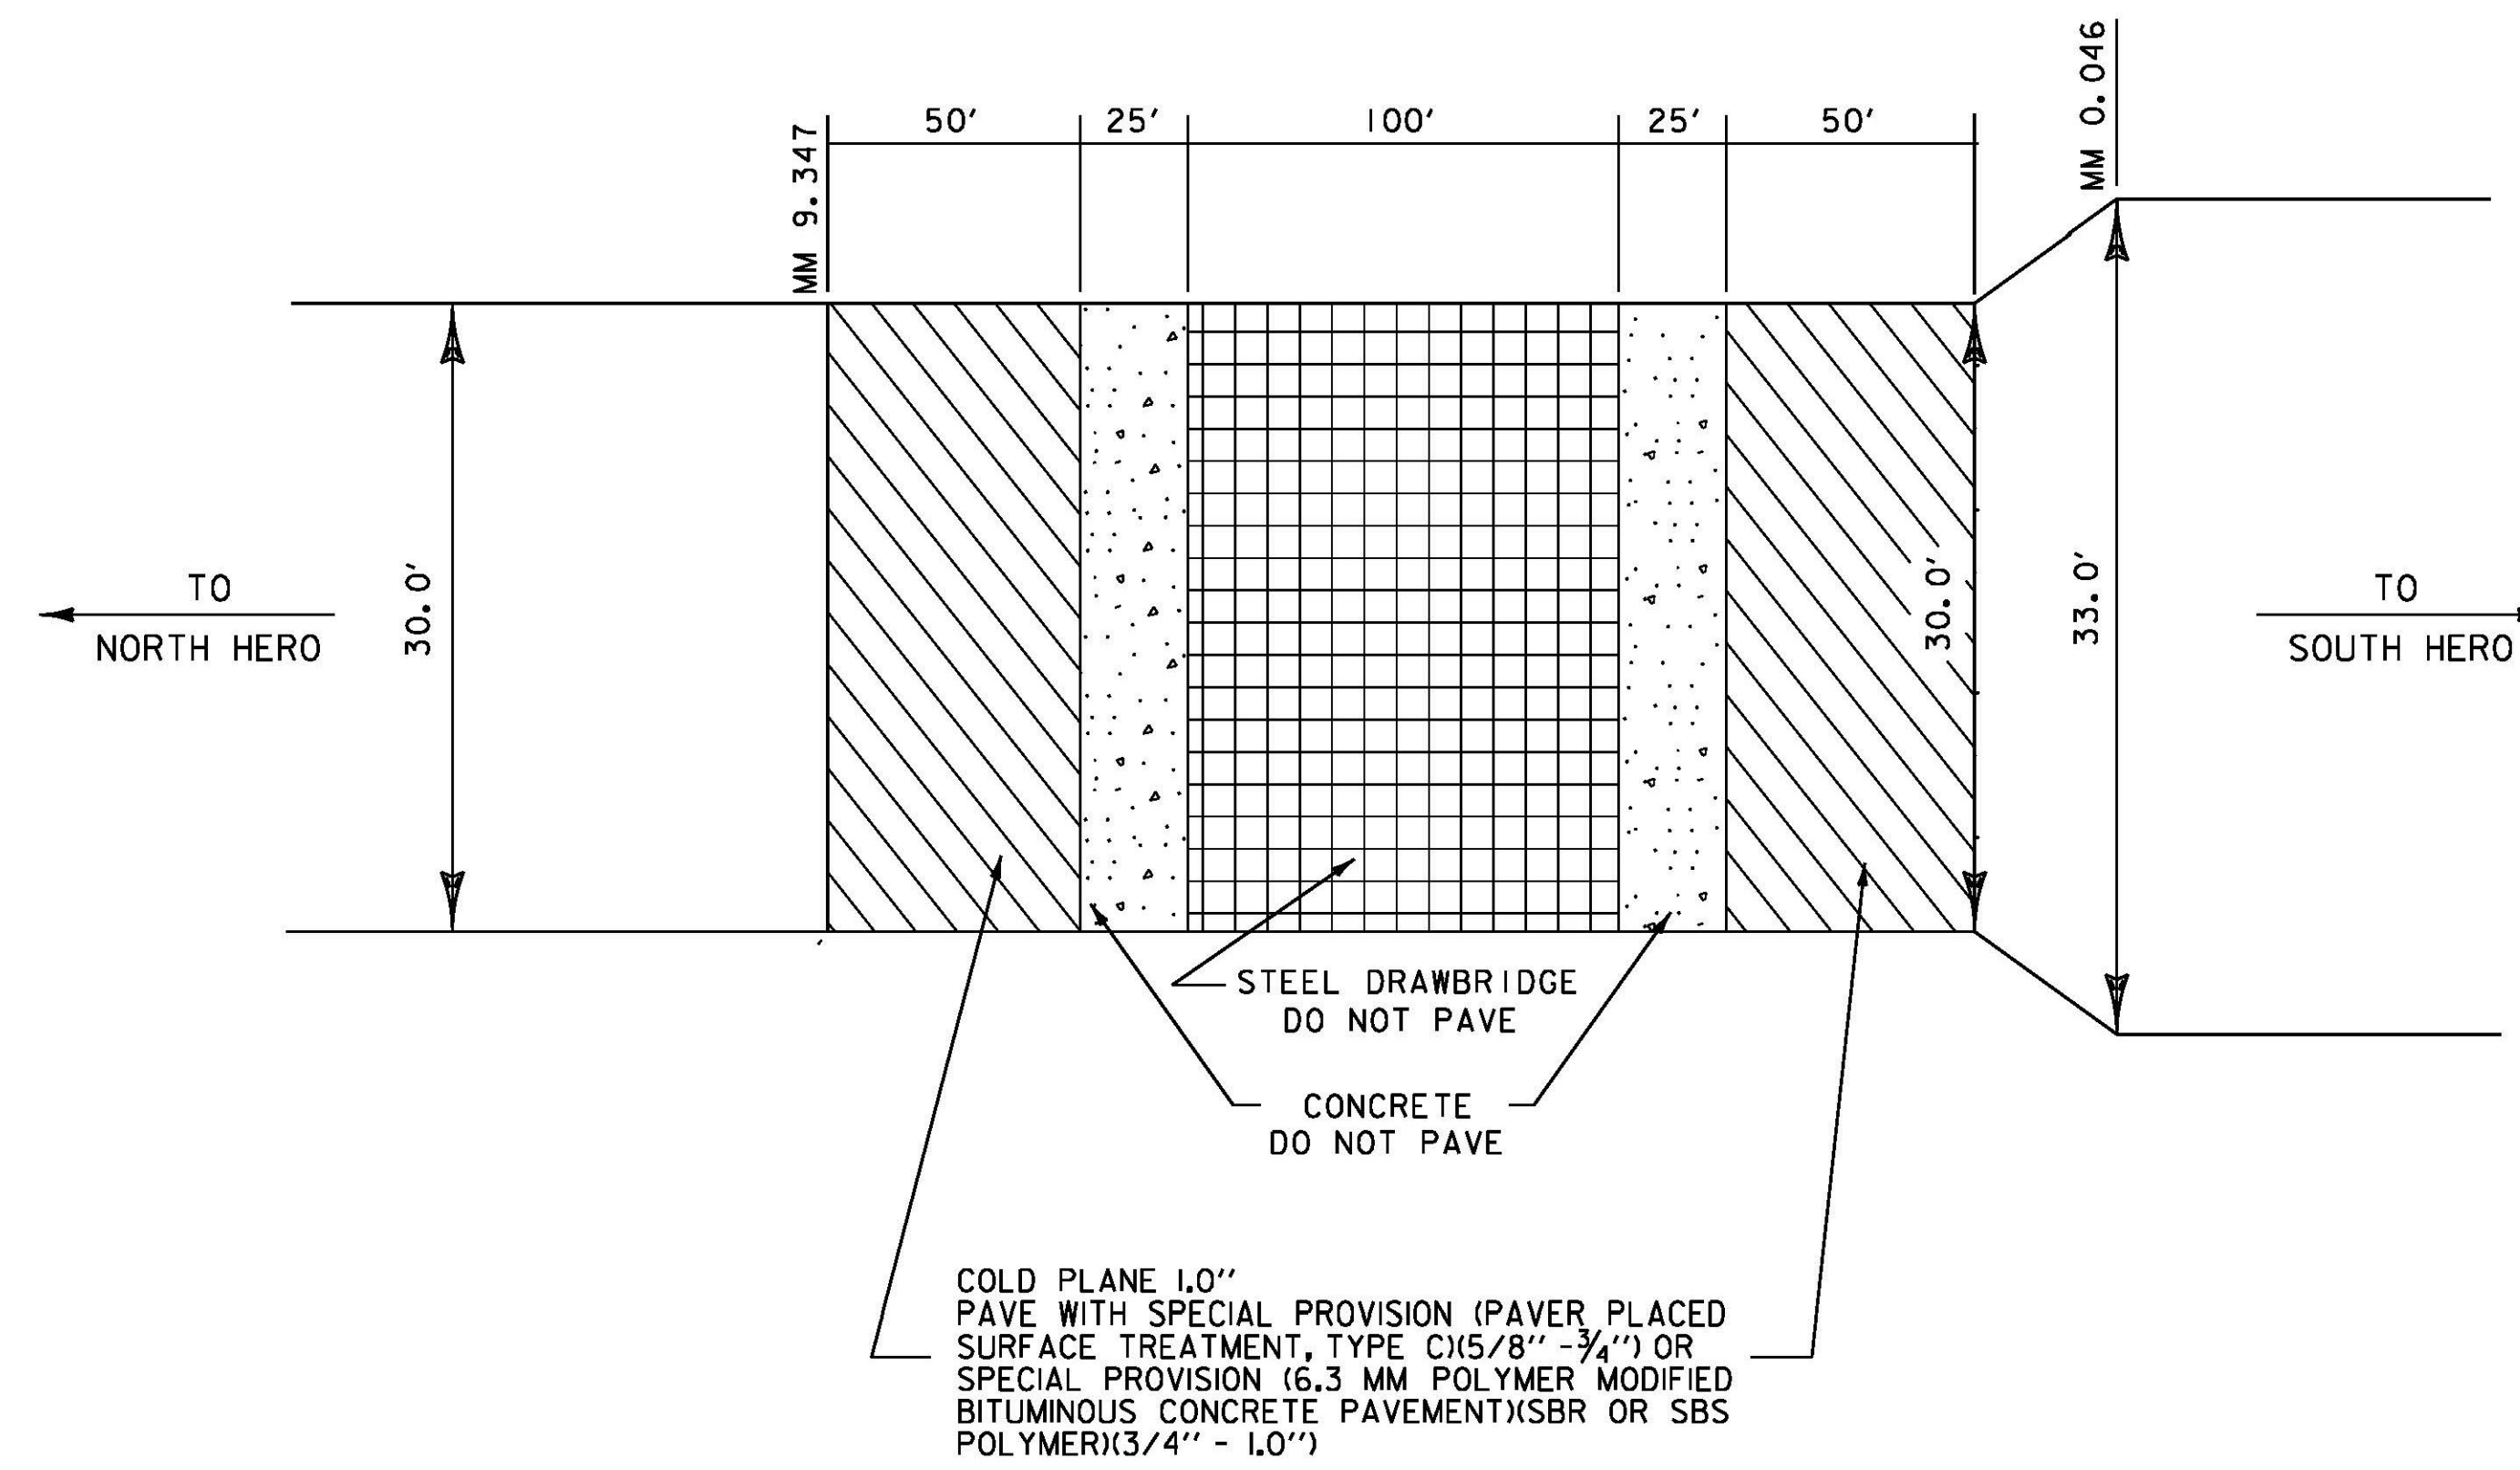

**PAVING DETAIL BRIDGE NO. 8**

U.S. ROUTE 2 GRAND ISLE MM 0.019

**NOT TO SCALE**

**GRAND ISLE  
DETAIL  
SHEET 2**

PROJECT NAME: ALBURGH-COLCHESTER

PROJECT NUMBER: STP SURF(36)

FILE NAME: I2b322.dgn

PROJECT LEADER: FOWLER

DESIGNED BY: PVT. MGT.

I2b322glds02.1

PLOT DATE: 25-APR-2013

DRAWN BY: PVT. MGT.

CHECKED BY: PVT. MGT.

SHEET 48 OF 70