

DURABLE 4 INCH WHITE LINE, POLYUREA
 MM 3.914 TO 4.225, SOLID LT. & RT.
 (WITH EDGELINE BREAK FOR KB BEES POINT RD)
 MM 3.914 TO 4.225, DASHED RT.
 MM 4.090 TO 4.225, DASHED LT.
 MM 4.062 LT. (KB BEES POINT RD EDGELINES)

DURABLE 4 INCH YELLOW LINE, POLYUREA
 MM 3.914 TO 4.225, SOLID LT. & RT.
 (WITH CENTERLINE BREAK FOR KB BEES POINT RD)
 MM 4.062, LT. (KB BEES POINT RD CENTERLINE)

DURABLE LETTER OR SYMBOL, POLYUREA
 MM 4.062, LT. - "STOP"

DURABLE 24 INCH STOP BAR, POLYUREA
 MM 4.062, LT.


TEMPORARY 4 INCH WHITE LINE
 MM 3.914 TO 4.225, SOLID LT. & RT.
 (WITH EDGELINE BREAK FOR KB BEES POINT RD)
 MM 3.914 TO 4.225, DASHED RT.
 MM 4.090 TO 4.225, DASHED LT.
 MM 4.062 LT. (KB BEES POINT RD EDGELINES)

TEMPORARY 4 INCH YELLOW LINE
 MM 3.914 TO 4.225, SOLID LT. & RT.
 (WITH CENTERLINE BREAK FOR KB BEES POINT RD)
 MM 4.062, LT. (KB BEES POINT RD CENTERLINE)

TEMPORARY LETTER OR SYMBOL
 MM 4.062, LT. - "STOP"

TEMPORARY 24 INCH STOP BAR
 MM 4.062, LT.

CHANGING ELEVATION OF DI'S, CB'S OR MH'S
 MM 3.929, RT. - DI

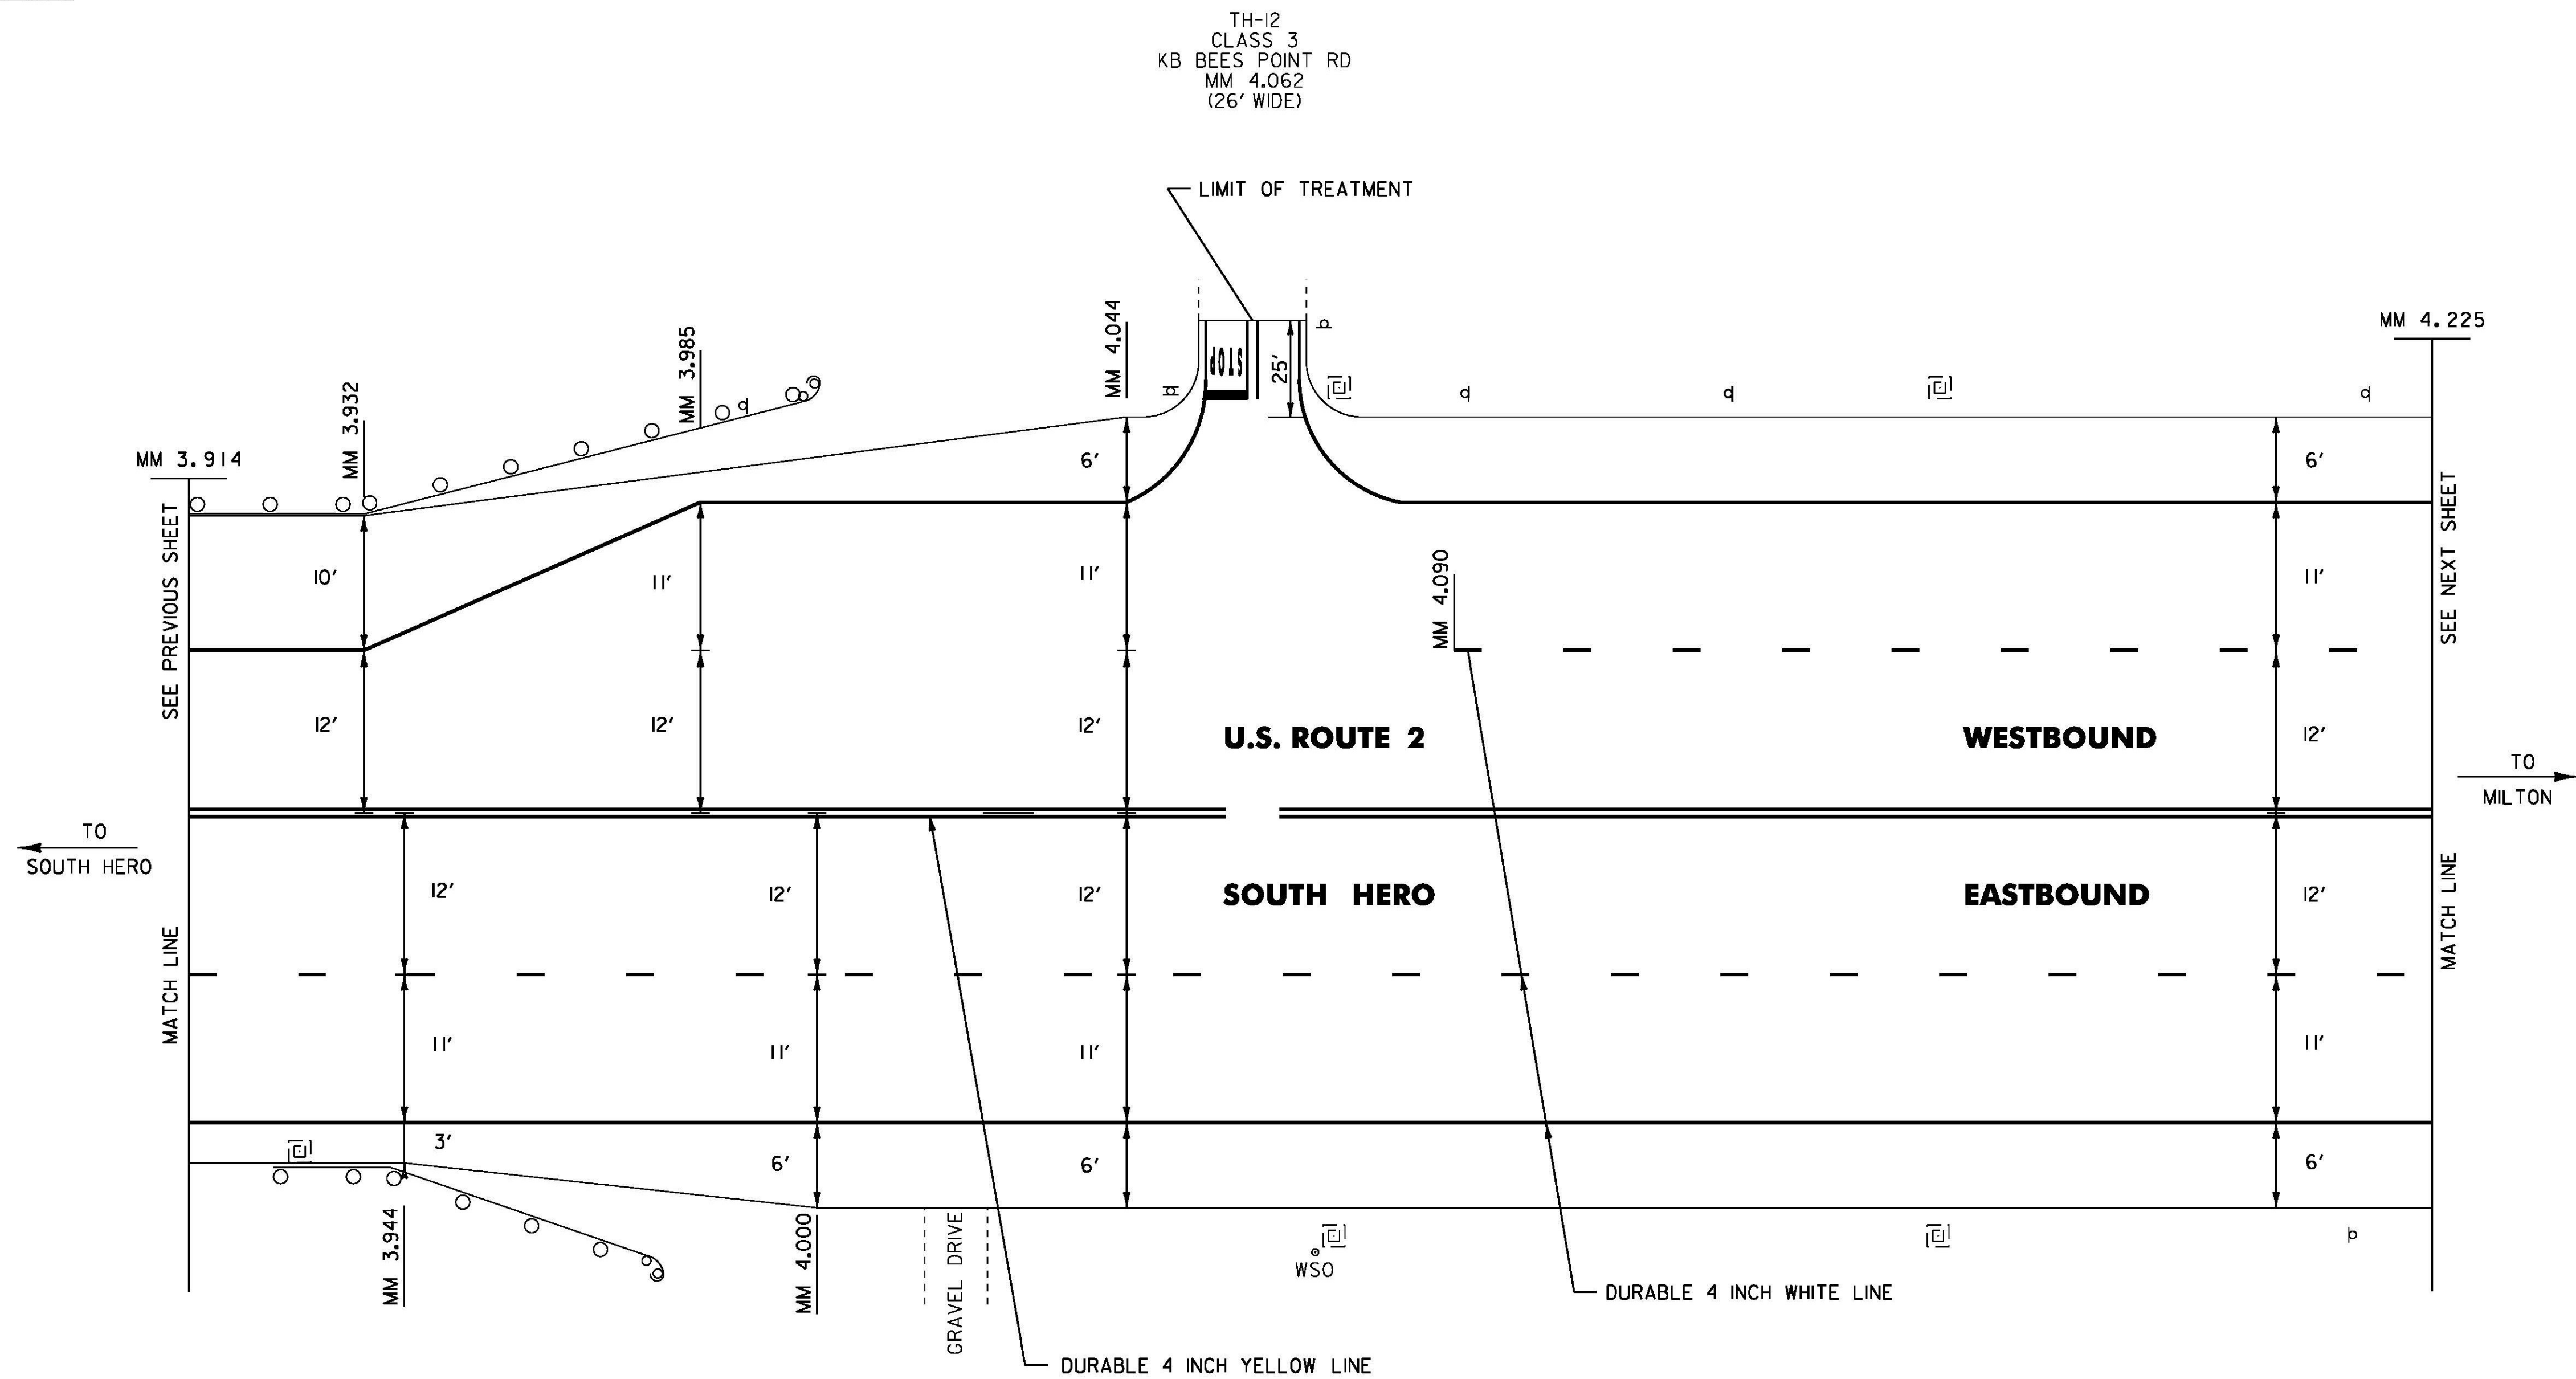

**SOUTH HERO
 DETAIL
 SHEET 4**

PROJECT NAME: ALBURGH-COLCHESTER	PLOT DATE: 25-APR-2013
PROJECT NUMBER: STP SURF(36)	DRAWN BY: PVT. MGT.
FILE NAME: I2b322.dgn	CHECKED BY: PVT. MGT.
DESIGNED BY: PVT. MGT.	SHEET 52 OF 70
I2b322shds04.1	