

DURABLE 4 INCH WHITE LINE, POLYUREA
 (MILTON) MM 3.510 TO 3.686, SOLID LT. & RT.
 (WITH EDGELINE BREAK FOR TH-104)
 (MILTON) MM 3.592, LT. (TH-104 EDGELINES)
 (COLCHESTER) MM 0.000 TO 0.186, SOLID LT. & RT.

DURABLE 4 INCH YELLOW LINE, POLYUREA
 (MILTON) MM 3.510 TO 3.609, SOLID LT. RT.
 (WITH CENTERLINE BREAK FOR TH-104)
 (MILTON) MM 3.609 TO 3.680, SOLID LT. / DASHED RT.
 (MILTON) MM 3.680 TO 3.686, DASHED CENTERLINE
 (COLCHESTER) MM 0.000 TO 0.035, DASHED CENTERLINE
 (COLCHESTER) MM 0.035 TO 0.150, DASHED RT. / SOLID LT.
 (COLCHESTER) MM 0.150 TO 0.186, SOLID LT. & RT.

DURABLE 24 INCH STOP BAR, POLYUREA
 MM 3.592, LT.

DURABLE LETTER OR SYMBOL, POLYUREA
 MM 3.592, LT. - "STOP"


TEMPORARY 4 INCH WHITE LINE
 (MILTON) MM 3.510 TO 3.686, SOLID LT. & RT.
 (WITH EDGELINE BREAK FOR TH-104)
 (MILTON) MM 3.592, LT. (TH-104 EDGELINES)
 (COLCHESTER) MM 0.000 TO 0.186, SOLID LT. & RT.

TEMPORARY 4 INCH YELLOW LINE
 (MILTON) MM 3.510 TO 3.609, SOLID LT. RT.
 (WITH CENTERLINE BREAK FOR TH-104)
 (MILTON) MM 3.609 TO 3.680, SOLID LT. / DASHED RT.
 (MILTON) MM 3.680 TO 3.686, DASHED CENTERLINE
 (COLCHESTER) MM 0.000 TO 0.035, DASHED CENTERLINE
 (COLCHESTER) MM 0.035 TO 0.150, DASHED RT. / SOLID LT.
 (COLCHESTER) MM 0.150 TO 0.186, SOLID LT. & RT.

TEMPORARY 24 INCH STOP BAR
 MM 3.592, LT.

TEMPORARY LETTER OR SYMBOL
 MM 3.592, LT. - "STOP"

**MILTON - COLCHESTER TOWN LINE
 CHITTENDEN COUNTY
 (MILTON) MM 3.686
 (COLCHESTER) MM 0.000**

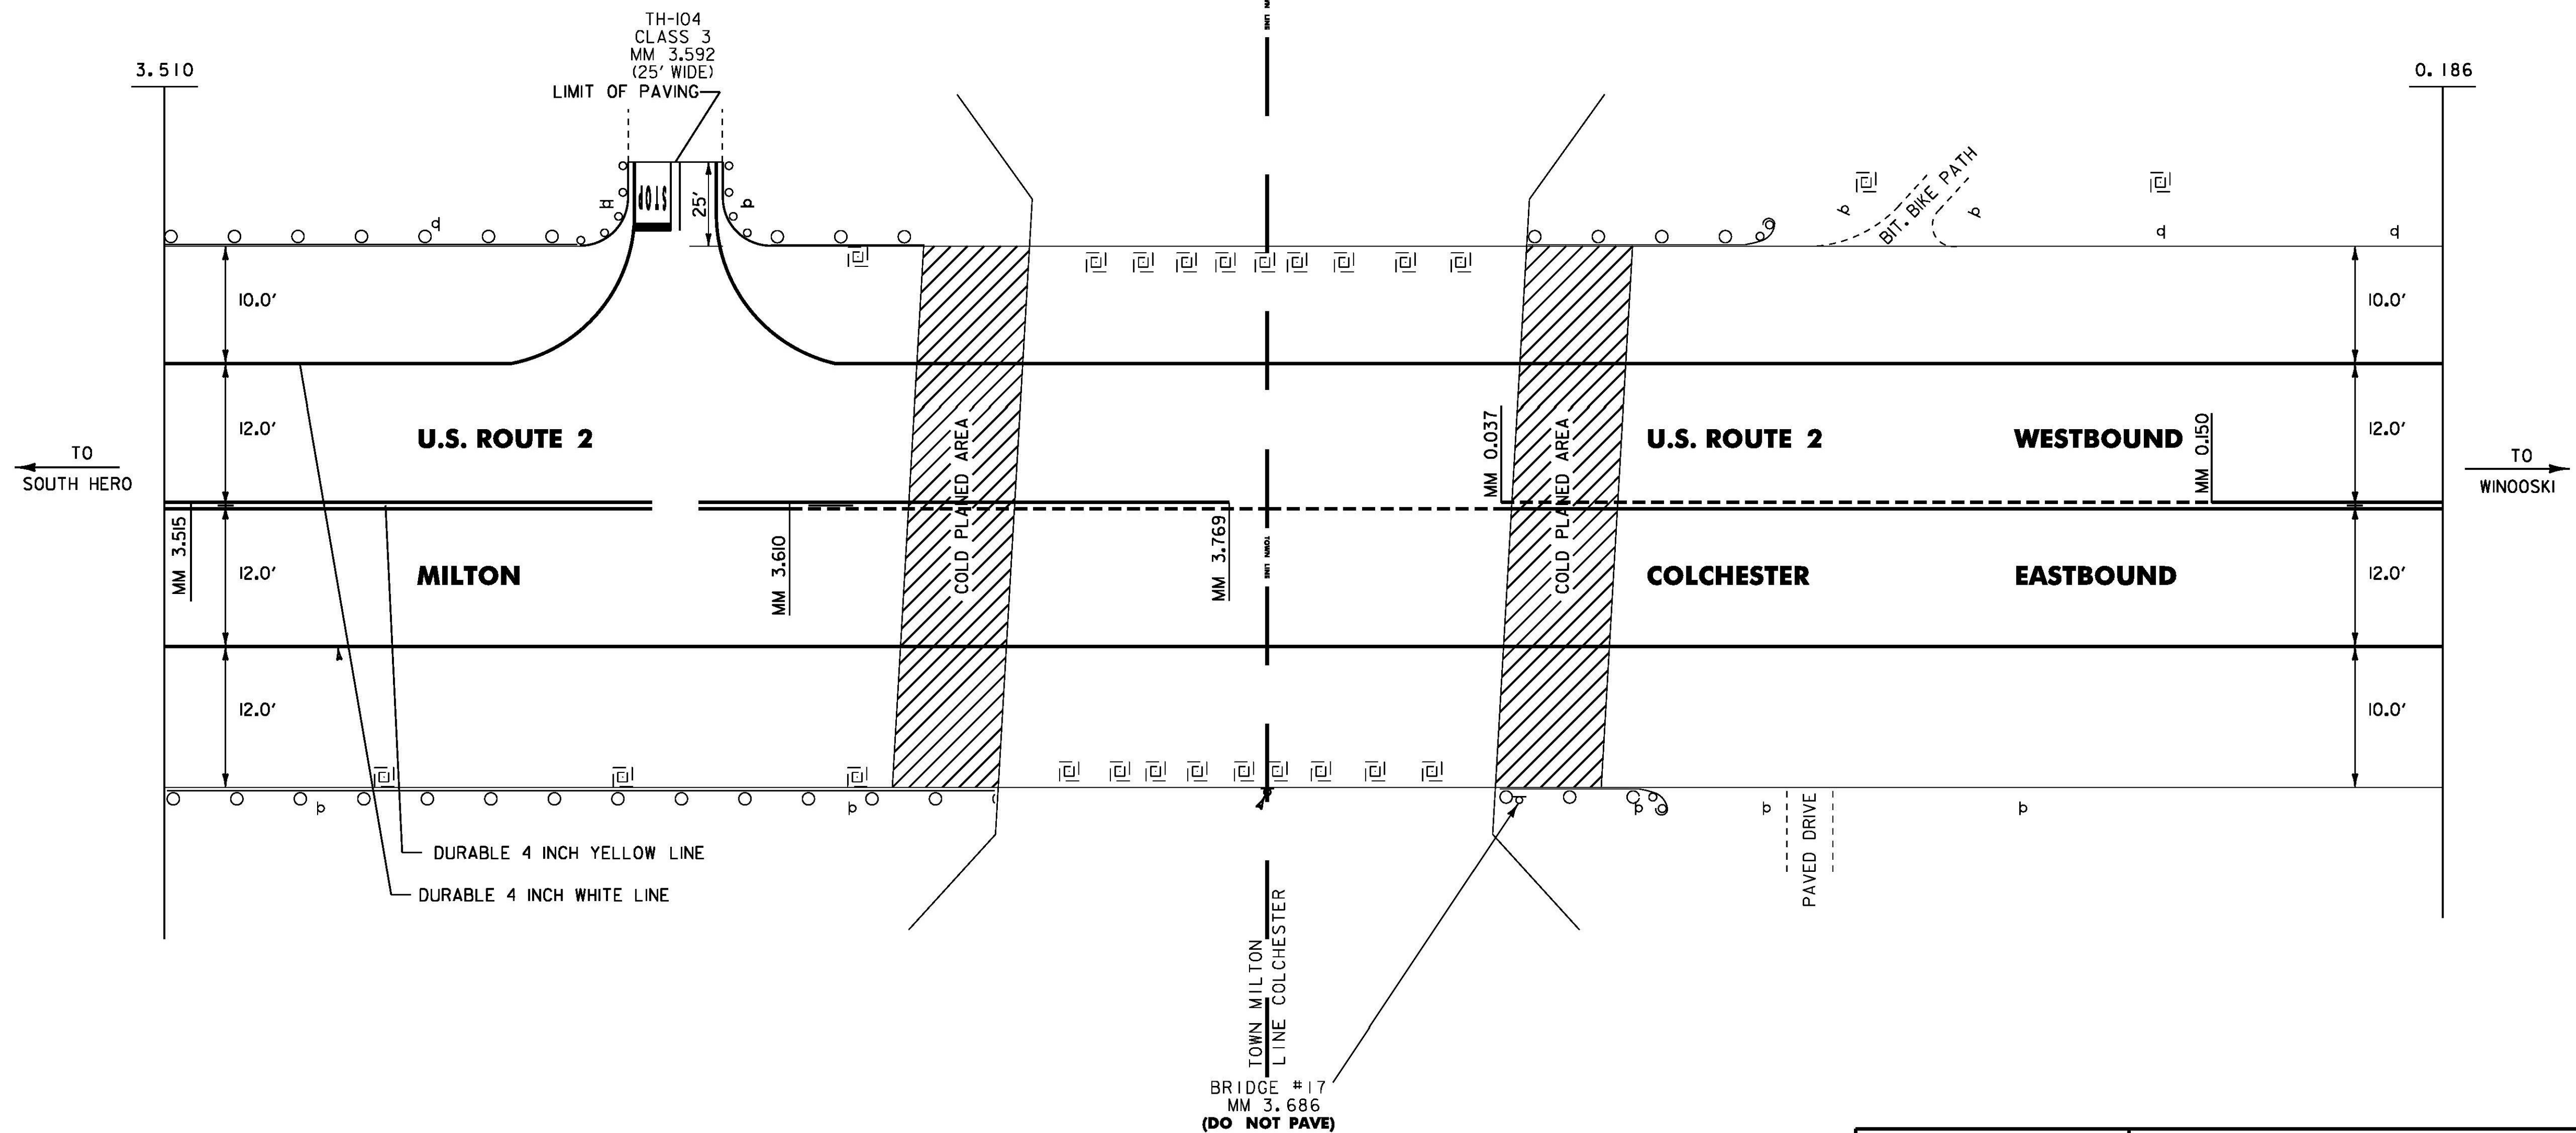

NOT TO SCALE

**MILTON
 DETAIL
 SHEET 3**

PROJECT NAME: ALBURGH-COLCHESTER
 PROJECT NUMBER: STP SURF(36)

FILE NAME: I2b322.dgn
 PROJECT LEADER: FOWLER
 DESIGNED BY: PVT. MGT.
 I2b322m04.1

PLOT DATE: 25-APR-2013
 DRAWN BY: PVT. MGT.
 CHECKED BY: PVT. MGT.
 SHEET 60 OF 70