

DURABLE 4 INCH WHITE LINE, POLYUREA
 MM 0.273 TO 0.359, SOLID LT. & RT.
 MM 0.291 TO 0.324, DOTTED RT.
 MM 0.324 TO 0.359, SOLID RT. (LANE LINE)


DURABLE 4 INCH YELLOW LINE, POLYUREA
 MM 0.273 TO 0.359, SOLID LT. & RT.

DURABLE LETTER OR SYMBOL, POLYUREA
 MM 0.325, RT. - "ALL"
 MM 0.327, RT. - "TURNS"

TEMPORARY 4 INCH WHITE LINE
 MM 0.273 TO 0.359, SOLID LT. & RT.
 MM 0.291 TO 0.324, DOTTED RT.
 MM 0.324 TO 0.359, SOLID RT. (LANE LINE)

TEMPORARY 4 INCH YELLOW LINE
 MM 0.273 TO 0.359, SOLID LT. & RT.

TEMPORARY LETTER OR SYMBOL
 MM 0.325, RT. - "ALL"
 MM 0.327, RT. - "TURNS"

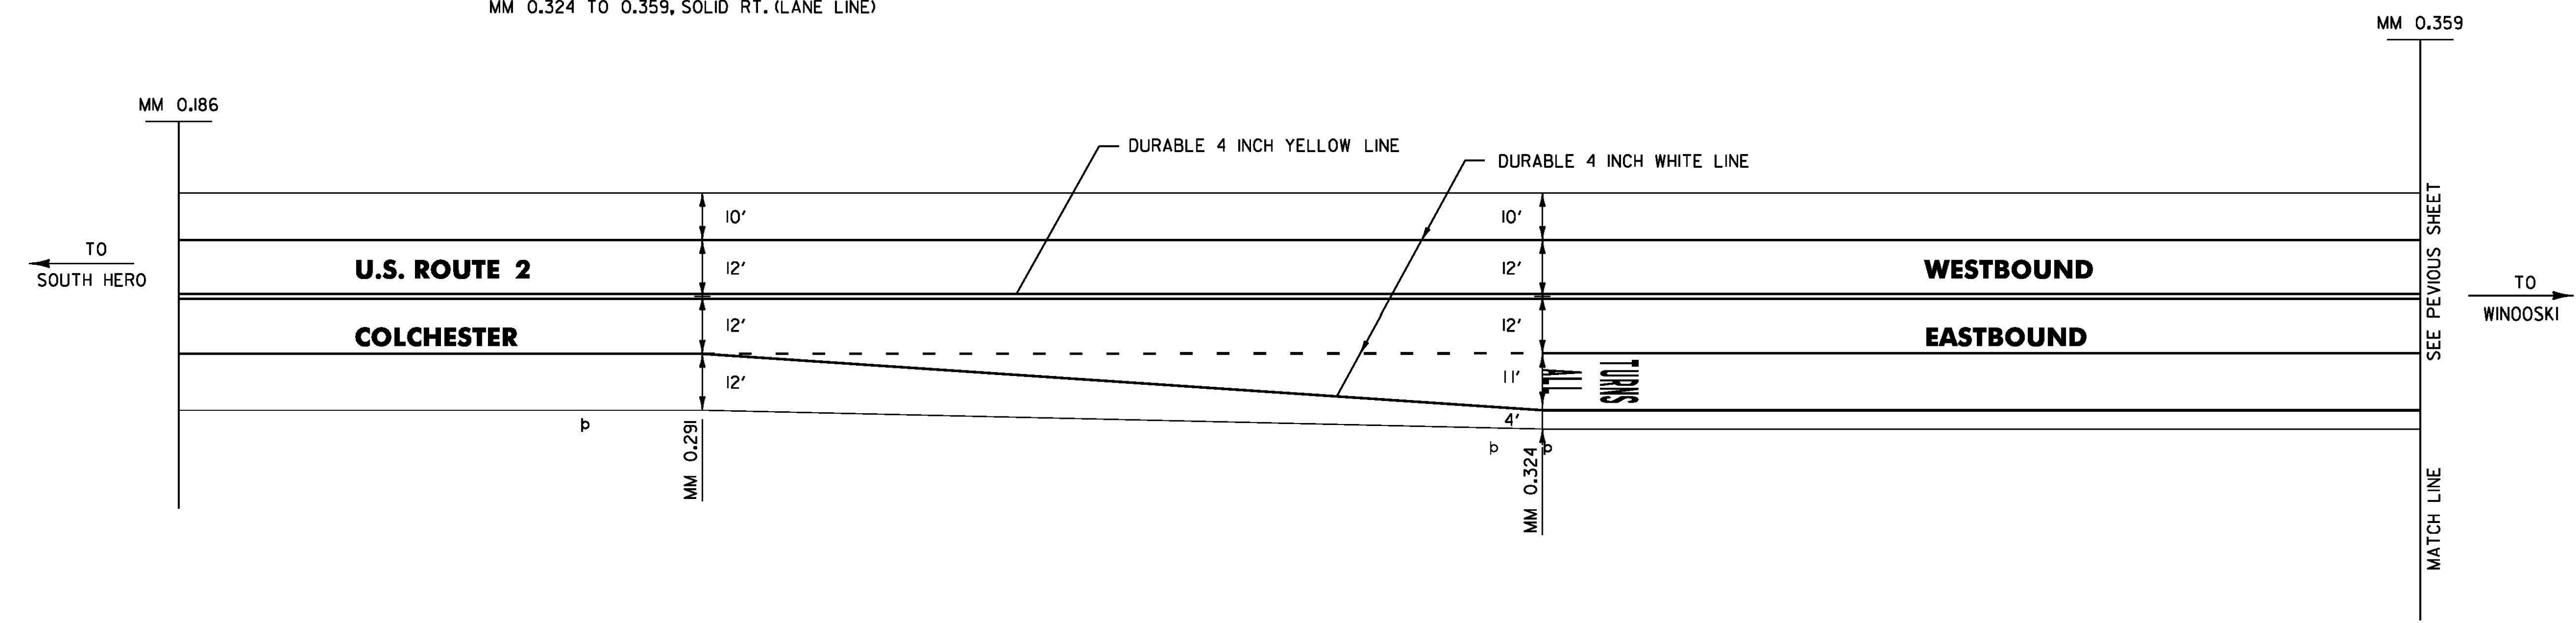

DURABLE 4 INCH WHITE LINE, POLYUREA
 MM 0.468 TO 0.567, SOLID LT. & RT.
 MM 0.486 TO 0.518, SOLID LT. (LANE LINE)
 MM 0.518 TO 0.567, DOTTED LT.


DURABLE 4 INCH YELLOW LINE, POLYUREA
 MM 0.468 TO 0.567, SOLID LT. & RT.

DURABLE LETTER OR SYMBOL, POLYUREA
 MM 0.476, LT. - "TURNS"
 MM 0.478, LT. - "ALL"
 MM 0.515, LT. - "TURNS"
 MM 0.516, LT. - "ALL"

TEMPORARY 4 INCH WHITE LINE
 MM 0.468 TO 0.567, SOLID LT. & RT.
 MM 0.486 TO 0.518, SOLID LT. (LANE LINE)
 MM 0.518 TO 0.567, DOTTED LT.

TEMPORARY 4 INCH YELLOW LINE
 MM 0.468 TO 0.567, SOLID LT. & RT.

TEMPORARY LETTER OR SYMBOL
 MM 0.476, LT. - "TURNS"
 MM 0.478, LT. - "ALL"
 MM 0.515, LT. - "TURNS"
 MM 0.516, LT. - "ALL"

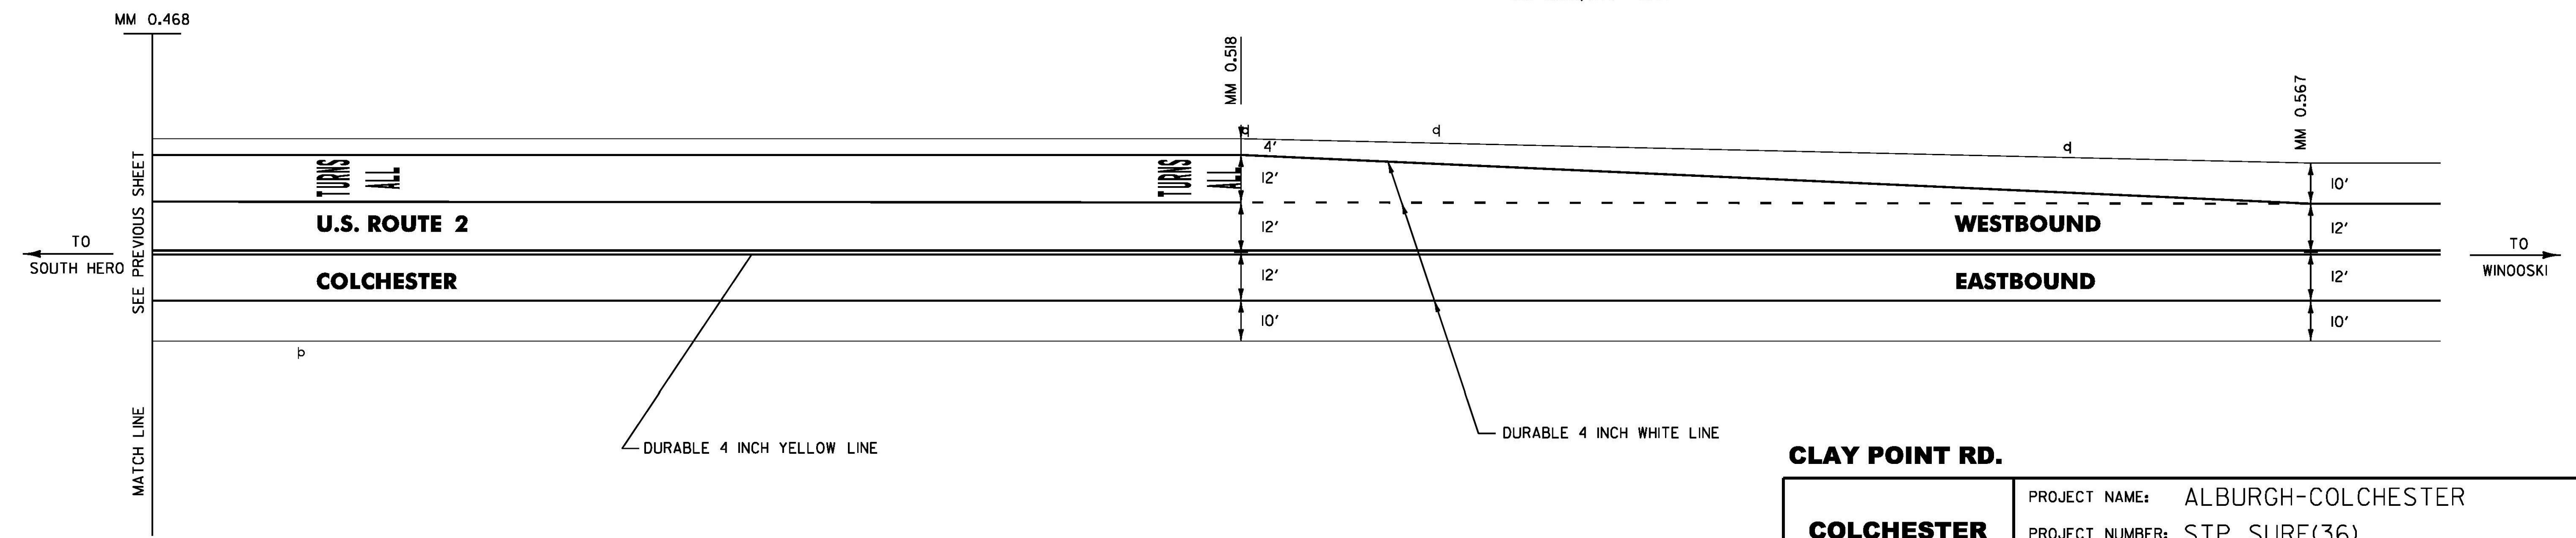

CLAY POINT RD.

**COLCHESTER
 DETAIL
 SHEET 2**

NOT TO SCALE

PROJECT NAME: ALBURGH-COLCHESTER	PLOT DATE: 25-APR-2013
PROJECT NUMBER: STP SURF(36)	DRAWN BY: PVT. MGT.
FILE NAME: I2b322.dgn	CHECKED BY: PVT. MGT.
PROJECT LEADER: FOWLER	SHEET 62 OF 70
DESIGNED BY: PVT. MGT.	
I2b322cds05.1	