

DURABLE 4 INCH WHITE LINE, POLYUREA  
 MM 0.900 TO 0.987, SOLID LT. & RT.  
 MM 0.900 TO 0.946, DOTTED RT.  
 MM 0.946 TO 0.987, SOLID RT. (LANE LINE)


DURABLE 4 INCH YELLOW LINE, POLYUREA  
 MM 0.900 TO 0.989, SOLID LT. & RT.

DURABLE LETTER OR SYMBOL, POLYUREA  
 MM 0.946, RT. - "ALL"  
 MM 0.948, RT. - "TURNS"

TEMPORARY 4 INCH WHITE LINE  
 MM 0.900 TO 0.987, SOLID LT. & RT.  
 MM 0.900 TO 0.946, DOTTED RT.  
 MM 0.946 TO 0.987, SOLID RT. (LANE LINE)

TEMPORARY 4 INCH YELLOW LINE  
 MM 0.900 TO 0.989, SOLID LT. & RT.


TEMPORARY LETTER OR SYMBOL  
 MM 0.946, RT. - "ALL"  
 MM 0.948, RT. - "TURNS"

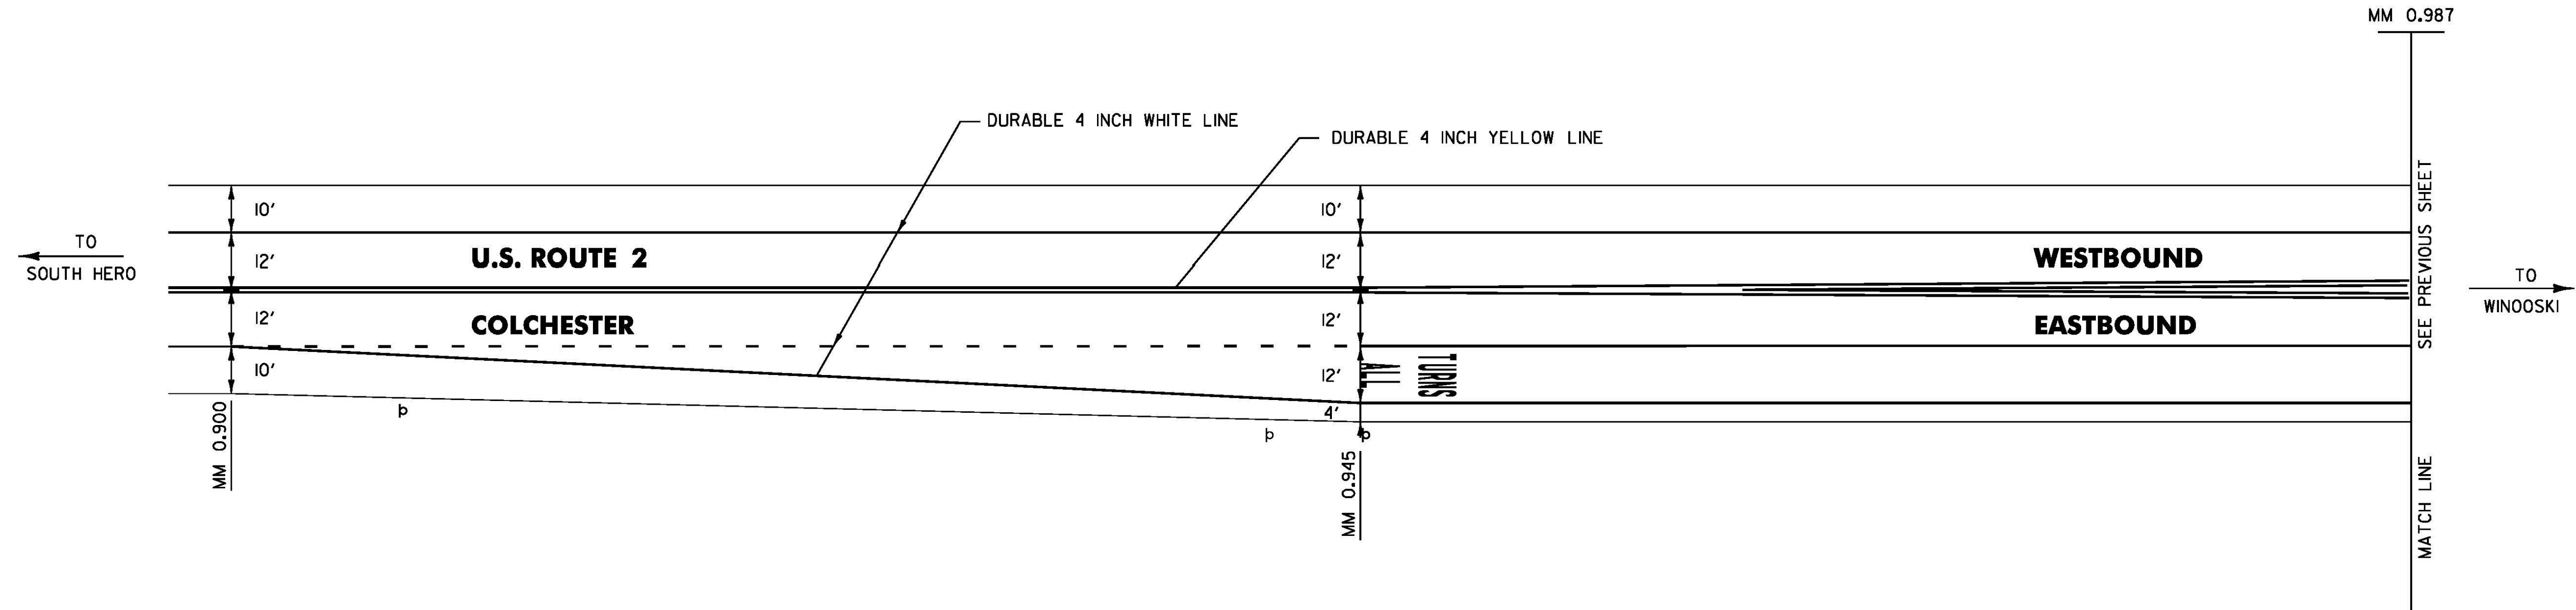

DURABLE 4 INCH WHITE LINE, POLYUREA  
 MM 1.096 TO 1.191, SOLID LT. & RT.  
 MM 1.096 TO 1.147, SOLID LT. (LANE LINE)  
 MM 1.147 TO 1.191, DOTTED LT.

DURABLE 4 INCH YELLOW LINE, POLYUREA  
 MM 1.096 TO 1.191, SOLID LT. & RT.

DURABLE LETTER OR SYMBOL, POLYUREA  
 MM 1.104, LT. - "TURNS"  
 MM 1.106, LT. - "ALL"  
 MM 1.144, LT. - "TURNS"  
 MM 1.147, LT. - "ALL"

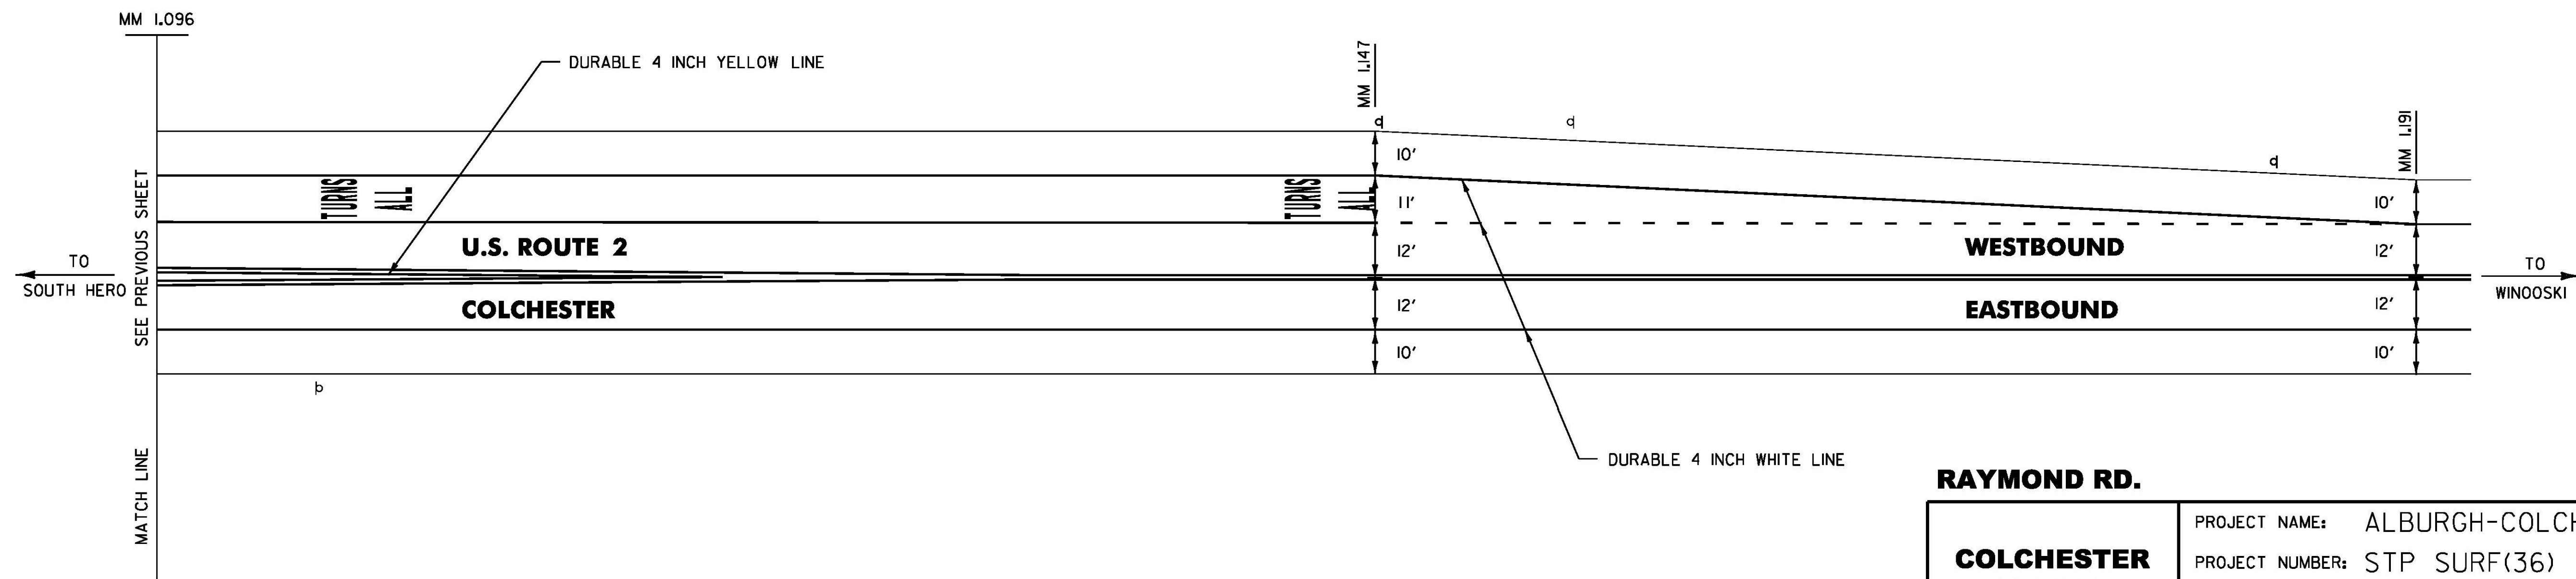

**RAYMOND RD.**

**COLCHESTER  
 DETAIL  
 SHEET 4**

**NOT TO SCALE**

PROJECT NAME:	ALBURGH-COLCHESTER
PROJECT NUMBER:	STP SURF(36)
FILE NAME:	12b322.dgn
PROJECT LEADER:	FOWLER
DESIGNED BY:	PVT. MGT.
12b322cds07.1	
PLOT DATE:	25-APR-2013
DRAWN BY:	PVT. MGT.
CHECKED BY:	PVT. MGT.
SHEET	64 OF 70