

DURABLE 4 INCH WHITE LINE, POLYUREA
 MM 1.541 TO 1.625, SOLID LT. & RT.
 MM 1.541 TO 1.586, DOTTED RT.
 MM 1.586 TO 1.625, SOLID RT. (LANE LINE)


DURABLE 4 INCH YELLOW LINE, POLYUREA
 MM 1.541 TO 1.625, SOLID LT. & RT.

DURABLE LETTER OR SYMBOL, POLYUREA
 MM 1.586, RT. - "ALL"
 MM 1.589, RT. - "TURNS"

TEMPORARY 4 INCH WHITE LINE
 MM 1.541 TO 1.625, SOLID LT. & RT.
 MM 1.541 TO 1.586, DOTTED RT.
 MM 1.586 TO 1.625, SOLID RT. (LANE LINE)

TEMPORARY 4 INCH YELLOW LINE
 MM 1.541 TO 1.625, SOLID LT. & RT.

TEMPORARY LETTER OR SYMBOL
 MM 1.586, RT. - "ALL"
 MM 1.589, RT. - "TURNS"

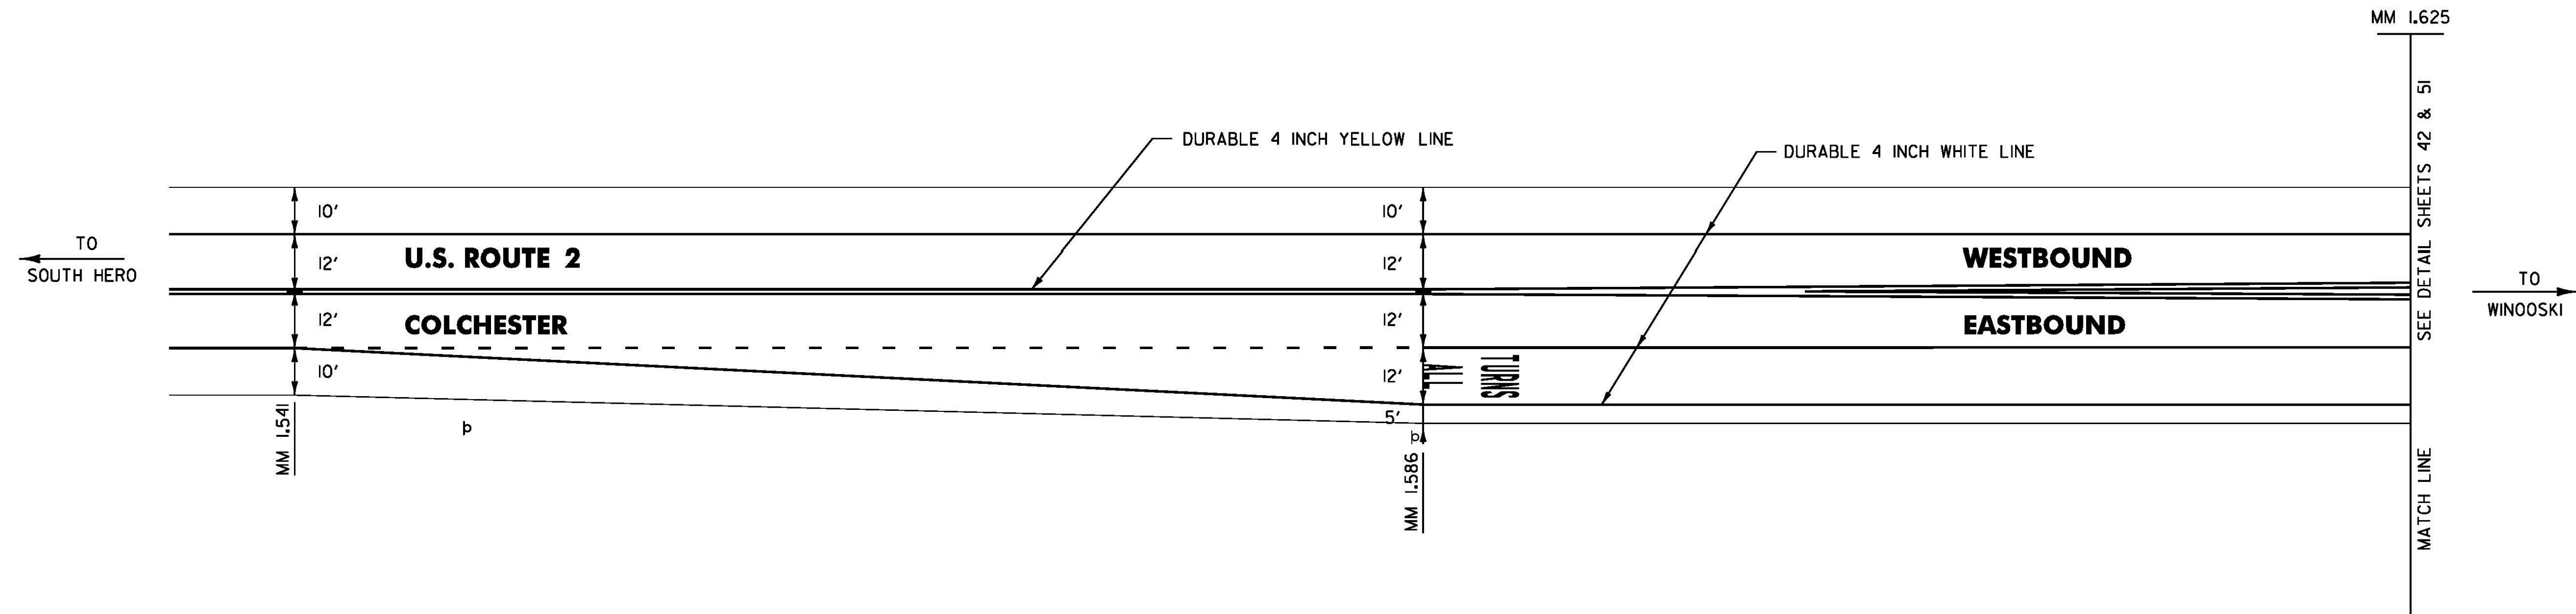


DURABLE 4 INCH WHITE LINE
 MM 1.734 TO 1.778, SOLID LT. & RT.
 MM 1.734 TO 1.778, DOTTED LT.

TEMPORARY 4 INCH WHITE LINE
 MM 1.734 TO 1.778, SOLID LT. & RT.
 MM 1.734 TO 1.778, DOTTED LT.

DURABLE 4 INCH YELLOW LINE
 MM 1.734 TO 1.783, SOLID LT. & RT.

TEMPORARY 4 INCH YELLOW LINE
 MM 1.734 TO 1.783, SOLID LT. & RT.

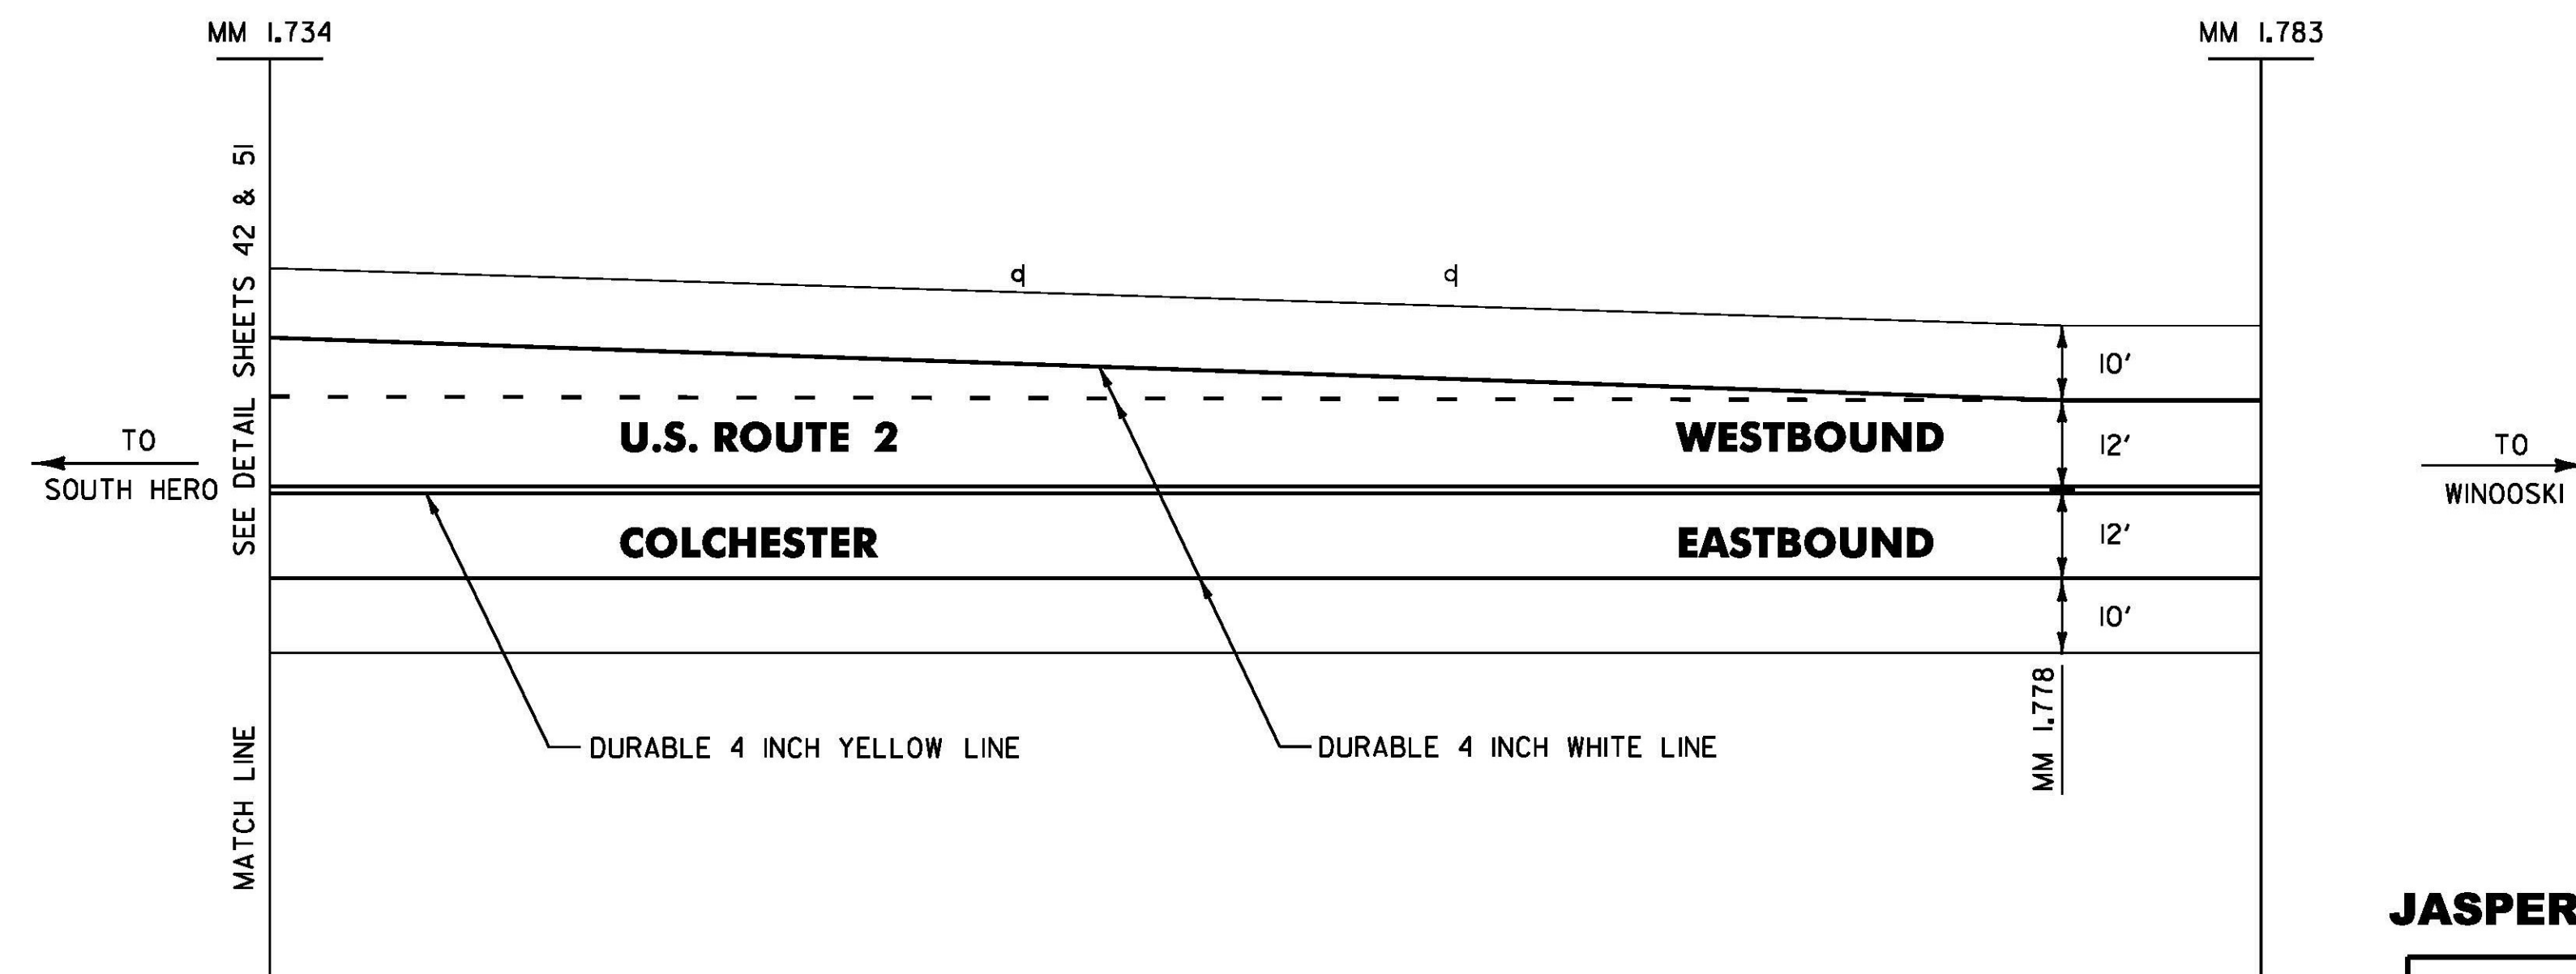

JASPER MINE RD.

**COLCHESTER
 DETAIL
 SHEET 6**

NOT TO SCALE

PROJECT NAME: ALBURGH-COLCHESTER

PROJECT NUMBER: STP SURF(36)

FILE NAME: i2b322.dgn

PROJECT LEADER: FOWLER

DESIGNED BY: PVT. MGT.

i2b322cds09.1

PLOT DATE: 25-APR-2013

DRAWN BY: PVT. MGT.

CHECKED BY: PVT. MGT.

SHEET 66 OF 70