

STATE OF VERMONT AGENCY OF TRANSPORTATION





PROPOSED IMPROVEMENT TOWNS OF BARTON, IRASBURG, COVENTRY, AND DERBY COUNTY OF ORLEANS US RTE 5 (MAJOR COLLECTOR)

BARTON TO DERBY SIGN REPLACEMENT - 24.433 MILES;
BARTON (US-5) MP 0.000-4.870 & 5.984-10.775, IRASBURG (US-5) MP 0.000-4.762,
COVENTRY (US-5) MP 0.000-4.892, DERBY (US-5) MP 0.000-5.118

LENGTH OF ROADWAY = 25.547 MI
LENGTH OF PROJECT = 24.433 MI

WORK TO BE PERFORMED INCLUDES THE REMOVAL OF EXISTING SIGNS AND POSTS
AND THE INSTALLATION OF NEW SIGNS AND POSTS AND OTHER RELATED HIGHWAY ITEMS.

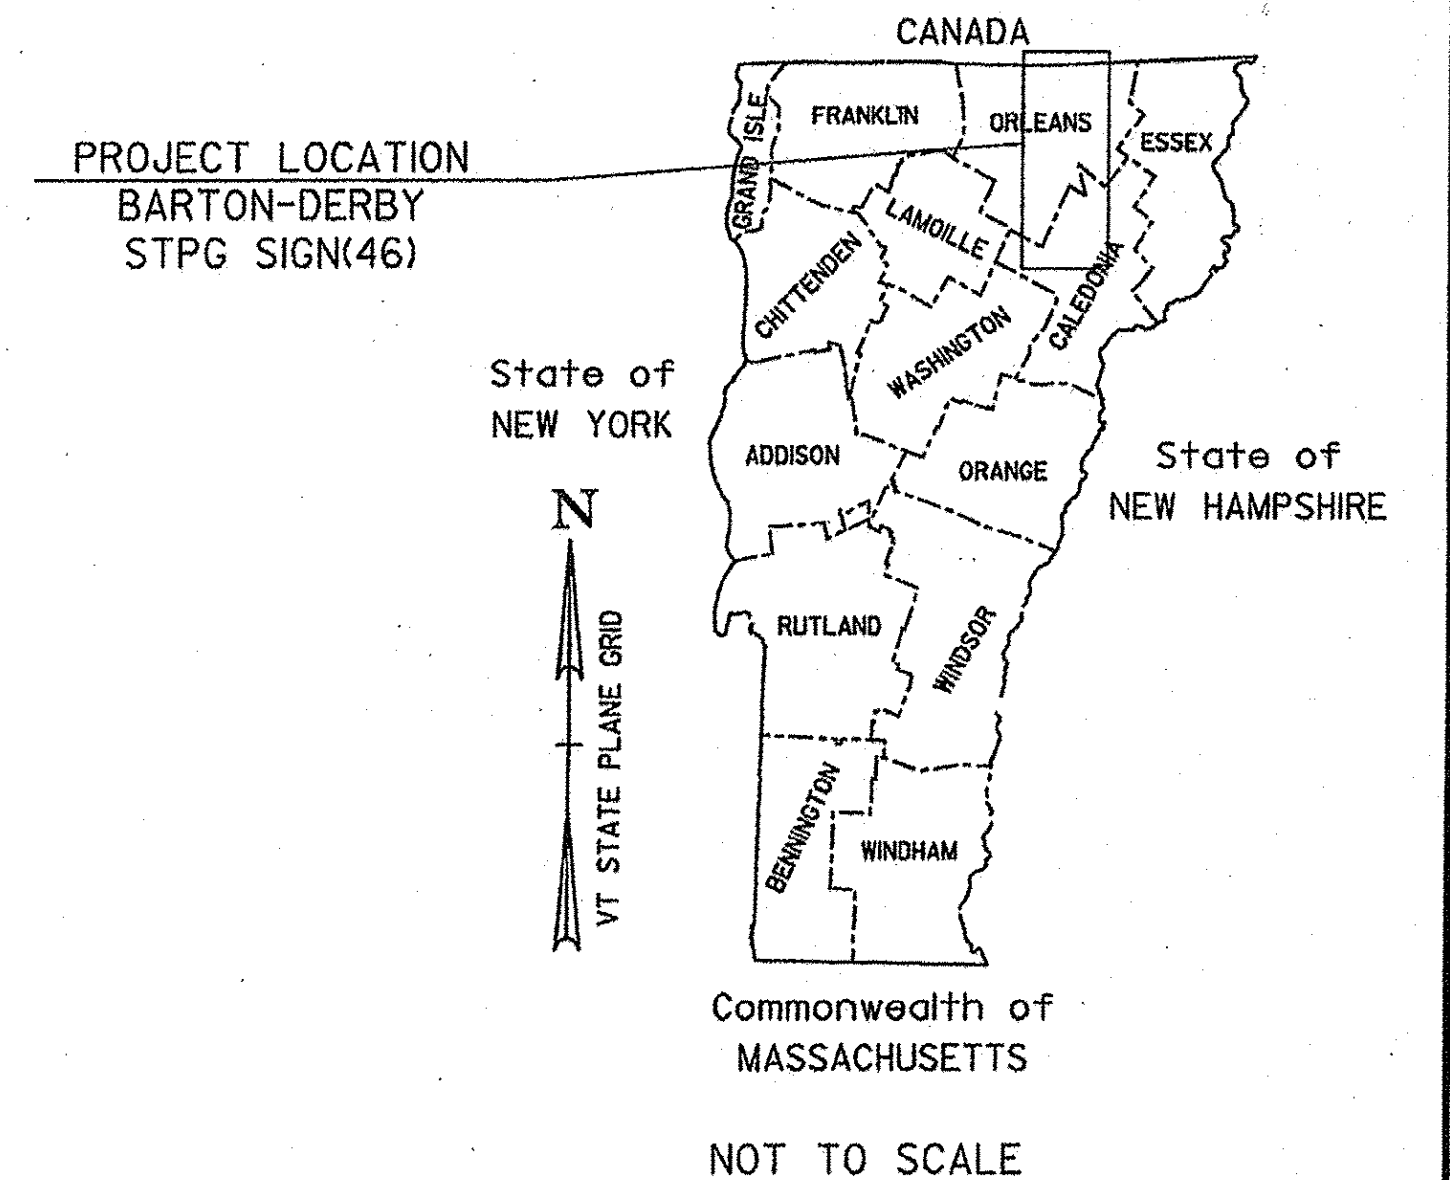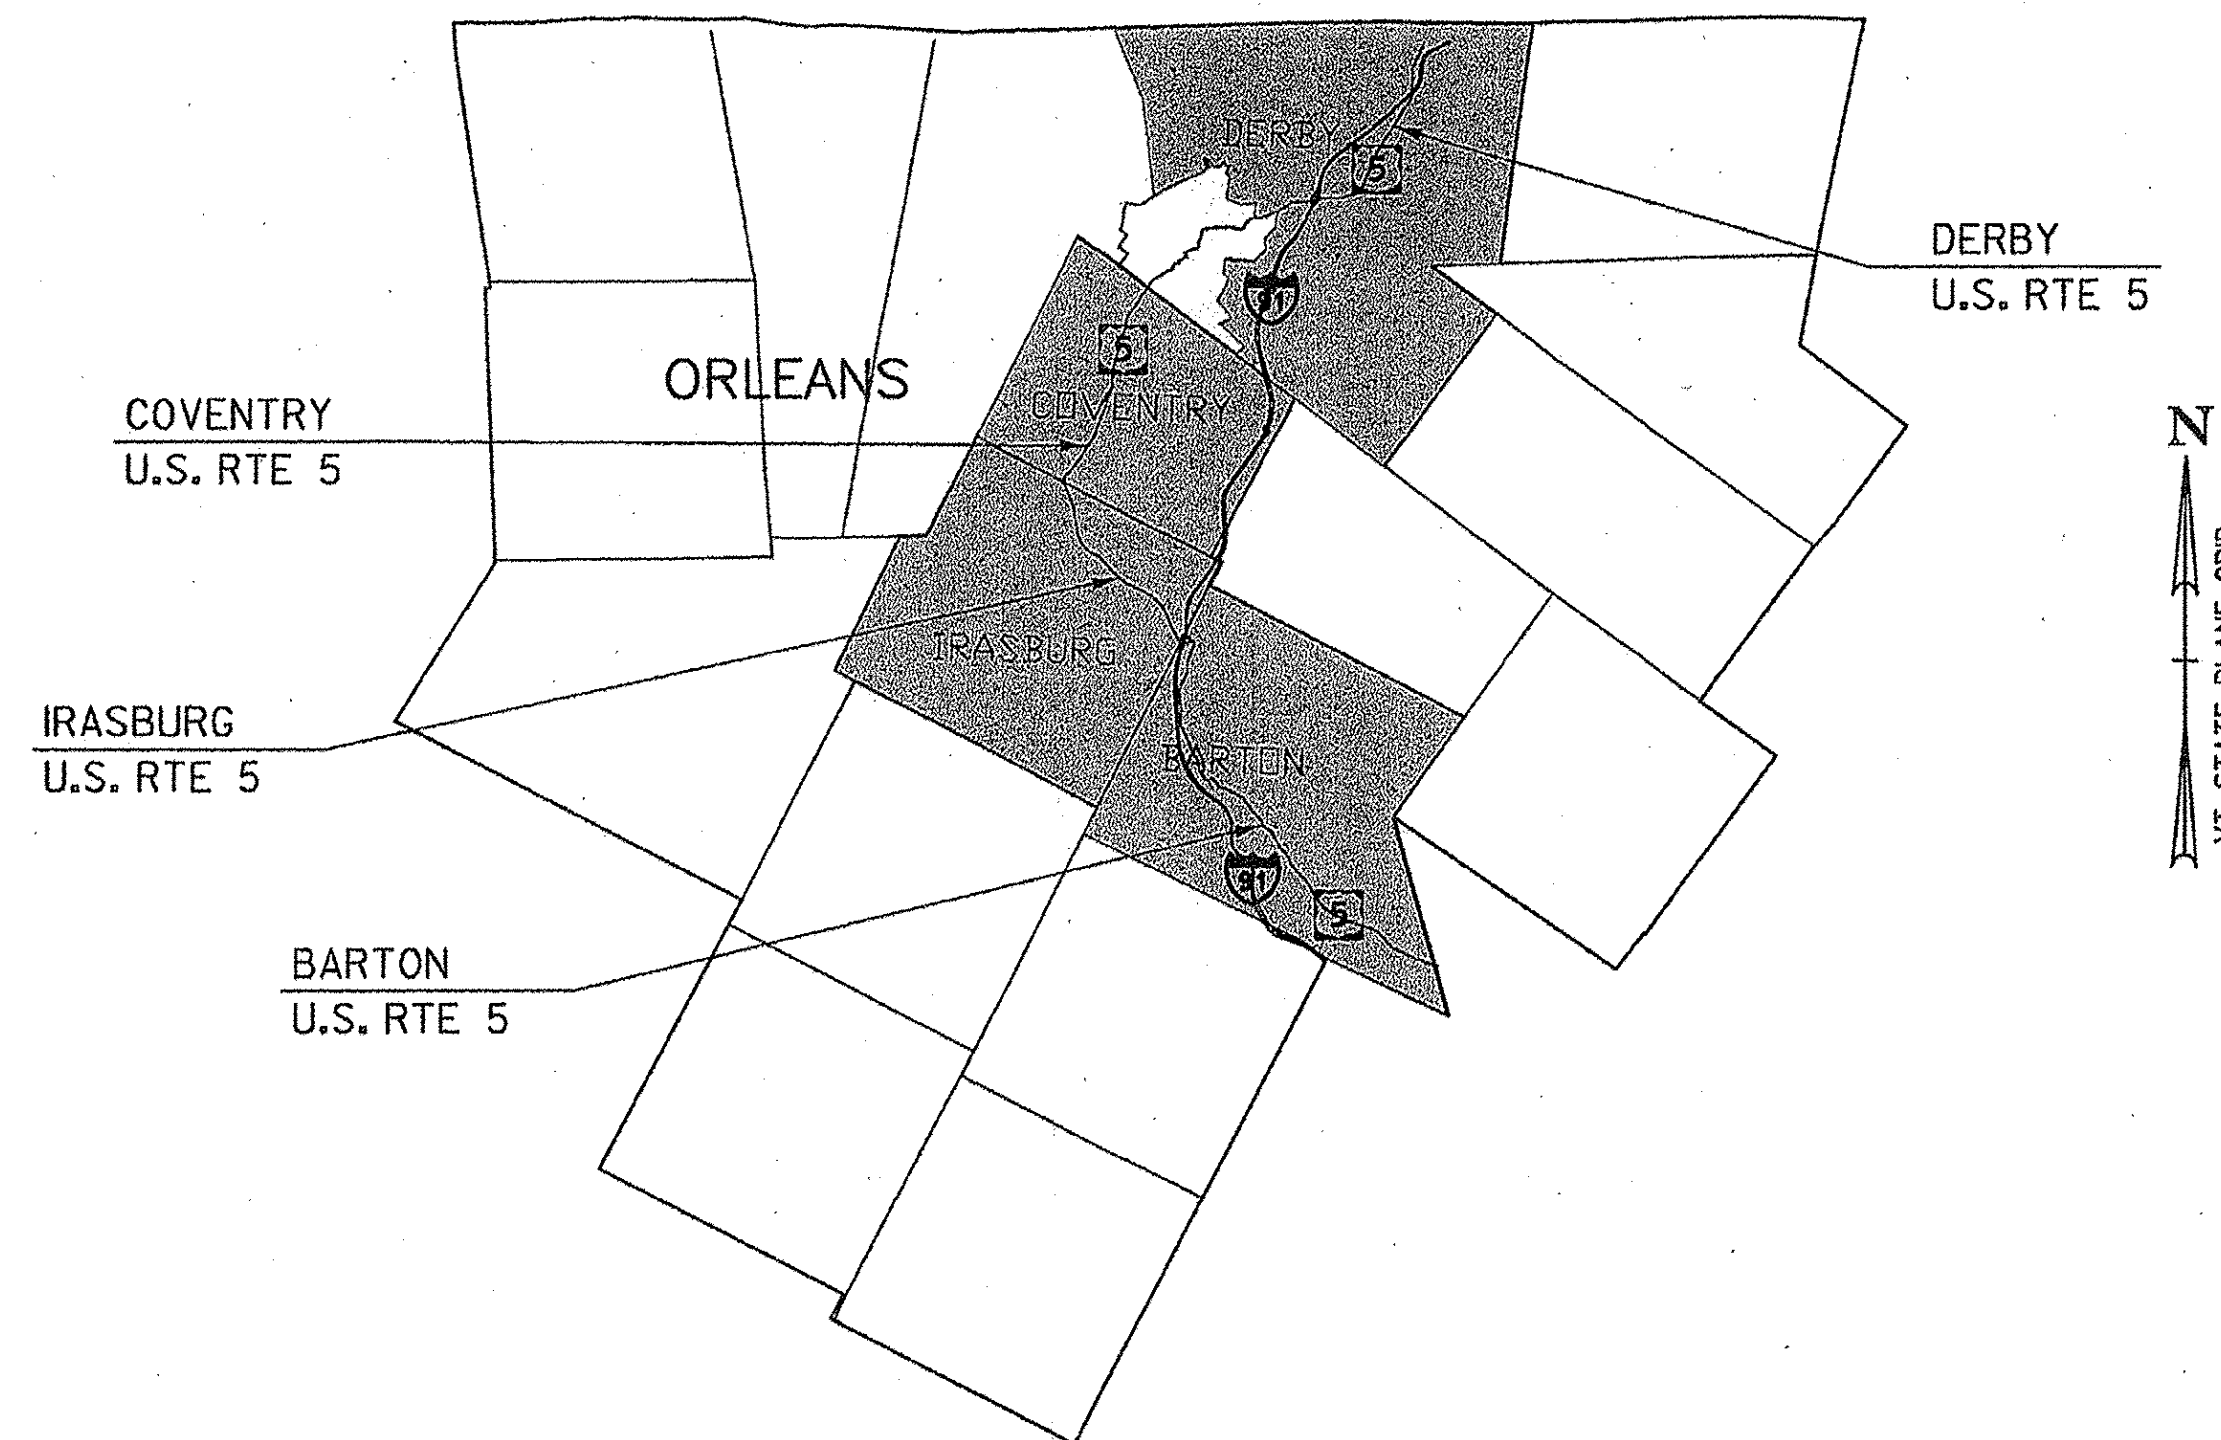

RECORD PLANS	
CONTRACTOR:	L&D SAFETY MARKINGS CORP. - BERLIN, VT
RESIDENT ENGINEER:	JOHN SLADYK
CONSTRUCTION BEGAN:	MAY 5, 2015
CONSTRUCTION COMPLETE:	JUNE 16, 2015
RECORD PLANS BY:	JOHN SLADYK & AARON JAMES
I HEREBY CERTIFY THAT ALL THE CONSTRUCTION REQUIRED BY THIS SET OF DRAWINGS HAS BEEN ACCOMPLISHED AS INDICATED HEREIN.	
BY	RESIDENT ENGINEER
DATE	8-2-16
NOTE: Any further information concerning final quantities, amounts or other details relative to this project may be found at Central Files in the electronic archives.	

CONSTRUCTION IS TO BE CARRIED ON IN ACCORDANCE WITH THESE PLANS AND THE STANDARD SPECIFICATIONS FOR CONSTRUCTION DATED 2011, AS APPROVED BY THE FEDERAL HIGHWAY ADMINISTRATION ON JULY 20, 2011 FOR USE ON THIS PROJECT, INCLUDING ALL SUBSEQUENT REVISIONS AND SUCH REVISED SPECIFICATIONS AND SPECIAL PROVISIONS AS ARE INCORPORATED IN THESE PLANS.

QUALITY ASSURANCE PROGRAM : LEVEL 3	
SURVEYED BY :	N/A
SURVEYED DATE :	N/A
DATUM	
VERTICAL	N/A
HORIZONTAL	N/A

NOT TO SCALE

<p>TYLIN INTERNATIONAL</p>	DIRECTOR OF PROJECT DELIVERY
	APPROVED DATE 11/14/2014
	PROJECT MANAGER : PATTI COBURN, P. E.
	PROJECT NAME : BARTON - DERBY PROJECT NUMBER : STPG SIGN (46)
SHEET 1 OF 100 SHEETS	