






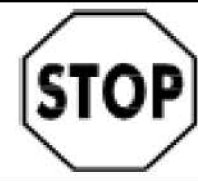

DIRECTION	MILEPOINT	LOCATION CODE (SHEET 2)	SIGN CODE	WIDTH (IN)	HEIGHT (IN)	SHEETING REMARKS	SIGN LEGEND	NEW SIGNS		EXISTING SIGNS			EXIST POST		NUMBER OF NEW POSTS	SQUARE STEEL (IN)			TUBULAR STEEL Ø (IN)				SIGN FRAME REQUIRED	REMARKS	SIGN DETAIL LOCATION				
								"A"	"B"	RETAIN	SALVAGE FROM	SALVAGE TO	REMOVE	RETAIN		REMOVE	1.75	2.00	2.50	3.00	3.50	4.00			5.00	SHSM	PROJECT SHEET #	STANDARD SHEET #	
																	(LB / FT)			(LB / FT)									
<b>IRASBURG US-5 NB</b>							FY-FLUORESCENT YELLOW FYG-FLUORESCENT YELLOW GREEN															"SHSM"-STANDARD HIGHWAY SIGNS AND MARKINGS							
NB	0.211	D	R1-1	30	30		STOP																						
		D	R1-1	30	30			6.25															TELEPHONE LN (TH-32)	X					
NB	0.213	J	R4-7	24	30		RIGHT BULL NOSE																						
		J	OM1-1	18	18		YELLOW CLUSTER																						
		K	R3-7R	30	30		LEFT LANE MUST TURN LEFT																						
		K	OM1-1	18	18		YELLOW CLUSTER																						
		J	R4-7	24	30			5.00																X					
		J	OM1-1	18	18			2.25																X					
		K	OM1-1	18	18			2.25																X					
NB	0.218	A	M3-1	24	12		NORTH US																						
		A	M1-4	24	24		US 5																						
		A	M3-1	24	12	BLK/ WHT		2.00																X					
		A	M1-4	24	24	BLK/ WHT		4.00																X					
NB	0.255	A	R2-1	24	30		SPEED LIMIT 50																						
		A	R2-1	24	30			5.00																X					
<b>SIGN SUMMARY SHEET</b>							<b>SHEET TOTALS</b>		26.75	0.00	0	0	0	8	0	0	4	60.0	0	0.0	0.0	0.0	0.0	PROJECT NAME: <b>BARTON-DERBY</b> PROJECT NUMBER: <b>STPG SIGN (46)</b>					
							SF	SF	EA	EA	EA	EA	EA	EA	EA	EA	EA	FT	EA	LB	LB	LB	LB	FILE NAME: <b>03 IRASBURG US 5 NB TSS.xl</b> PLOT DATE: <b>11/7/2014</b> PROJECT MANAGER: <b>D. BRYANT</b> DRAWN BY: <b>J. BLANCHARD</b> DESIGNED BY: <b>B. TOOTHAKER</b> CHECKED: <b>K. KERN</b> IRASBURG NB SHEET 3 SHEET <b>40</b> OF <b>100</b>					
VERMONT AGENCY OF TRANSPORTATION							<b>TOWN DIRECTIONAL TOTALS</b>		133.1	0.0	19	1	1	32	0	0	26	390.0	0	0.0									