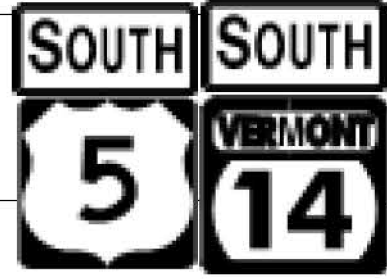



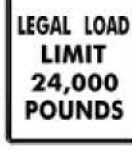


DIRECTION	MILEPOINT	LOCATION CODE (SHEET 2)	SIGN CODE	WIDTH (IN)	HEIGHT (IN)	SHEETING REMARKS	SIGN LEGEND	NEW SIGNS		EXISTING SIGNS			EXIST POST		NUMBER OF NEW POSTS	SQUARE STEEL (IN)			TUBULAR STEEL Ø (IN)				SIGN FRAME REQUIRED	REMARKS	SIGN DETAIL LOCATION				
								"A"	"B"	RETAIN	SALVAGE FROM	SALVAGE TO	REMOVE	RETAIN		REMOVE	1.75	2.00	2.50	FOUNDATION	3.00	3.50			4.00	5.00	SHSM	PROJECT SHEET #	STANDARD SHEET #
																	(LB / FT)				(LB / FT)								
<b>COVENTRY US-5 SB</b>							FY-FLUORESCENT YELLOW FYG-FLUORESCENT YELLOW GREEN															"SHSM"-STANDARD HIGHWAY SIGNS AND MARKINGS							
		F	M3-3	24	12	BLK/WHT		2.00						1			10'-5" X					1A		X					
		F	M1-4	24	24	BLK/WHT		4.00																X					
		F	M3-3	24	12	GRN/WHT		2.00																		E-136B			
		F	M1-5	24	24	GRN/WHT		4.00																		E-136B			
SB	0.469	F	S1-1	36	36		SCHOOL SYMBOL					1	X																
		F	W16-9	24	12		AHEAD					1																	
		F	S1-1	36	36	FGY		9.00															RETAIN FLASHING BEACON	X					
		F	S4-3P	36	12	FYG		3.00																X					
SB	0.360	F	D1-1E	72	20		<--- COVENTRY VILLAGE SCHOOL					1	X																
		F	VD2-1	72	20			10.00						2			10'-3" X 11'-2"								6				
SB	0.356	E/F	D3-1	30	12			2.50						1			7'-0" X						MAIN ST (TH-54); INSTALL 21 FT SOUTH OF SCHOOL SIGN; 8 FT OFF EDGE OF US 5 PAVEMENT		11				
SB	0.346	G	VR-017	24	30		LLL 24,000 LBS					1	X																
		G	UNK	UNK	UNK		SLOW CHILDREN AT PLAY				1	1											SALVAGE AND RETURN TO TOWN						
		G	VR-017	24	30			5.00						1			9'-11" X						MAIN ST (TH-54)		9				
SB	0.334	H	R1-1	30	30		STOP					1	X																
<b>SIGN SUMMARY SHEET</b>							SHEET TOTALS		41.50	0.00	0	1	0	6	0	0	5	75.0	0	0.0	0.0	0.0	0.0	PROJECT NAME: <b>BARTON-DERBY</b> PROJECT NUMBER: <b>STPG SIGN (46)</b>					
VERMONT AGENCY OF TRANSPORTATION							SF	SF	EA	EA	EA	EA	EA	EA	EA	EA	EA	EA	EA	EA	EA	EA	EA	EA	FILE NAME: <b>06 COVENTRY US 5 SB TSS.xl</b> ; PLOT DATE: <b>11/7/2014</b> PROJECT MANAGER: <b>D. BRYANT</b> ; DRAWN BY: <b>J. BLANCHARD</b> DESIGNED BY: <b>B. TOOTHAKER</b> ; CHECKED: <b>K. KERN</b> COVENTRY SB SHEET 6; SHEET <b>67</b> OF <b>100</b>				
TOWN DIRECTIONAL TOTALS							265.0	0.0	0	1	0	58	0	0	29	435.0	0	0.0	0.0	0.0	0.0								