


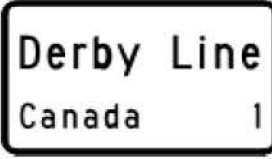




DIRECTION	MILEPOINT	LOCATION CODE (SHEET 2)	SIGN CODE	WIDTH (IN)	HEIGHT (IN)	SHEETING REMARKS	SIGN LEGEND	NEW SIGNS		EXISTING SIGNS			EXIST POST		NUMBER OF NEW POSTS	SQUARE STEEL (IN)			TUBULAR STEEL Ø (IN)				SIGN FRAME REQUIRED	REMARKS	SIGN DETAIL LOCATION			
								"A"	"B"	RETAIN	SALVAGE FROM	SALVAGE TO	REMOVE	RETAIN		REMOVE	1.75	2.00	2.50	3.00	3.50	4.00			5.00	SHSM	PROJECT SHEET #	STANDARD SHEET #
																	(LB / FT)			(LB / FT)								
DERBY US-5 NB							FY-FLUORESCENT YELLOW FYG-FLUORESCENT YELLOW GREEN															"SHSM"-STANDARD HIGHWAY SIGNS AND MARKINGS						
		A	W3-5	36	36			9.00						2	9'-9" X 10'-1"								INSTALL AT LOCATION OF EXISTING VW-205 WARNING	X				
NB	4.927	A	R2-1	24	30		SPEED LIMIT 40					1	X															
		A	R2-1	30	36			7.50							11'-10" X									X				
NB	5.022	A	R2-5A	24	30		REDUCED SPEED AHEAD					1	X															
		A	W3-5	36	36			9.00						2	11'-3" X 9'-2"									X				
NB	5.077	A	VR-072	24	30		ENCARE THINK					1	X															
		A	VD-018	30	18			3.75						1	8'-6" X										6			
NB	5.098	A	VD-018A	30	24		VILLAGE OF DERBY LINE INCORPORATED 1891					1	X															
NB	5.118	A	R2-1	24	30		SPEED LIMIT 30					1	X															
		A	VR-040	24	24		THROUGH WAY ENDS HERE					1																
		B	VR-039	24	18		STATE HIGHWAY BEGINS					1																
		A	R2-1	30	36			7.50																X				
		A	VR-038	24	18			3.00																	9			
SIGN SUMMARY SHEET							SHEET TOTALS	39.75	0.00	0	0	0	7	0	0	5	75.0	0	0.0	0.0	0.0	0.0	PROJECT NAME: BARTON-DERBY PROJECT NUMBER: STPG SIGN (46)					
VERMONT AGENCY OF TRANSPORTATION							TOWN DIRECTIONAL TOTALS	SF	SF	EA	EA	EA	EA	EA	EA	EA	FT	EA	LB	LB	LB	LB	FILE NAME: 07 DERBY US 5 NB TSS.xls PLOT DATE: 11/7/2014 PROJECT MANAGER: D. BRYANT DRAWN BY: J. BLANCHARD DESIGNED BY: B. TOOTHAKER CHECKED: K. KERN DERBY NB SHEET 13 SHEET 83 OF 100					
								184.3	0.0	104	3	1	53	0	0	30	450.0	0		0.0								