

- INDEX OF SHEETS**
- 1 TITLE SHEET
 - 2 QUANTITY SHEET
 - 3-6 ROUTE QUANTITIES SHEETS
 - 7-13 HAND WORK QUANTITIES SHEETS
 - 14 INTERCHANGE QUANTITIES AND MATERIALS SHEET
 - 15 PAVEMENT MARKING NOTES
 - 16-20 PAVEMENT MARKING DETAILS SHEETS


- STANDARDS**
- E-106 TRAFFIC CONTROL MISCELLANEOUS DETAILS 03/01/04
 - E-112 TRAFFIC CONTROL FOR TYPICAL MOVING MAINTENANCE OPERATIONS 01/23/97

STATE OF VERMONT AGENCY OF TRANSPORTATION



PROPOSED IMPROVEMENT STATEWIDE NATIONAL HIGHWAY SYSTEM MARKING NHG MARK (206).


LENGTH OF PROJECT 268.98 MILES

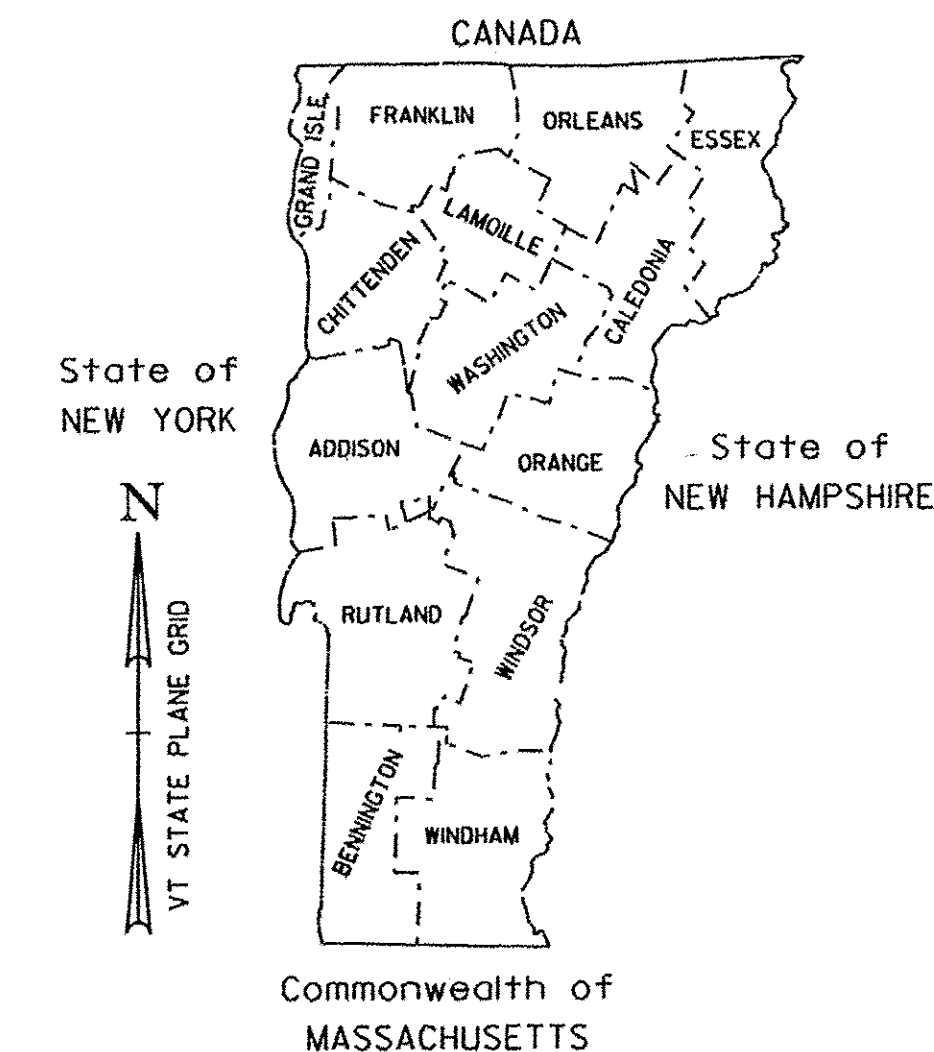

**PROPOSED IMPROVEMENT
NATIONAL HIGHWAY SYSTEM
PAVEMENT MARKING**

WORK TO BE PERFORMED UNDER THIS PROJECT INCLUDES NEW PAVEMENT MARKINGS INCLUDING CENTERLINES, EDGELINES, LANE LINES, DASHED AND DOTTED ACCELERATION AND DECELERATION LANES, GORE MARKINGS, STOP BARS AND STOP LETTERS, SYMBOLS, AND CROSSWALKS.

RECORD PLANS	
CONTRACTOR:	L&D SAFETY MARKINGS CORP.-BERLIN, VT
RESIDENT ENGINEER:	MARK HAUGHWOUT
CONSTRUCTION BEGAN:	JUNE 24, 2012
CONSTRUCTION COMPLETE:	OCTOBER 29, 2012
RECORD PLANS BY:	MARK HAUGHWOUT & K. KREIS
I HEREBY CERTIFY THAT ALL THE CONSTRUCTION REQUIRED BY THIS SET OF DRAWINGS HAS BEEN ACCOMPLISHED AS INDICATED HEREIN.	
BY	<i>Mark W. Haughwout</i> RESIDENT ENGINEER
DATE	1/24/14
NOTE: Any further information concerning final quantities, amounts or other details relative to this project may be found at Central Files in the electronic archives.	

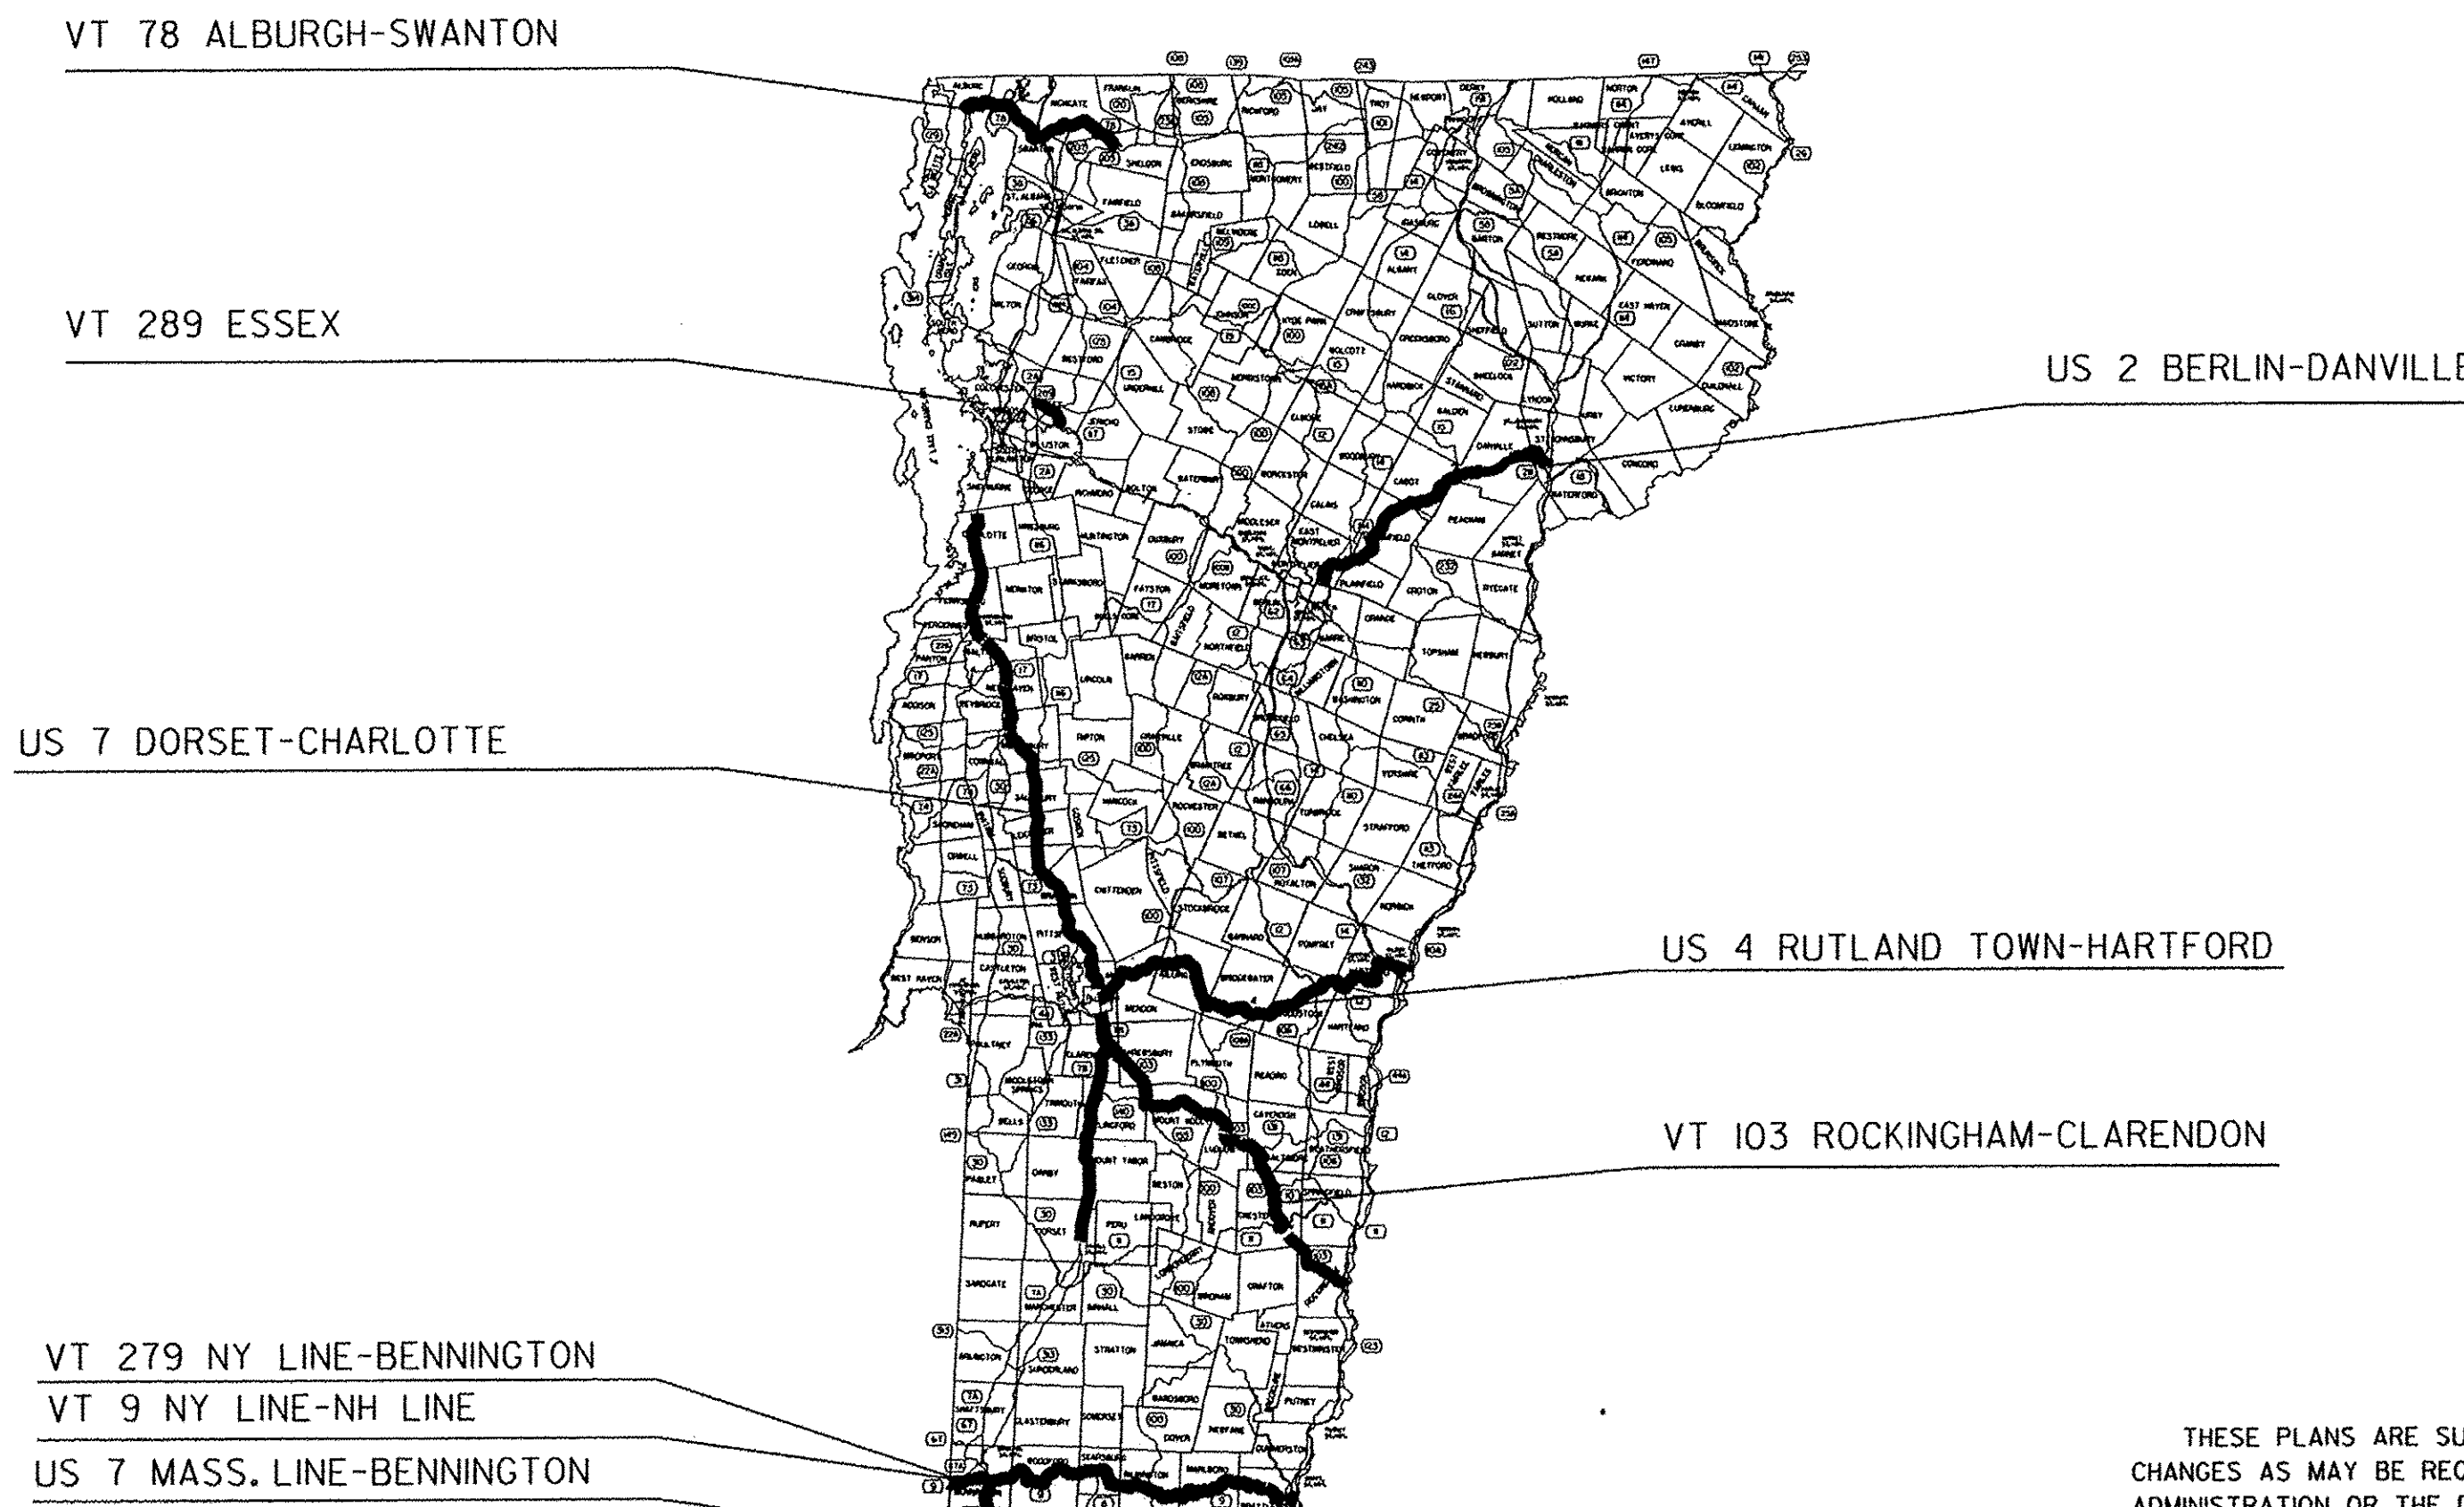

QUALITY ASSURANCE PROGRAM: LEVEL 1

CONVENTIONAL SYMBOLS	
COUNTY LINE	
TOWN LINE	
LIMITS OF ACCESS	
POINT OF ACCESS	
FENCE LINE	
STONE WALL	
TRAVELED WAY	
GUARD RAIL	
RAILROAD	
SURVEY LINE	
CULVERT	
POWER POLE	
TELEPHONE POLE	
TREES	
CONTROL OF ACCESS	
PROPERTY LINE	
R.O.W. TAKING LINE	
SLOPE RIGHTS	
TOP OF CUT	
TOE OF SLOPE	

SURVEYED BY :	
SURVEYED DATE :	
DATUM	
VERTICAL	
HORIZONTAL	

THESE PLANS ARE SUBJECT TO SUCH ENGINEERING CHANGES AS MAY BE REQUIRED BY THE FEDERAL HIGHWAY ADMINISTRATION OR THE DIRECTOR OF PROGRAM DEVELOPMENT.

CONSTRUCTION IS TO BE CARRIED ON IN ACCORDANCE WITH THESE PLANS AND THE STANDARD SPECIFICATIONS FOR CONSTRUCTION DATED 2011, AS APPROVED BY THE FEDERAL HIGHWAY ADMINISTRATION ON JULY 20, 2011 FOR USE ON THIS PROJECT, INCLUDING ALL SUBSEQUENT REVISIONS AND SUCH REVISED SPECIFICATIONS AND SPECIAL PROVISIONS AS ARE INCORPORATED IN THESE PLANS.

DIRECTOR OF PROGRAM DEVELOPMENT	
APPROVED <i>[Signature]</i>	DATE 3-13-12
PROJECT MANAGER : A. GAMBLE	
PROJECT NAME : STATEWIDE	
PROJECT NUMBER : NHG MARK (206)	
SHEET 1 OF 20 SHEETS	