

STATE OF VERMONT AGENCY OF TRANSPORTATION



PROPOSED IMPROVEMENT BRIDGE PROJECT

COUNTY OF LAMOILLE
TOWN OF MORRISTOWN

ROUTE NO : VT RTE 15A, MAJOR COLLECTOR
BRIDGE NO : 1

BRS 0240(3)S PROJECT LOCATION : BEGINNING AT A POINT ON VT ROUTE 15A APPROXIMATELY 0.27 MILES WESTERLY FROM ITS INTERSECTION WITH VT ROUTE 15 AND EXTENDING EASTERLY APPROXIMATELY 0.21 MILES.

BRS 0240(3)S PROJECT DESCRIPTION : REPLACEMENT OF EXISTING TEMPORARY BRIDGE WITH A NEW CURVED GIRDER STRUCTURE ON A NEW ALIGNMENT ALONG WITH NECESSARY CHANNEL AND APPROACH WORK.

LENGTH OF STRUCTURE : 222.66 FEET.
LENGTH OF ROADWAY : 902.34 FEET.
LENGTH OF PROJECT : 1,125.00 FEET.



STP HES 030-2(28) PROJECT LOCATION : BEGINNING AT POINT ON VT ROUTE 15 APPROXIMATELY 1.55 MILES EASTERLY FROM ITS INTERSECTION WITH VT ROUTE 100 AND EXTENDING EASTERLY APPROXIMATELY 0.17 MILES.

STP HES 030-2(28) PROJECT DESCRIPTION : WORK INCLUDES THE CONSTRUCTION OF A NEW INTERSECTION OF VT ROUTE 15 AND VT ROUTE 15A, INCLUDING ALL NECESSARY ROAD WORK AND REPLACEMENT OF AN EXISTING CATTLE PASS.

VT ROUTE 15 LENGTH OF ROADWAY : 900.00 FEET.
VT ROUTE 15A LENGTH OF ROADWAY : 233.00 FEET.

CONSTRUCTION IS TO BE CARRIED ON IN ACCORDANCE WITH THESE PLANS AND THE STANDARD SPECIFICATIONS FOR CONSTRUCTION DATED 2011, AS APPROVED BY THE FEDERAL HIGHWAY ADMINISTRATION ON JULY 20, 2011 FOR USE ON THIS PROJECT, INCLUDING ALL SUBSEQUENT REVISIONS AND SUCH REVISED SPECIFICATIONS AND SPECIAL PROVISIONS AS ARE INCORPORATED IN THESE PLANS.

QUALITY ASSURANCE PROGRAM : LEVEL 2	
SURVEYED BY :	J.A. SHERIDAN
SURVEYED DATE :	FEB 1991
DATUM	
VERTICAL	NGVD 29
HORIZONTAL	NAD 83 (92)

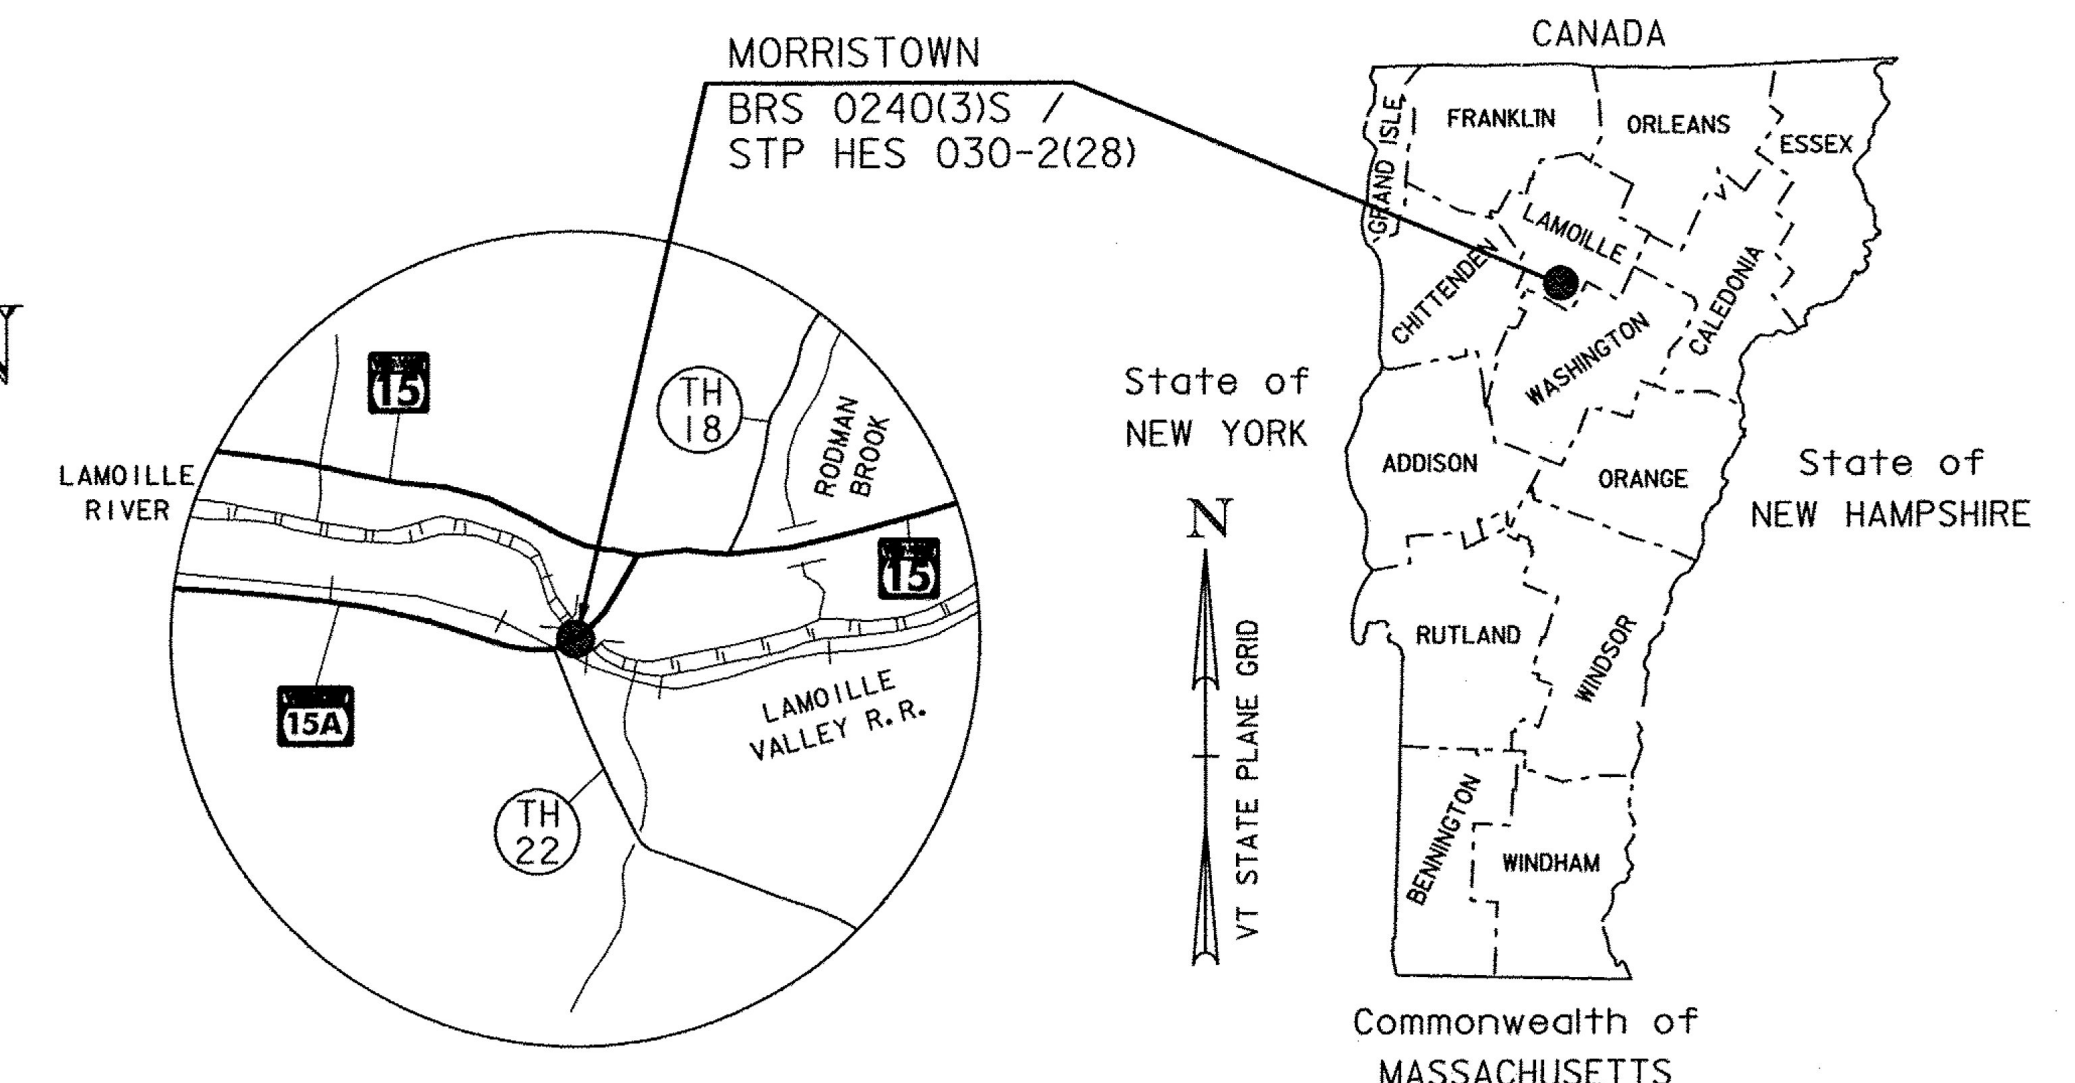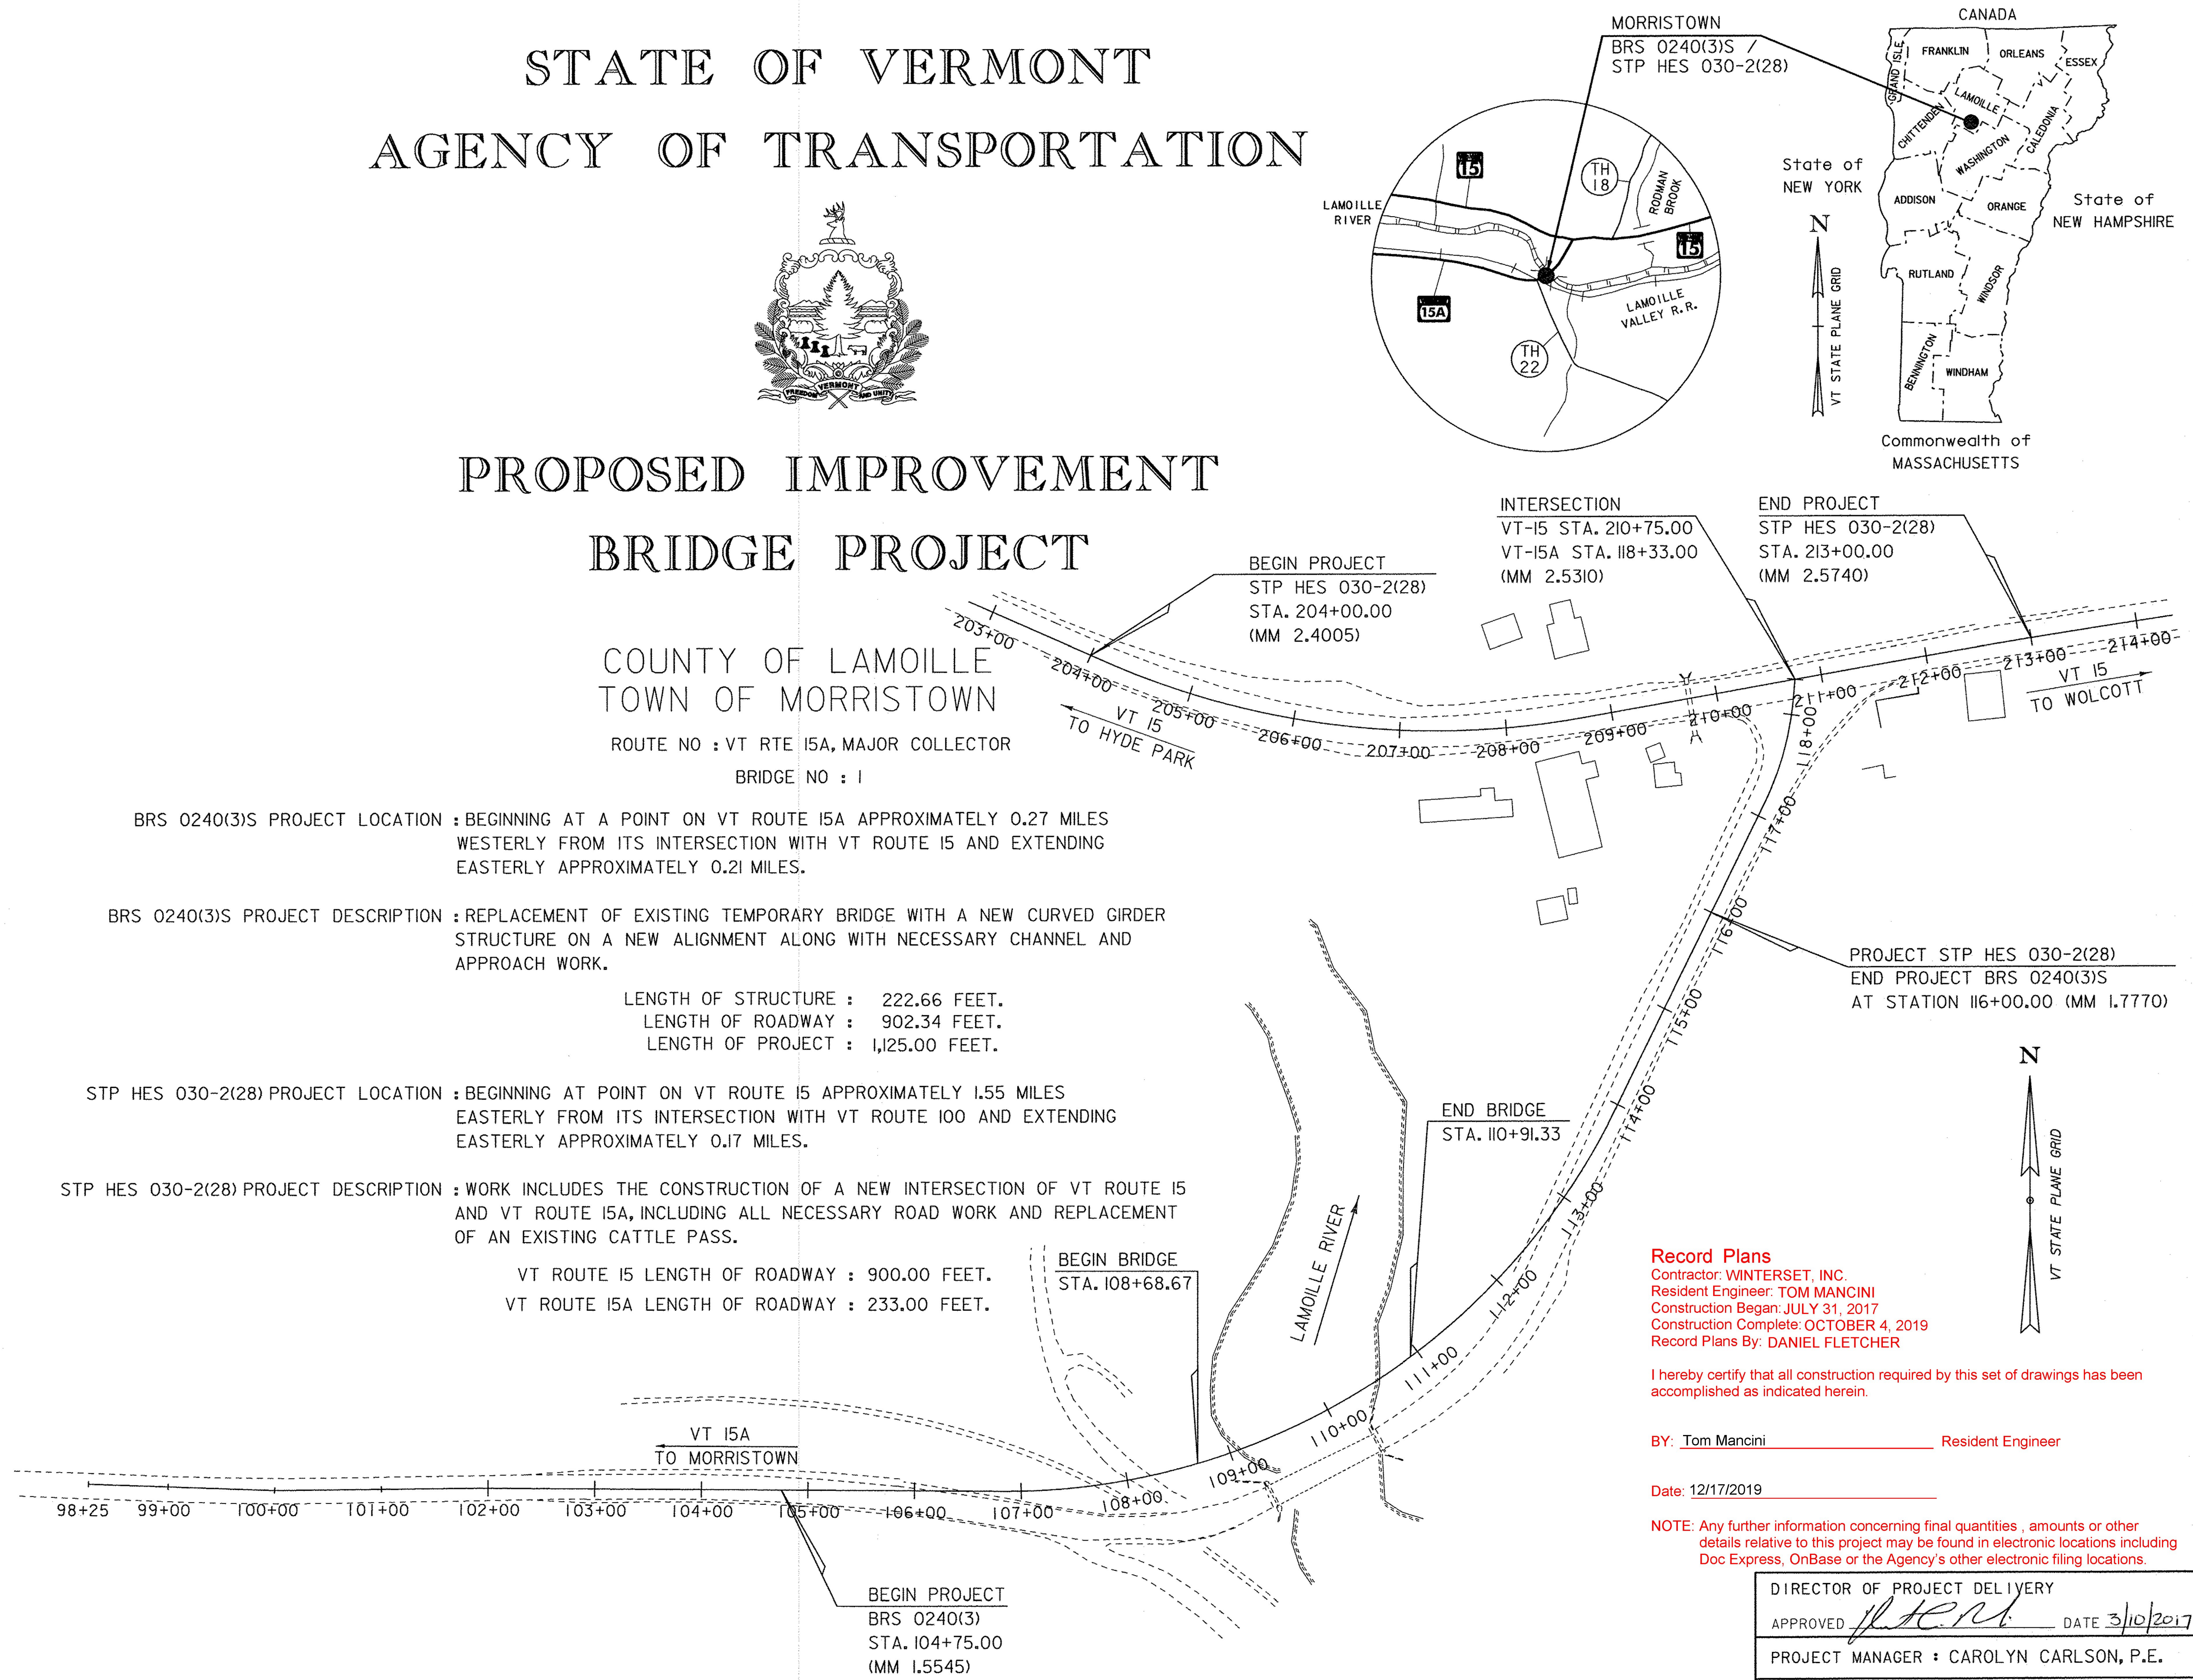


Record Plans
 Contractor: WINTERSET, INC.
 Resident Engineer: TOM MANCINI
 Construction Began: JULY 31, 2017
 Construction Complete: OCTOBER 4, 2019
 Record Plans By: DANIEL FLETCHER

I hereby certify that all construction required by this set of drawings has been accomplished as indicated herein.

BY: Tom Mancini Resident Engineer

Date: 12/17/2019

NOTE: Any further information concerning final quantities, amounts or other details relative to this project may be found in electronic locations including Doc Express, OnBase or the Agency's other electronic filing locations.

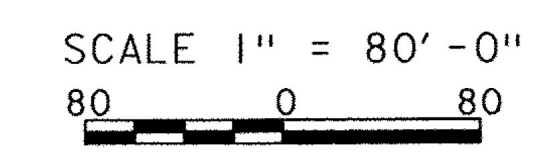

DIRECTOR OF PROJECT DELIVERY	
APPROVED	DATE 3/10/2017
PROJECT MANAGER : CAROLYN CARLSON, P.E.	
PROJECT NAME : MORRISTOWN	
PROJECT NUMBER : BRS 0240(3)S & STP HES 030-2(28)	
SHEET 1 OF 175 SHEETS	