



MATERIAL TOLERANCES
(IF USED ON PROJECT)


SURFACE	
- PAVEMENT (TOTAL THICKNESS)	+/- 1/4"
- AGGREGATE SURFACE COURSE	+/- 1/2"
SUBBASE	
SAND BORROW	+/- 1"

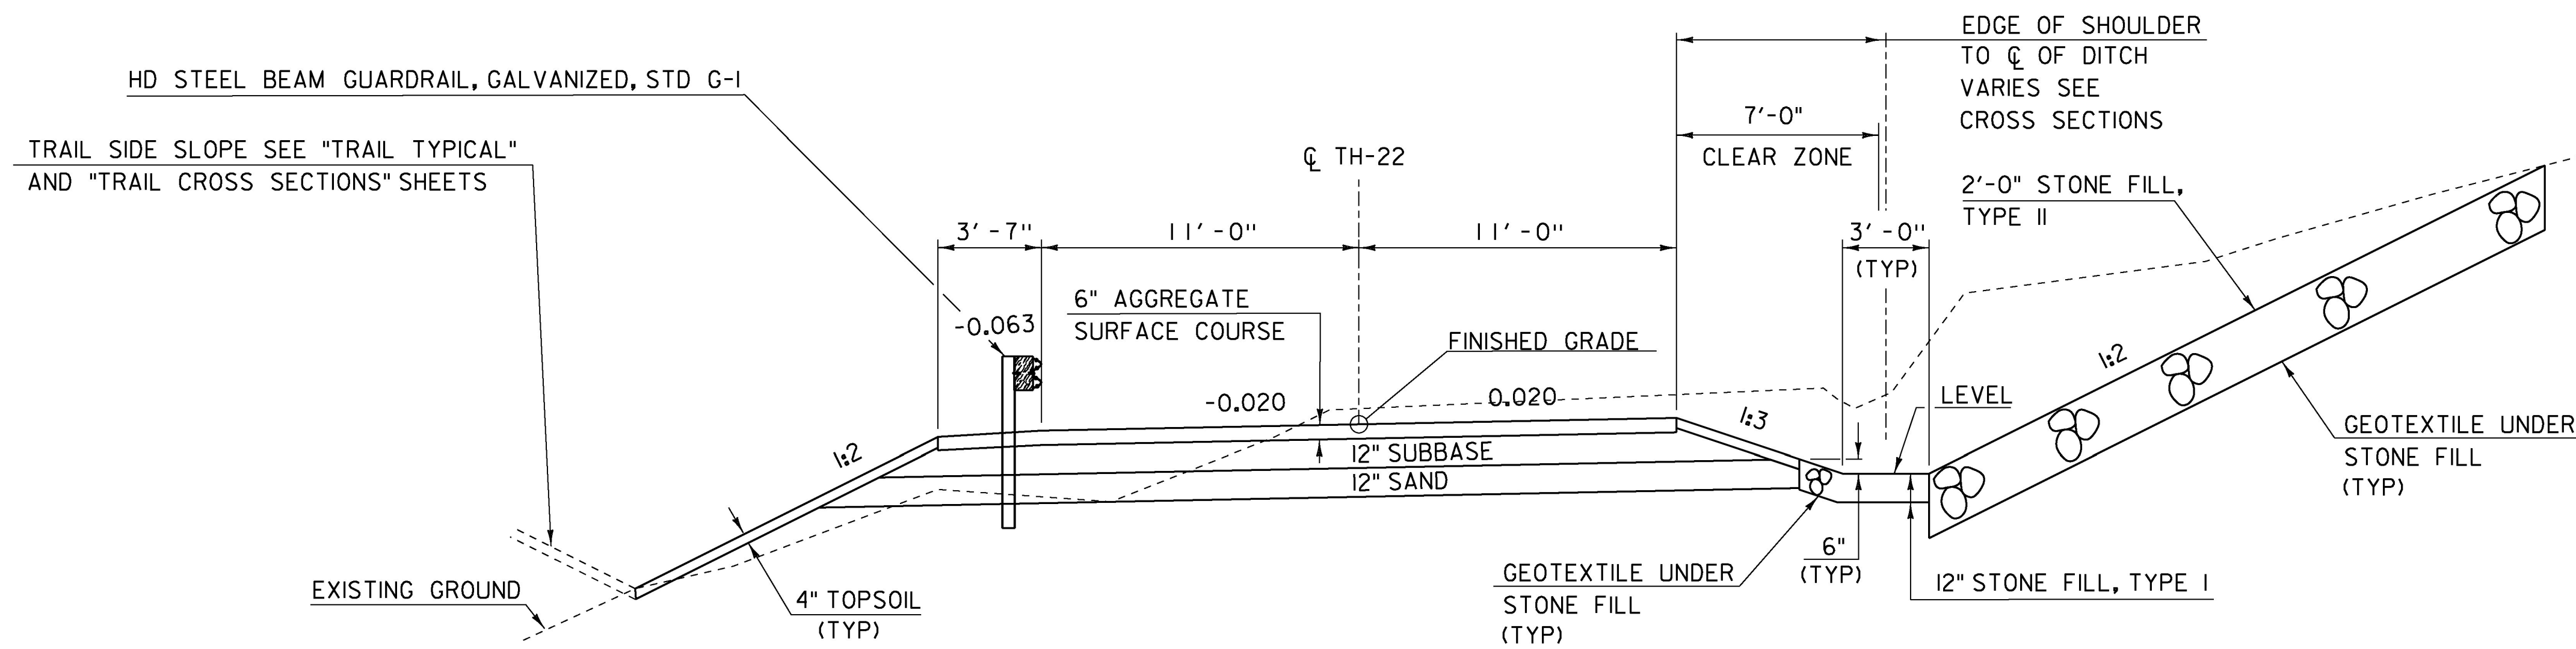

TH-22 (DARLING RD)
TYPICAL WITHOUT LEDGE
SCALE 1/4" = 1'-0"

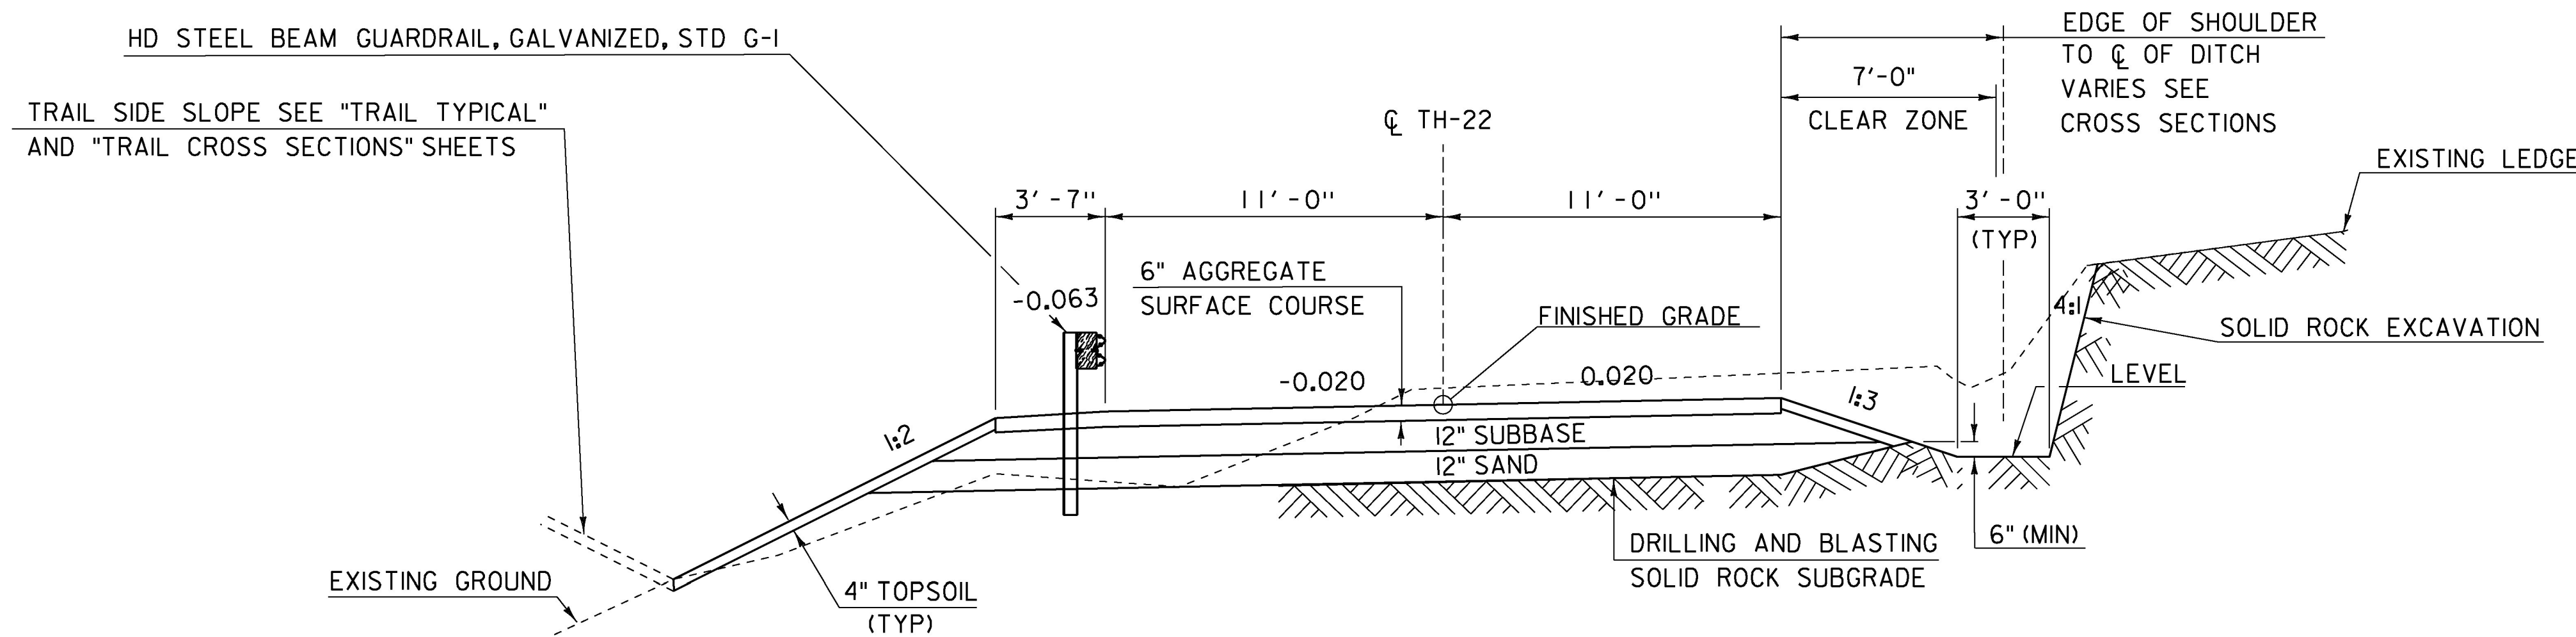

TH-22 (DARLING RD)
TYPICAL WITH LEDGE
SCALE 1/4" = 1'-0"

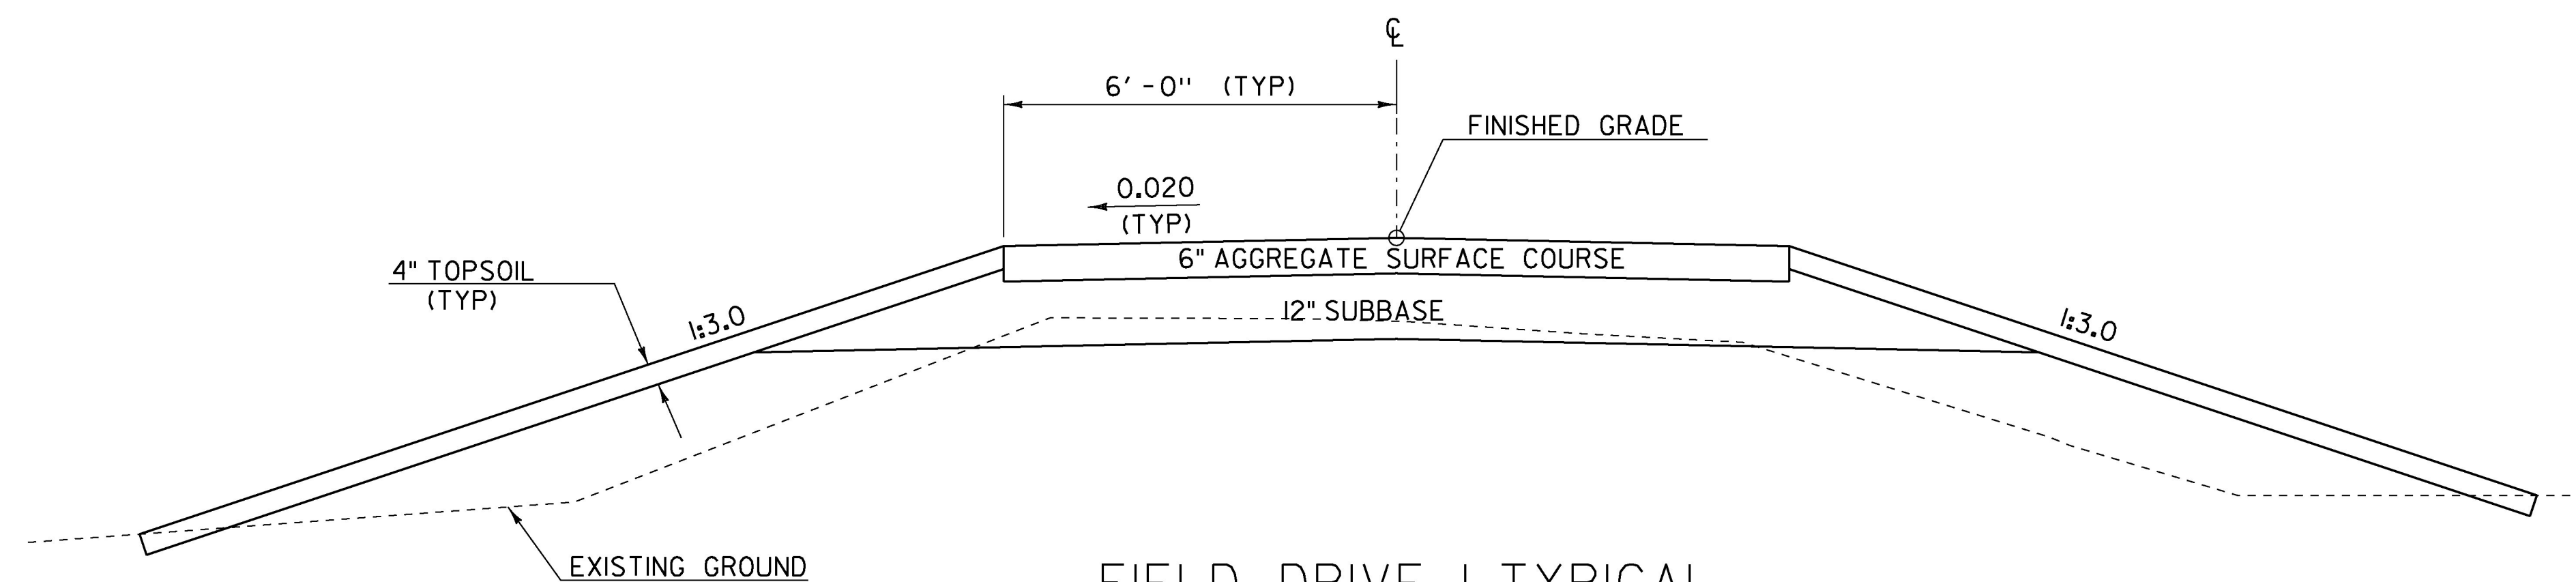

FIELD DRIVE I TYPICAL
SCALE 1/2" = 1'-0"

NOTES:

- ANY EXPOSED LEDGE THAT IS REMOVED WILL BE PAID FOR UNDER BID ITEM 203.16 "SOLID ROCK EXCAVATION." ADDITIONAL LEDGE REMOVAL BELOW GRADE WILL BE PAID FOR UNDER BID ITEM 205.10 "DRILLING AND BLASTING SOLID ROCK SUBGRADE."

PROJECT NAME:	MORRISTOWN
PROJECT NUMBER:	BRS 0240(3)S/STP HES 030-2(28)
FILE NAME: s78f329+yp.dgn	PLOT DATE: 12-APR-2017
PROJECT LEADER: C. CARLSON	DRAWN BY: G. ROKES
DESIGNED BY: C. BURRALL	CHECKED BY: J. LACROIX
TH 22 AND FIELD DRIVE I TYPICAL SECTION	SHEET 4 OF 175