


②

VT-15A CURVE 3
 DELTA = 64° 15' 00"
 D = 9° 00' 00"
 R = 636.62'
 T = 399.74'
 L = 713.89'
 E = 115.10'

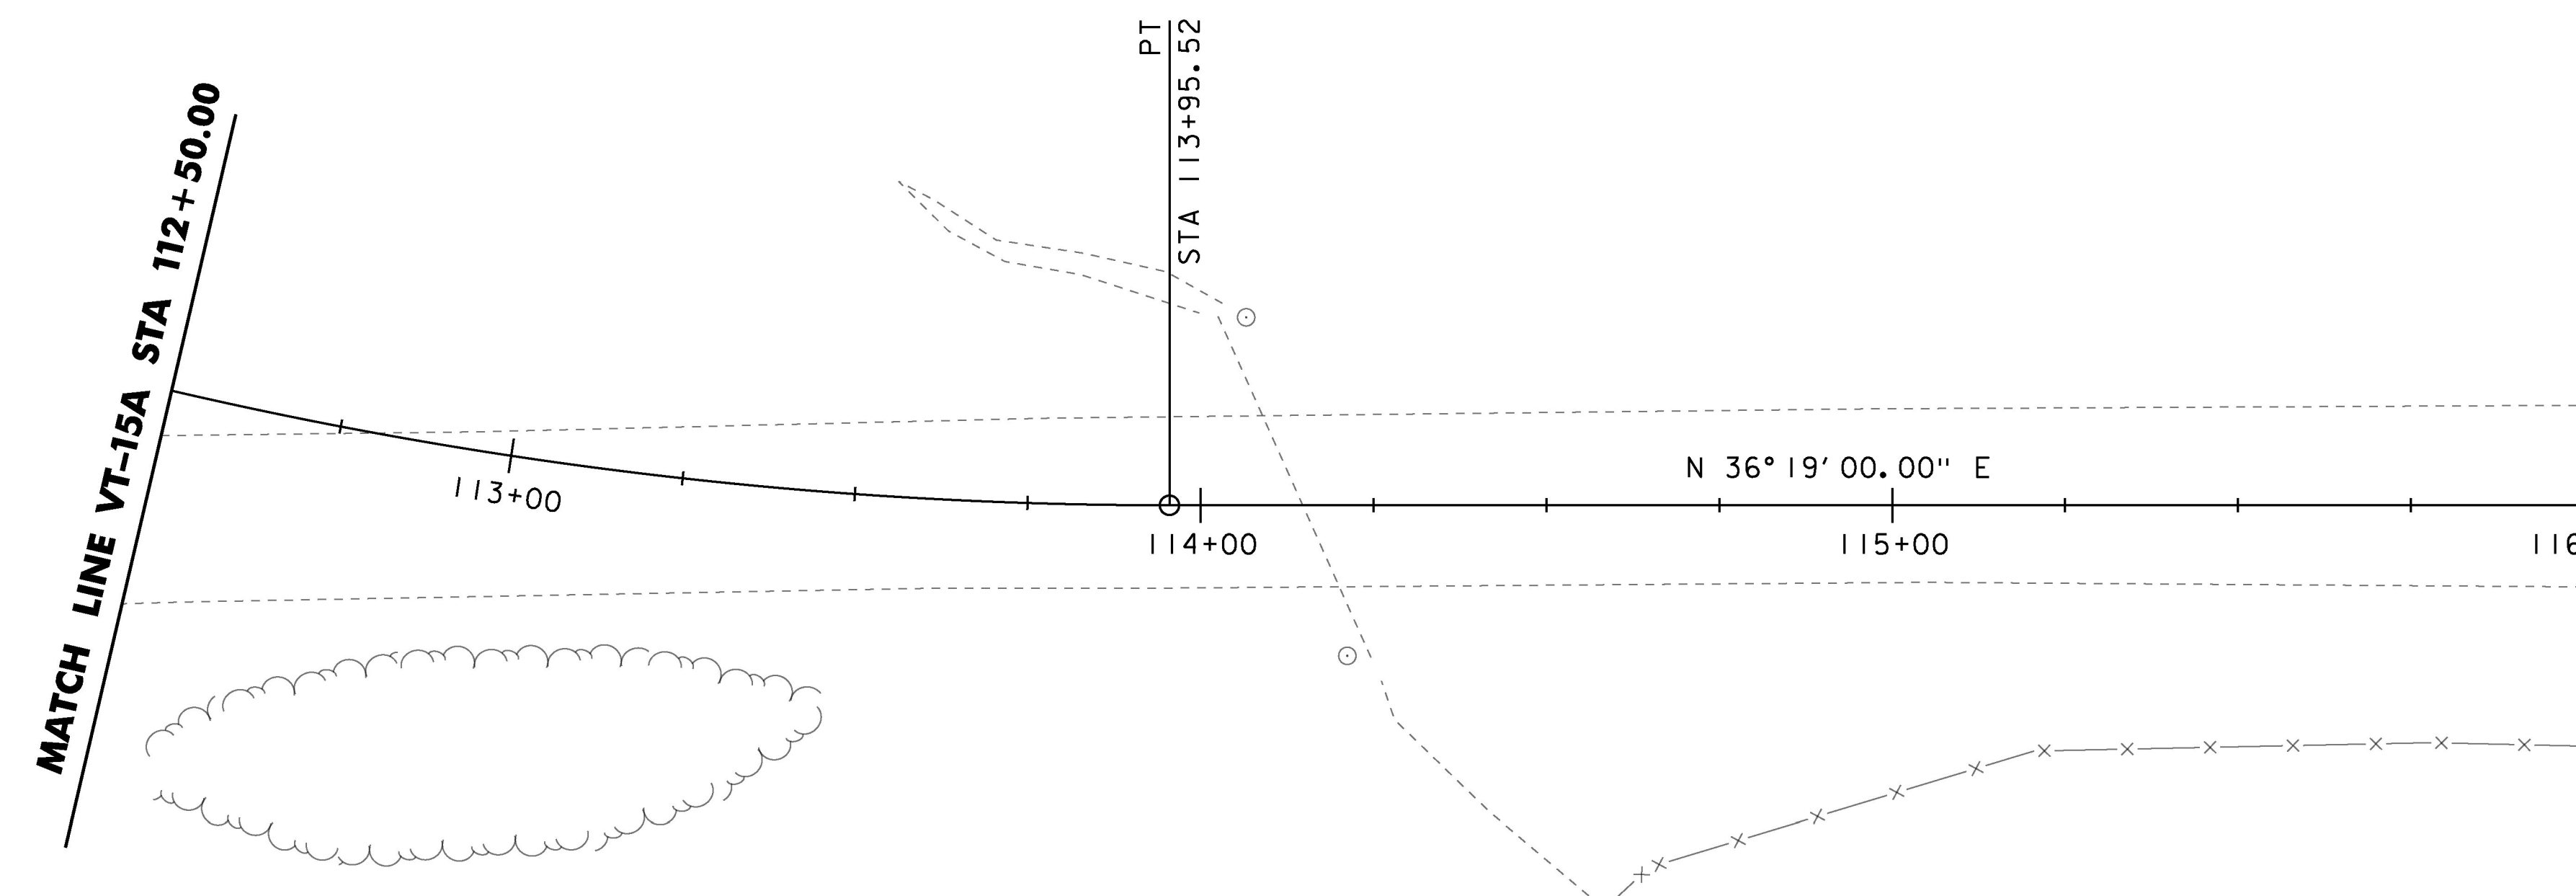

END PROJECT STP HES 030-2(28)
 BEGIN PROJECT BRS 0240(3)S
 MATCH LINE VT-15A STA 116+00.00

SCALE 1" = 20'-0"
 20 0 20

PROJECT NAME: MORRISTOWN	PLOT DATE: 12-APR-2017
PROJECT NUMBER: BRS 0240(3)S/STP HES 030-2(28)	DRAWN BY: G. ROKES
FILE NAME: s78f329allgnbdr.dgn	CHECKED BY: J. LACROIX
PROJECT LEADER: C. CARLSON	SHEET 23 OF 175
DESIGNED BY: C. BURRALL	
VT 15A ALIGNMENT SHEET 3	