


⑫ 6" UNDERDRAIN PIPE  
 FROM STA. 209+00.00 OFFSET 20.50' LT  
 TO STA. 209+67.68 OFFSET 20.50' LT  
 LENGTH 67'-8"

⑮ 6" UNDERDRAIN CARRIER PIPE  
 FROM STA. 209+67.72 OFFSET 54.75' RT  
 TO STA. 209+70.87 OFFSET 62.33' RT  
 LENGTH 8'-3"

⑬ UNDERDRAIN FLUSHING BASIN  
 STA. 209+67.68 OFFSET 21.67' LT

⑭ 6" UNDERDRAIN CARRIER PIPE  
 FROM STA. 209+67.68 OFFSET 21.67' LT  
 TO STA. 209+67.72 OFFSET 54.75' RT  
 LENGTH 75'-3"

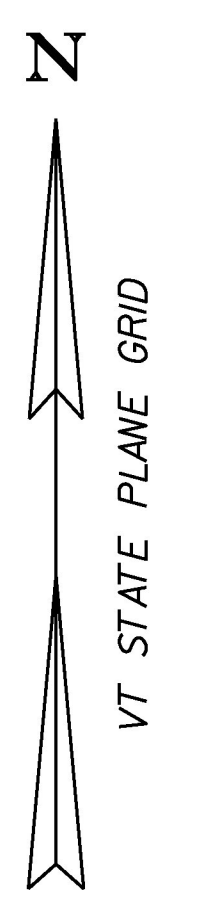

INTERSECTION  
 VT-15 STA. 209+75.00  
 CATTLE PASS STA. 2+00.00  
 AT 90° RIGHT

INTERSECTION  
 VT-15A STA. 118+33.00  
 VT-15 STA. 210+75.00  
 AT 15° RIGHT

MATCHLINE VT-15 STA. 209+00.00

VT 15  
 TO HYDE PARK

VT 15  
 TO WOLCOTT

⑭ ⑮ STA. 209+67.72  
 OFFSET 54.74 FT RT  
 INVERT EL= 685.147

⑮ STA. 209+70.87  
 OFFSET 62.34 FT RT  
 INVERT EL= 683.511

CATTLE PASS

VT 15A  
 TO MORRISVILLE

SCALE 1" = 10'-0"  
 10 0 10

PROJECT NAME:	MORRISTOWN
PROJECT NUMBER:	BRS 0240(3)S/STP HES 030-2(28)
FILE NAME:	s78f329draInbdr.dgn
PROJECT LEADER:	C. CARLSON
DESIGNED BY:	C. BURRALL
VT 15 DRAINAGE LAYOUT SHEET 2	
PLOT DATE:	12-APR-2017
DRAWN BY:	G. ROKES
CHECKED BY:	J. LACROIX
SHEET	50 OF 175