


FIELD DRIVE 4 DRAINAGE PLAN

7 NEW 18 INCH DIA. CPEP(SL) PIPE
FROM STA. 115+12.58 OFFSET 31'-0" LT
TO STA. 115+60.86 OFFSET 31'-7" LT
LENGTH 48'-4"

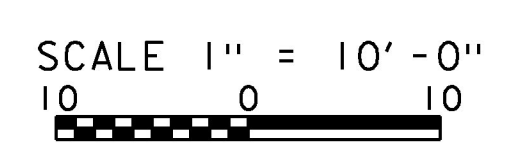

FOR INFORMATION ON PIPE INVERTS, PIPE SLOPES
SEE "FIELD DRIVE 4 DRAINAGE " ON
"FIELD DRIVES AND CATTLE PASS PROFILES" SHEET

PROJECT NAME:	MORRISTOWN
PROJECT NUMBER:	BRS 0240(3)S/STP HES 030-2(28)
FILE NAME:	s78f329draInsys.dgn
PROJECT LEADER:	C. CARLSON
DESIGNED BY:	C. BURRALL
FIELD DRIVE 4 DRAINAGE	
PLOT DATE:	12-APR-2017
DRAWN BY:	G. ROKES
CHECKED BY:	J. LACROIX
SHEET	53 OF 175