
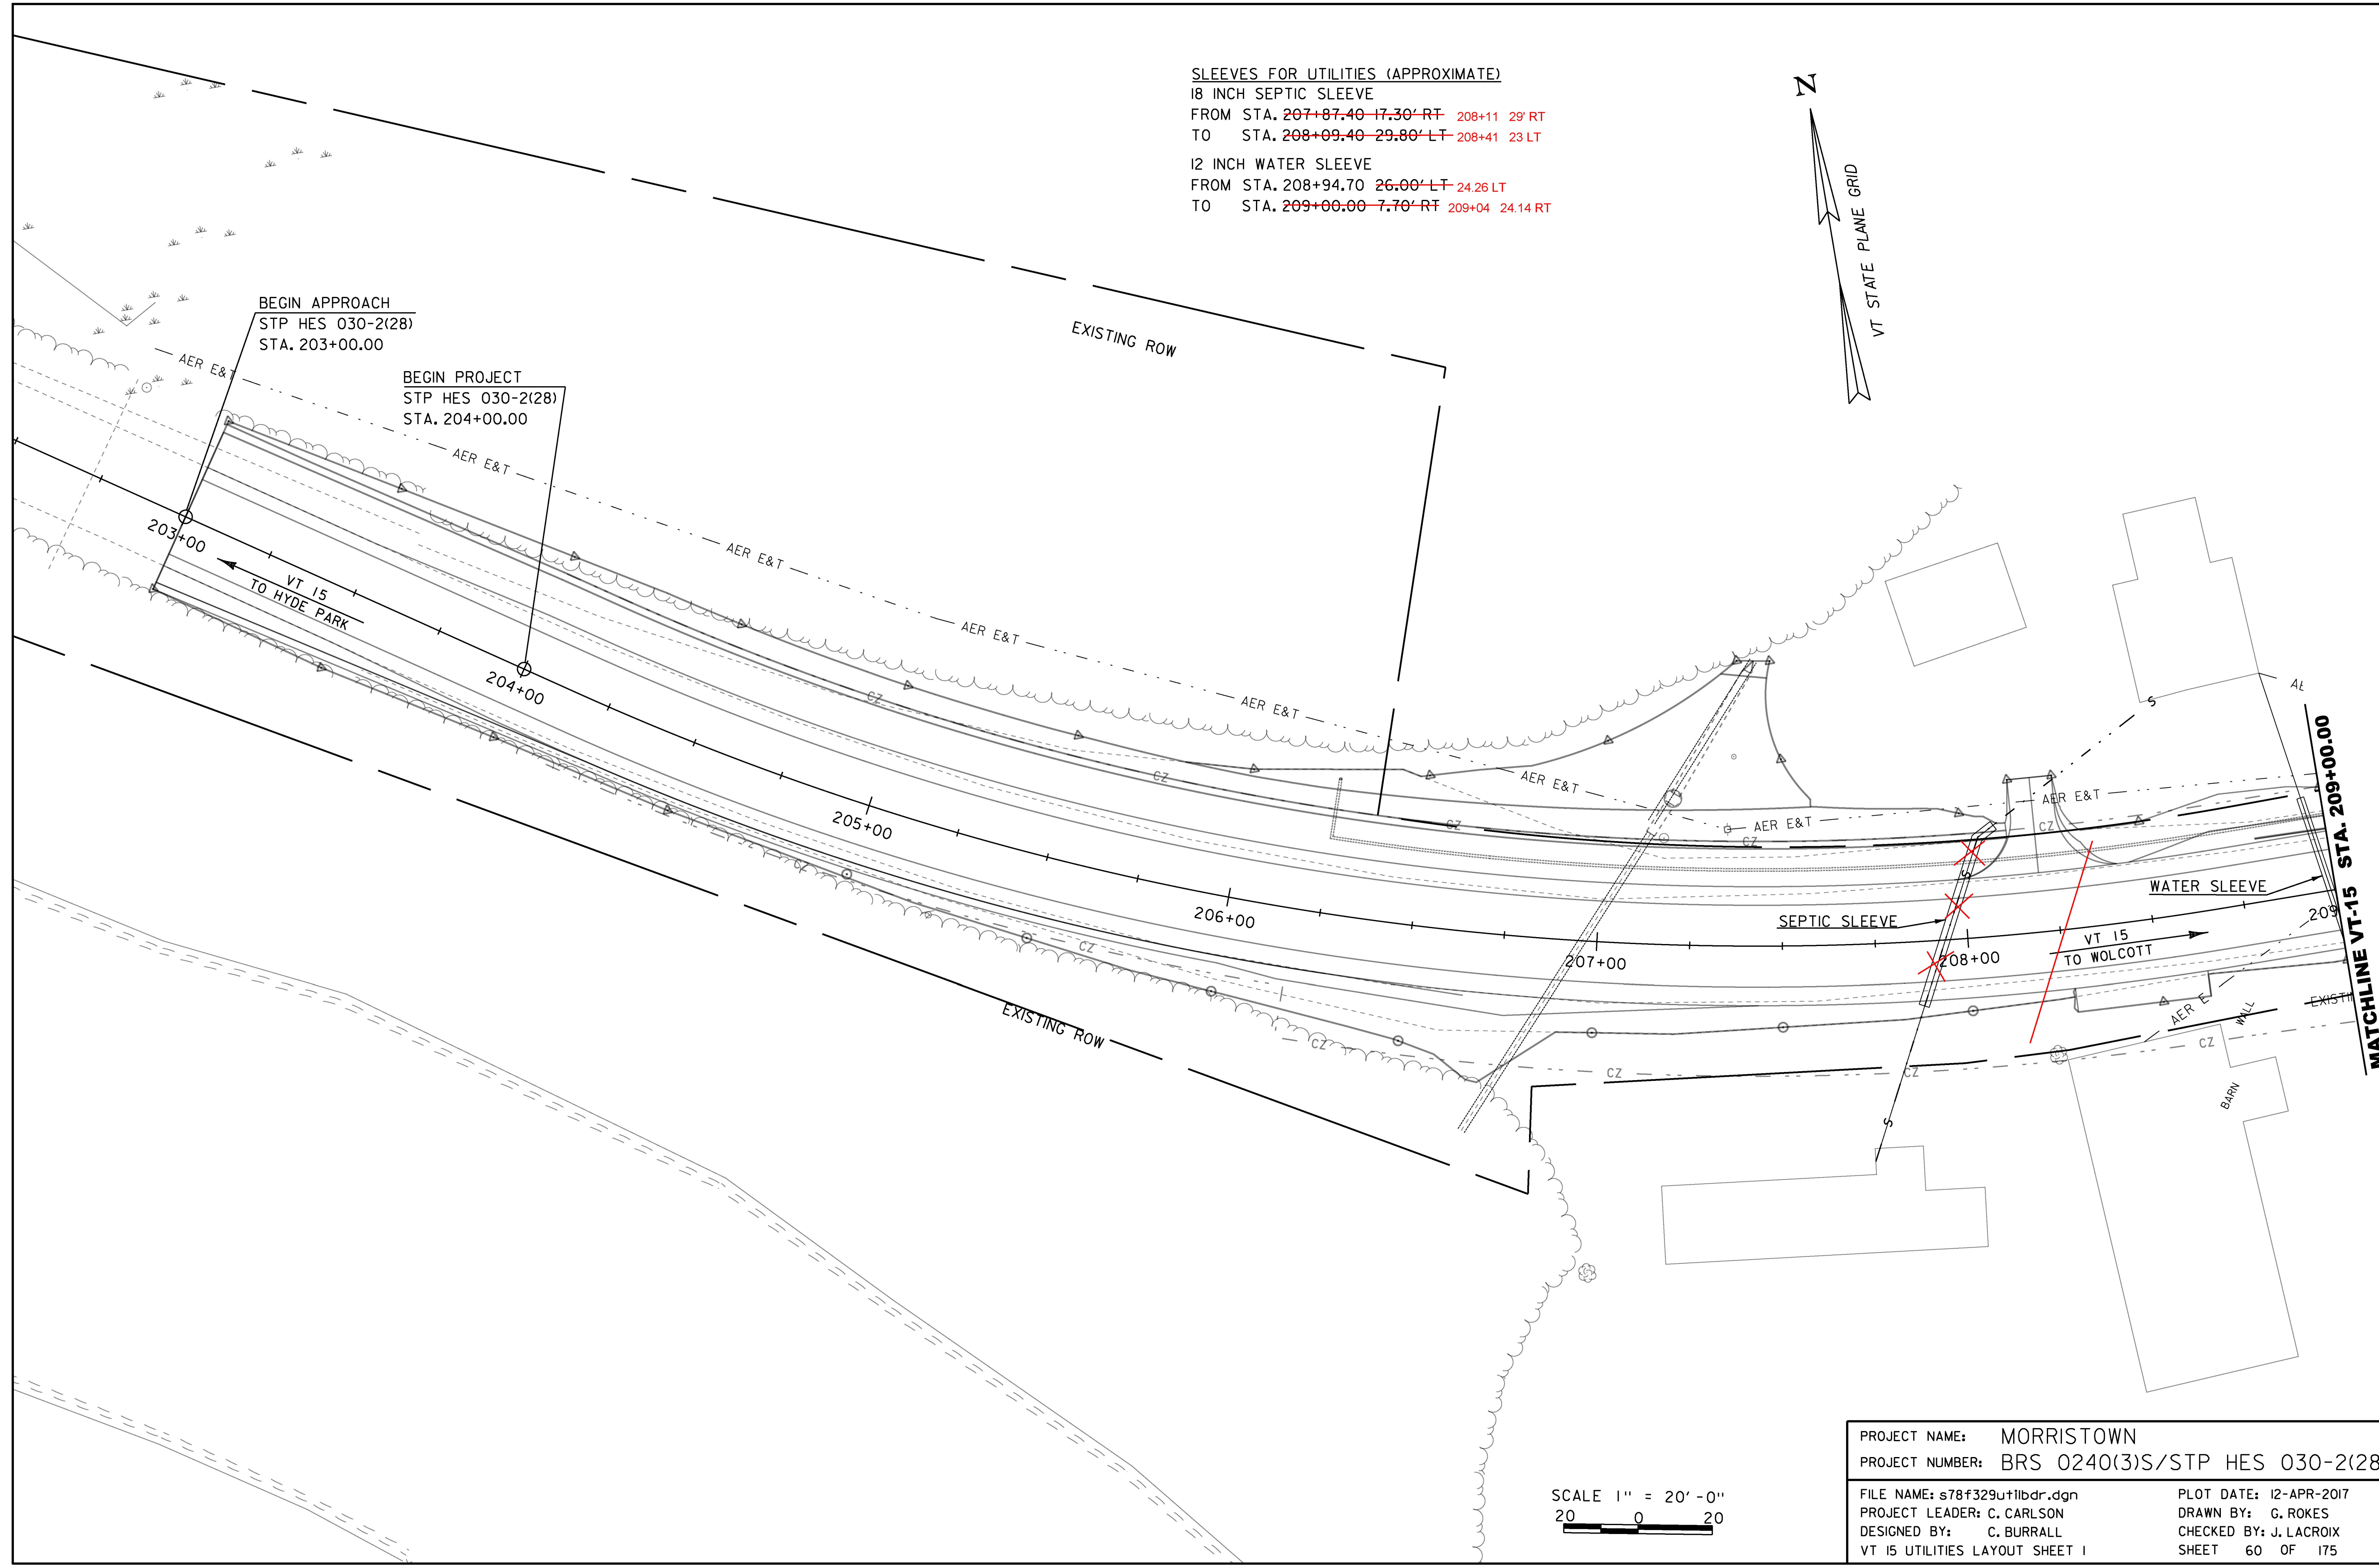


SLEEVES FOR UTILITIES (APPROXIMATE)
 18 INCH SEPTIC SLEEVE
 FROM STA. 207+87.40 -17.30' RT 208+11 29' RT
 TO STA. 208+09.40 -29.80' LT 208+41 23' LT
 12 INCH WATER SLEEVE
 FROM STA. 208+94.70 26.00' LT 24.26' LT
 TO STA. 209+00.00 -7.70' RT 209+04 24.14' RT

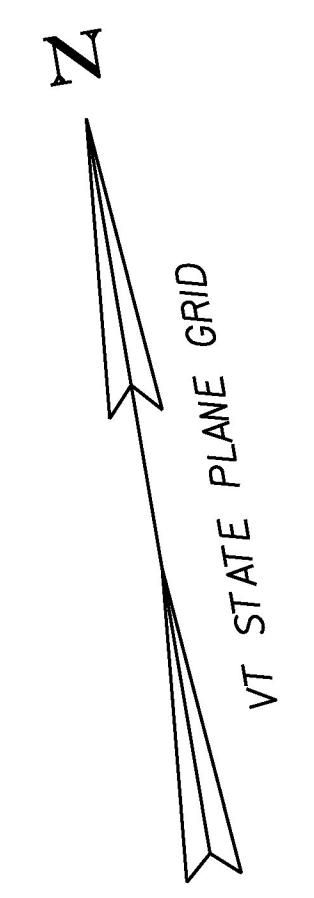

BEGIN APPROACH
 STP HES 030-2(28)
 STA. 203+00.00

BEGIN PROJECT
 STP HES 030-2(28)
 STA. 204+00.00

PROJECT NAME:	MORRISTOWN
PROJECT NUMBER:	BRS 0240(3)S/STP HES 030-2(28)
FILE NAME:	s78f329utilbdr.dgn
PROJECT LEADER:	C. CARLSON
DESIGNED BY:	C. BURRALL
VT 15 UTILITIES LAYOUT SHEET 1	
PLOT DATE:	12-APR-2017
DRAWN BY:	G. ROKES
CHECKED BY:	J. LACROIX
SHEET	60 OF 175

SCALE 1" = 20'-0"
 20 0 20

MATCHLINE VT-15 STA. 209+00.00