


DURABLE 12 INCH WHITE LINE
 STA. 55+37.73 LENGTH 12'-0"
 STA. 55+87.50 LENGTH 12'-0"
 STA. 56+60.68 LENGTH 12'-0"
 STA. 56+98.94 LENGTH 12'-0"

PORTLAND CEMENT CONCRETE SIDEWALK (8 INCH)
 STA. 55+40.73 TO STA. 55+45.29
 STA. 55+74.00 TO STA. 55+78.46
 STA. 56+63.68 TO STA. 56+69.87
 STA. 56+89.35 TO STA. 56+95.94

DETECTABLE WARNING SURFACE
 STA. 55+42.20 (2'-0" X 12'-0")
 STA. 55+77.00 (2'-0" X 12'-0")
 STA. 56+65.20 (2'-0" X 12'-0")
 STA. 56+94.40 (2'-0" X 12'-0")


BITUMINOUS CONCRETE SIDEWALK
 STA. 55+33.23 TO STA. 55+40.73
 STA. 55+78.46 TO STA. 55+85.99
 STA. 56+56.17 TO STA. 56+63.68
 STA. 56+95.94 TO STA. 57+03.44

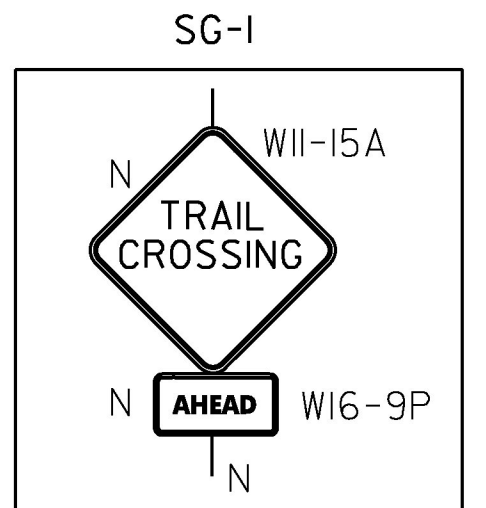

VT-15A STA. 103+50.00 RT
 VT-15A STA. 111+13.00 LT
 TH-22 STA. 113+00.00 LT

"SG" INDICATES "SIGN GROUP" INDICATING HOW SIGNS ARE TO BE GROUPED TOGETHER ON A SINGLE POST AND BE PLACED AT DESIGNATED LOCATIONS.

NOTE: SIGNS SHALL BE PLACED SUCH THAT THE EDGE OF THE SIGN IS NO CLOSER THAN 2'-0" AND NO FURTHER THAN 5'-0" FROM THE EDGE OF TRAIL AND 5'-0" FROM THE TRAIL SURFACE TO THE BOTTOM OF THE SIGN.

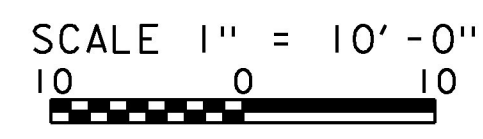

PROJECT NAME:	MORRISTOWN
PROJECT NUMBER:	BRS 0240(3)S/STP HES 030-2(28)
FILE NAME:	s78f329trail.dgn
PROJECT LEADER:	C. CARLSON
DESIGNED BY:	C. BURRALL
TRAIL SIGN LAYOUT	
PLOT DATE:	12-APR-2017
DRAWN BY:	G. ROKES
CHECKED BY:	J. LACROIX
SHEET	67 OF 175