


GEOMETRIC LAYOUT PLAN
SCALE: 1" = 10'-0"

LEGEND
WP = WORKING POINT

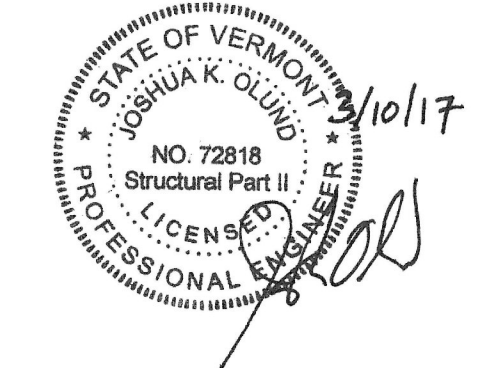

TYLIN INTERNATIONAL	PROJECT NAME: MORRISTOWN	PROJECT NUMBER: BRS 0240(3)S/STP HES 030-2(28)
	FILE NAME: s78f329sub.dgn	PLOT DATE: 12-APR-2017
	PROJECT LEADER: C. CARLSON DESIGNED BY: J. OLUND GEOMETRIC LAYOUT PLAN	DRAWN BY: G. ROKES CHECKED BY: T. POULIN SHEET 81 OF 175