


DEFLECTION DIAGRAM
NOT TO SCALE

NOTES:

- CAMBER AND DEFLECTION VALUES PROVIDED ARE IN INCHES. ALL VALUES ARE ALONG THE ARC OF THE CENTERLINE OF THE RESPECTIVE GIRDER.
- THE HORIZONTAL WORKING LINE IS A STRAIGHT, LEVEL LINE BASED ON THE ELEVATION AT THE TOP OF WEB AT CENTERLINE BEARING OF PIER #2.
- POSITIVE CAMBER VALUES ARE UPWARD; POSITIVE DEFLECTION VALUES ARE DOWNWARD.

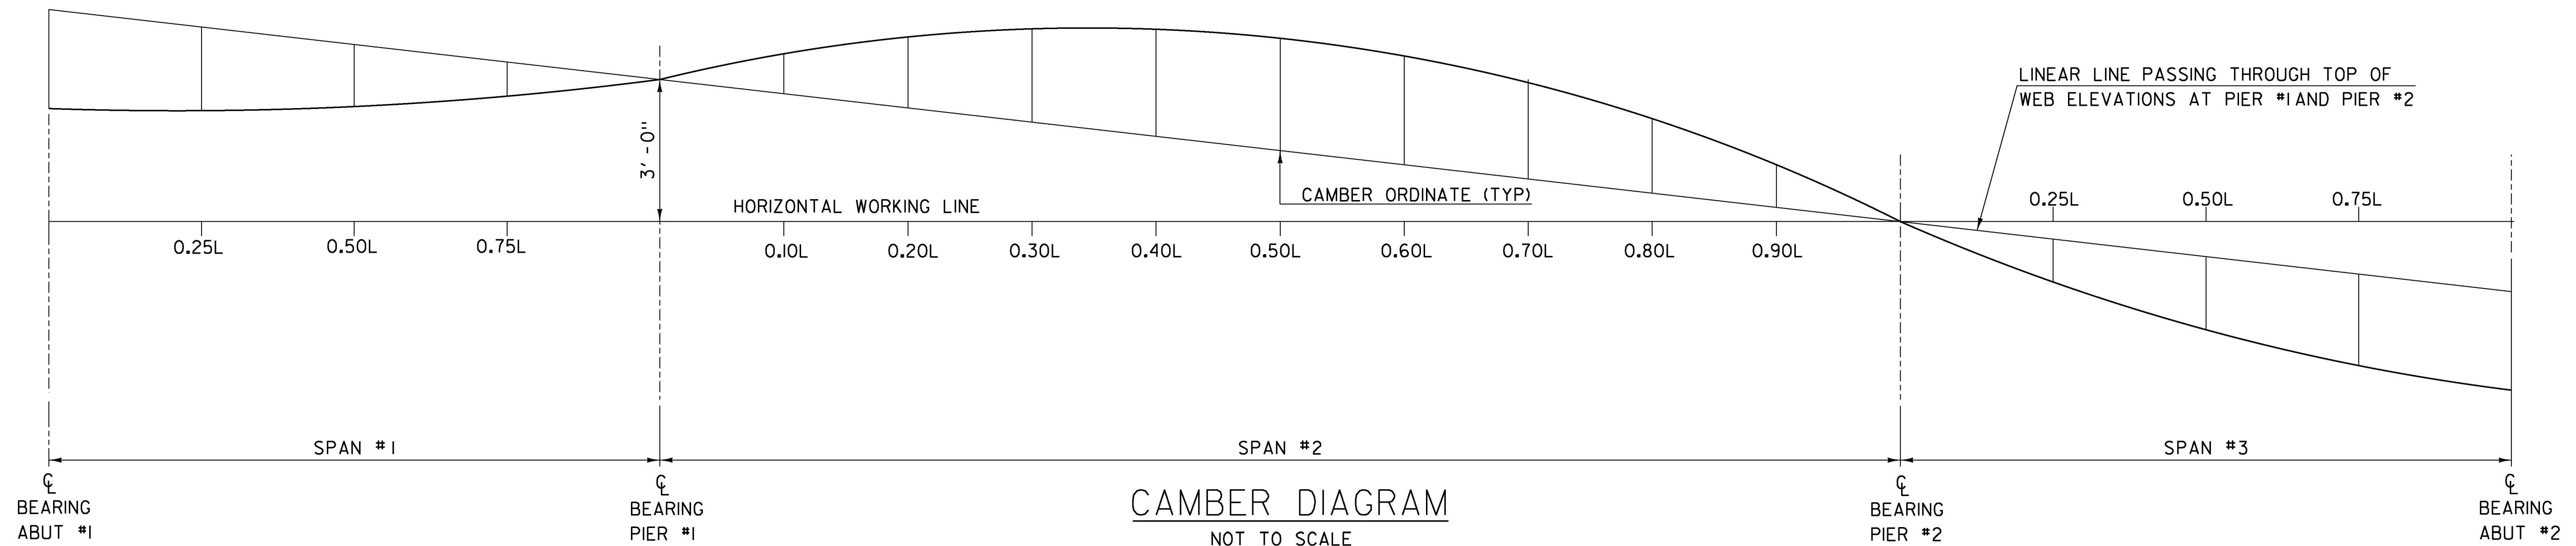

CAMBER DIAGRAM
NOT TO SCALE

GIRDER 1	ABUT #1	SPAN #1			PIER #1	SPAN #2									PIER #2	SPAN #3			ABUT #2
		0.25	0.5	0.75		0.1	0.2	0.3	0.4	0.5	0.6	0.7	0.8	0.9		0.25	0.5	0.75	
STEEL	-1/2	-3/8	-1/4	-1/8	0	5/16	9/16	3/4	15/16	15/16	15/16	3/4	9/16	1/4	0	-1/8	-1/4	-3/8	-1/2
ABUTMENT (SUPPORTED)	0	0	0	0	0	0	0	0	0	0	0	0	0	0	0	0	0	0	0
DECK	0	-1/16	-1/16	-1/16	0	1/4	5/8	15/16	13/16	11/4	11/8	15/16	5/8	1/4	0	-1/16	-1/16	-1/16	0
DC2 (RAIL)	0	0	0	0	0	0	0	0	0	0	0	0	0	0	0	0	0	0	0
DW	0	0	0	0	0	1/16	1/8	3/16	3/16	1/4	3/16	3/16	1/8	1/16	0	0	0	0	0
TOTAL DEFLECTION	-1/2	-7/16	-5/16	-3/16	0	5/8	15/16	17/8	25/16	27/16	21/4	17/8	15/16	9/16	0	-3/16	-5/16	-7/16	-1/2
VERTICAL CURVE CAMBER	3/8	5/16	3/16	1/16	0	-1/8	-1/4	-3/8	-7/16	-7/16	-7/16	-3/8	-1/4	-1/8	0	1/16	3/16	1/4	3/8
TOTAL CAMBER	-1/8	-1/8	-1/8	-1/16	0	7/16	1	11/2	113/16	115/16	113/16	11/2	1	7/16	0	-1/16	-1/8	-1/8	-1/8


GIRDER 2	ABUT #1	SPAN #1			PIER #1	SPAN #2									PIER #2	SPAN #3			ABUT #2
		0.25	0.5	0.75		0.1	0.2	0.3	0.4	0.5	0.6	0.7	0.8	0.9		0.25	0.5	0.75	
STEEL	-3/4	-9/16	-3/8	-3/16	0	7/16	7/8	13/16	13/8	17/16	13/8	13/16	13/16	7/16	0	-3/16	-3/8	-9/16	-3/4
ABUTMENT (SUPPORTED)	0	0	0	0	0	0	0	0	0	0	0	0	0	0	0	0	0	0	0
DECK	0	-1/16	-1/16	-1/16	0	5/16	11/16	1	11/4	13/8	11/4	1	11/16	5/16	0	-1/16	-1/16	-1/16	0
DC2 (RAIL)	0	0	0	0	0	0	0	0	0	0	0	0	0	0	0	0	0	0	0
DW	0	0	0	0	0	1/16	1/8	3/16	1/4	1/4	1/4	3/16	1/8	1/16	0	0	0	0	0
TOTAL DEFLECTION	-3/4	-5/8	-7/16	-1/4	0	13/16	111/16	23/8	27/8	31/16	27/8	23/8	15/8	13/16	0	-1/4	-7/16	-5/8	-3/4
VERTICAL CURVE CAMBER	3/8	5/16	3/16	1/16	0	-1/8	-1/4	-3/8	-7/16	-7/16	-7/16	-3/8	-1/4	-1/8	0	1/16	3/16	1/4	3/8
TOTAL CAMBER	-3/8	-3/8	-1/4	-3/16	0	5/8	13/8	2	27/16	29/16	27/16	2	15/16	5/8	0	-3/16	-5/16	-3/8	-7/16

GIRDER 3	ABUT #1	SPAN #1			PIER #1	SPAN #2									PIER #2	SPAN #3			ABUT #2
		0.25	0.5	0.75		0.1	0.2	0.3	0.4	0.5	0.6	0.7	0.8	0.9		0.25	0.5	0.75	
STEEL	-11/16	-13/16	-9/16	-1/4	0	5/8	11/8	19/16	17/8	115/16	113/16	19/16	11/8	9/16	0	-5/16	-9/16	-13/16	-11/16
ABUTMENT (SUPPORTED)	0	0	0	0	0	0	0	0	0	0	0	0	0	0	0	0	0	0	0
DECK	0	-1/16	-1/16	-1/16	0	5/16	3/4	11/8	13/8	17/16	13/8	11/8	11/16	5/16	0	-1/16	-1/16	-1/16	0
DC2 (RAIL)	0	0	0	0	0	0	0	0	0	0	0	0	0	0	0	0	0	0	0
DW	0	0	0	0	0	1/16	1/8	3/16	1/4	1/4	1/4	3/16	1/8	1/16	0	0	0	0	0
TOTAL DEFLECTION	-11/16	-7/8	-5/8	-5/16	0	1	2	27/8	31/2	35/8	37/16	27/8	115/16	15/16	0	-3/8	-5/8	-7/8	-11/16
VERTICAL CURVE CAMBER	3/8	5/16	3/16	1/16	0	-1/8	-1/4	-3/8	-7/16	-7/16	-7/16	-3/8	-1/4	-1/8	0	1/16	3/16	1/4	3/8
TOTAL CAMBER	-11/16	-9/16	-7/16	-1/4	0	13/16	13/4	21/2	31/16	33/16	3	21/2	111/16	13/16	0	-1/4	-7/16	-9/16	-11/16

GIRDER 4	ABUT #1	SPAN #1			PIER #1	SPAN #2									PIER #2	SPAN #3			ABUT #2
		0.25	0.5	0.75		0.1	0.2	0.3	0.4	0.5	0.6	0.7	0.8	0.9		0.25	0.5	0.75	
STEEL	-13/8	-11/16	-11/16	-5/16	0	3/4	17/16	2	25/16	27/16	25/16	115/16	17/16	3/4	0	-3/8	-11/16	-11/16	-13/8
ABUTMENT (SUPPORTED)	0	0	0	0	0	0	0	0	0	0	0	0	0	0	0	0	0	0	0
DECK	0	-1/16	-1/16	-1/16	0	3/8	13/16	13/16	11/2	19/16	11/2	13/16	3/4	5/16	0	-1/16	-1/16	-1/16	0
DC2 (RAIL)	0	0	0	0	0	0	0	0	0	1/16	1/16	1/16	0	0	0	0	0	0	0
DW	0	0	0	0	0	1/16	1/8	1/4	5/16	5/16	1/4	1/8	1/16	0	0	0	0	0	0
TOTAL DEFLECTION	-13/8	-11/8	-3/4	-3/8	0	13/16	23/8	37/16	43/16	43/8	43/16	33/8	25/16	11/8	0	-7/16	-3/4	-11/8	-13/8
VERTICAL CURVE CAMBER	3/8	5/16	3/16	1/16	0	-1/8	-1/4	-3/8	-7/16	-7/16	-7/16	-3/8	-1/4	-1/8	0	1/16	3/16	1/4	3/8
TOTAL CAMBER	-1	-13/16	-9/16	-5/16	0	1	21/16	3	35/8	313/16	35/8	3	21/16	1	0	-5/16	-5/8	-13/16	-1

GIRDER 5	ABUT #1	SPAN #1			PIER #1	SPAN #2									PIER #2	SPAN #3			ABUT #2
		0.25	0.5	0.75		0.1	0.2	0.3	0.4	0.5	0.6	0.7	0.8	0.9		0.25	0.5	0.75	
STEEL	-15/8	-11/4	-13/16	-7/16	0	15/16	13/4	23/8	213/16	215/16	213/16	23/8	7/8	0	-7/16	-7/8	-11/4	-11/16	
ABUTMENT (SUPPORTED)	0	0	0	0	0	0	0	0	0	0	0	0	0	0	0	0	0	0	0
DECK	0	-1/16	-1/16	-1/16	0	3/8	7/8	15/16	19/16	111/16	19/16	11/4	13/16	3/8	0	-1/16	-1/16	-1/16	0
DC2 (RAIL)	0	0	0	0	0	0	0	1/16	1/16	1/16	1/16	1/16	0	0	0	0	0	0	0
DW	0	0	0	0	0	1/16	3/16	1/4	5/16	5/16	1/4	3/16	1/16	0	0	0	0	0	0
TOTAL DEFLECTION	-15/8	-15/16	-7/8	-1/2	0	13/8	213/16	4	43/4	5	43/4	315/16	211/16	15/16	0	-1/2	-15/16	-15/16	-11/16
VERTICAL CURVE CAMBER	3/8	5/16	3/16	1/16	0	-1/8	-1/4	-3/8	-7/16	-7/16	-7/16	-3/8	-1/4	-1/8	0	1/16	3/16	1/4	3/8
TOTAL CAMBER	-15/16	-11/16	-3/4	-3/8	0	13/16	27/16	31/2	41/4	41/2	43/16	31/2	27/16	11/8	0	-7/16	-3/4	-11/16	-15/16

CAMBER TABLES

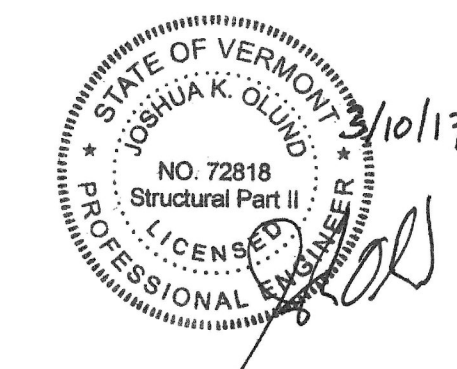

TYLIN INTERNATIONAL

PROJECT NAME:	MORRISTOWN	FILE NAME:	s78f329sup.dgn	PLOT DATE:	I2-APR-2017
PROJECT NUMBER:	BRS 0240(3)S/STP HES 030-2(28)	PROJECT LEADER:	C. CARLSON	DRAWN BY:	G. ROKES
		DESIGNED BY:	T. POULIN	CHECKED BY:	J. OLUND
		CAMBER AND DEFLECTION		SHEET	86 OF 175