


ABUTMENT #2 PLAN

SCALE 1/4" = 1'-0"

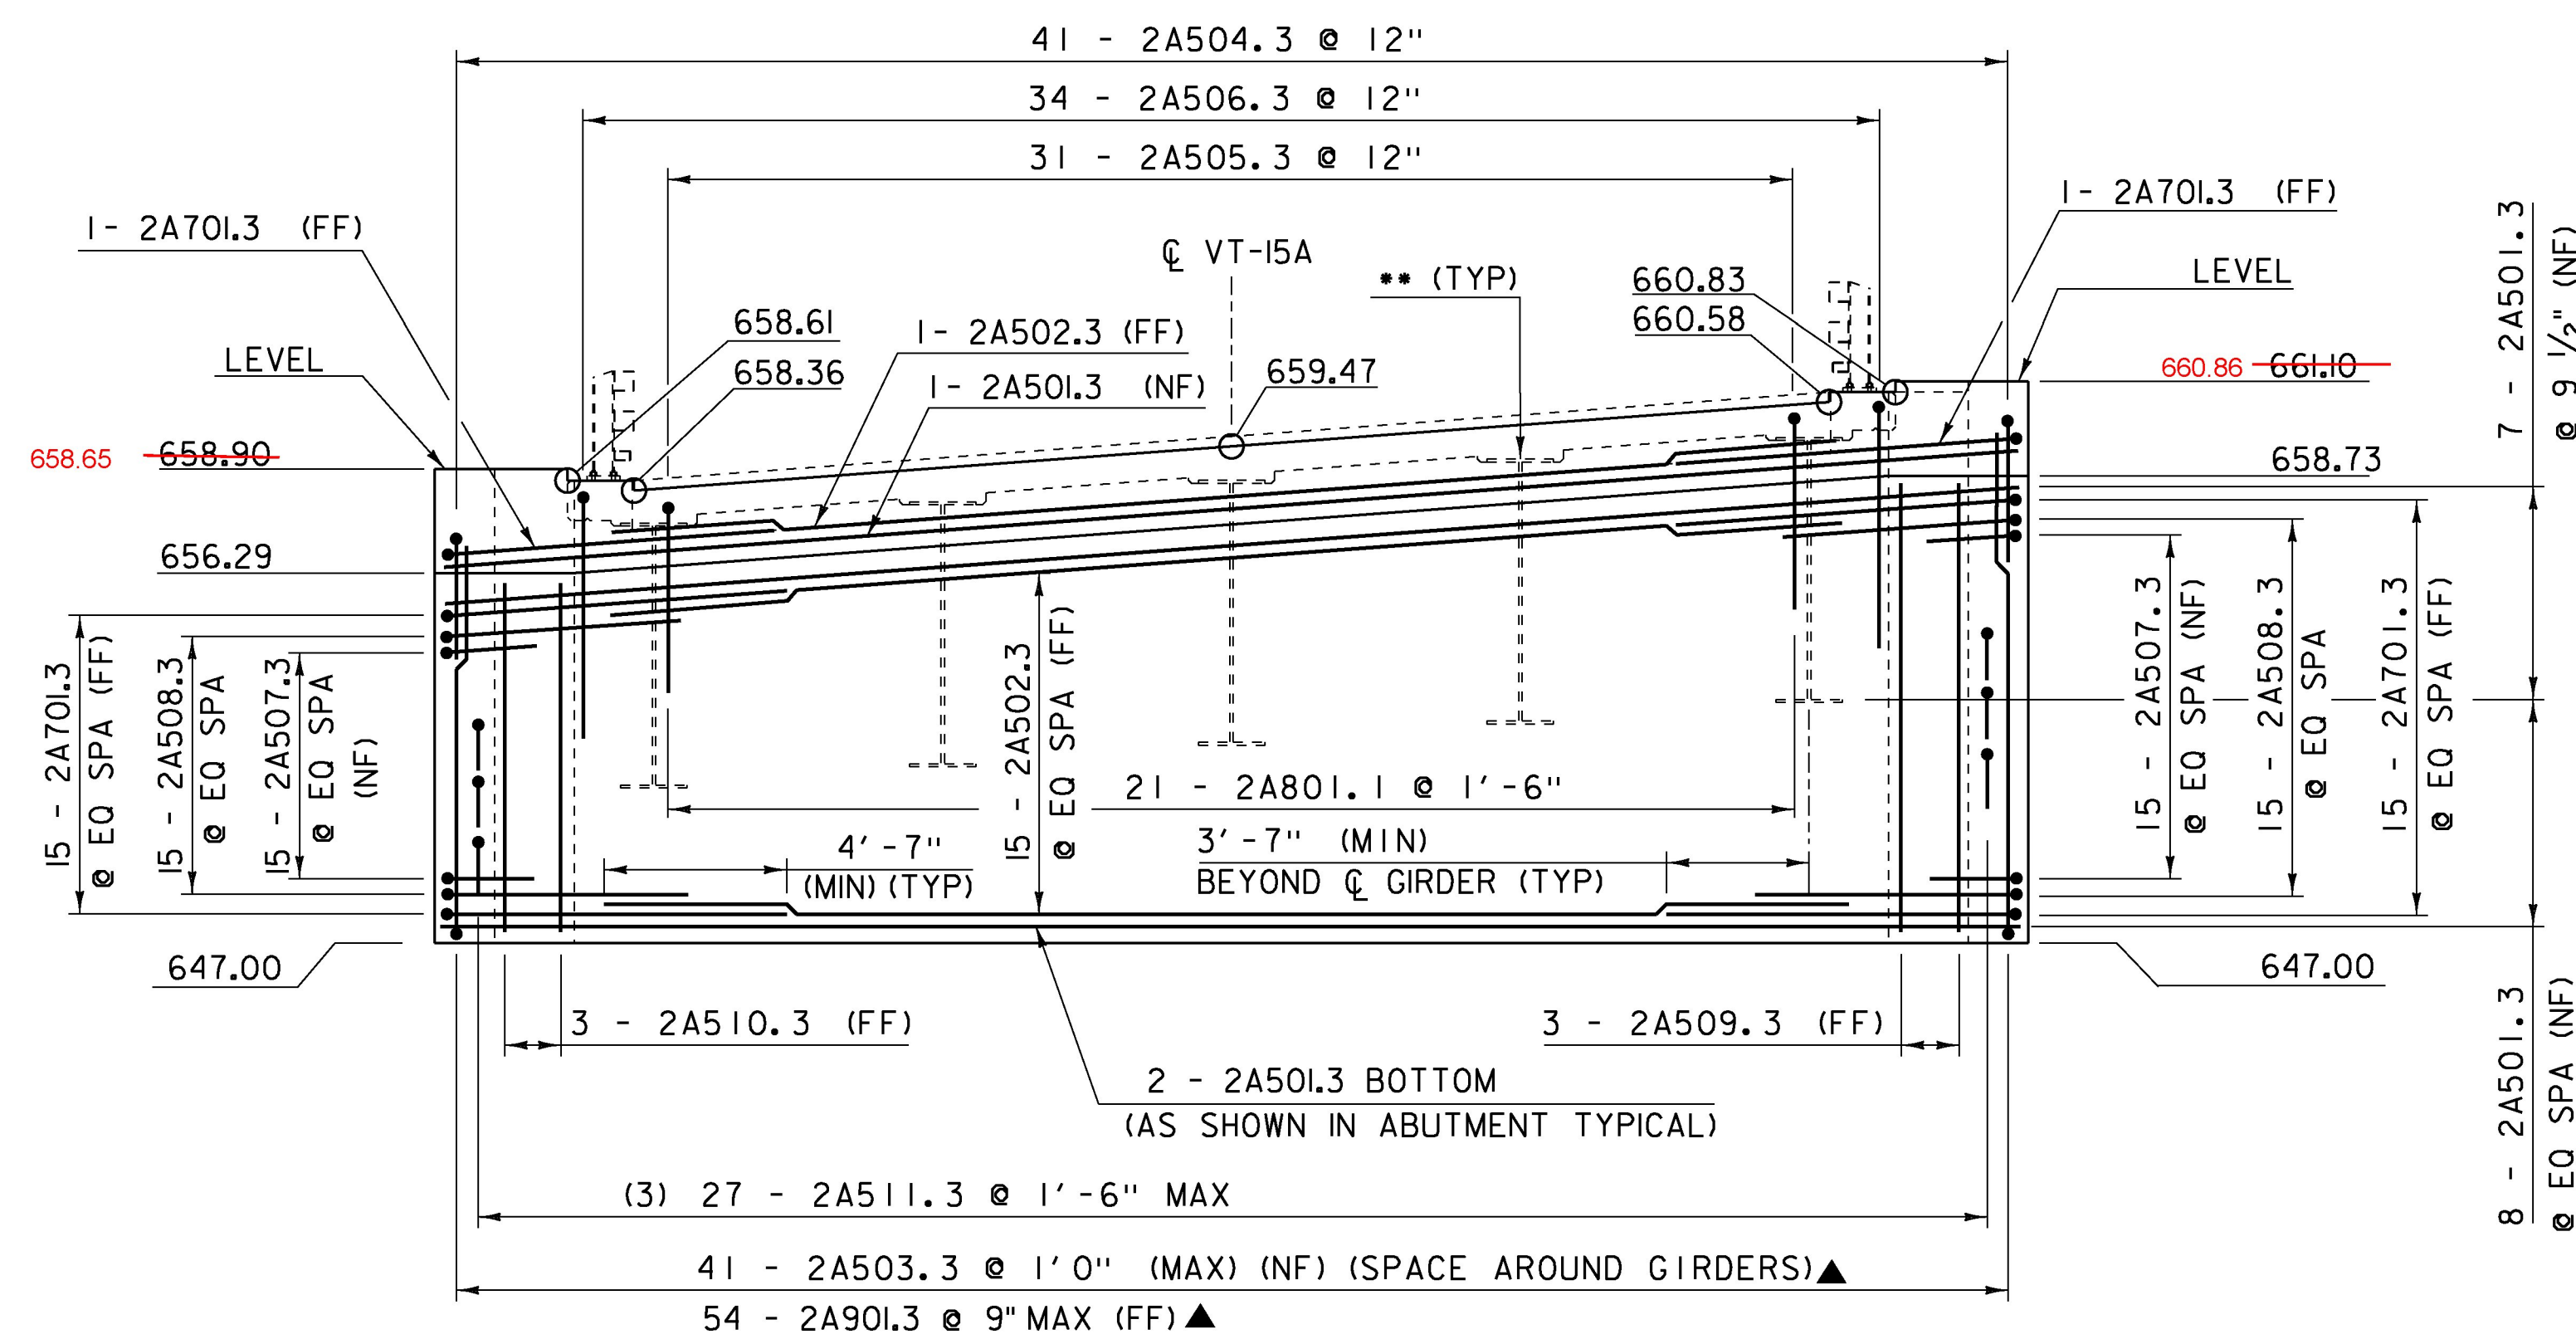


ABUTMENT #2 ELEVATION

SCALE 1/4" = 1'-0"

- ANTICIPATED TOP OF GIRDER ELEVATIONS AT THE COMPLETION OF STEEL FRAMING ERECTION ARE:
- GIRDER 1 = 657.42
 - GIRDER 2 = 657.96
 - GIRDER 3 = 658.49
 - GIRDER 4 = 659.03
 - GIRDER 5 = 659.57

NOTE:

- NF = NEAR FACE
- FF = FAR FACE
- EF = EACH FACE
- ▲ = CUT TO FIT IN FIELD
- 3" CLEAR, UNLESS OTHERWISE SPECIFIED ON THE PLANS.
- 2'-2" BAR LAP UNLESS OTHERWISE SPECIFIED ON THE PLANS.
- EQ SPA = EQUALLY SPACED

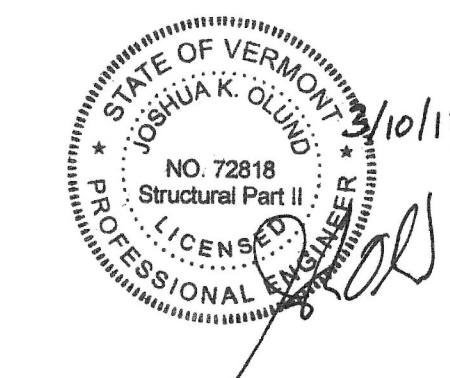

TYLIN INTERNATIONAL

PROJECT NAME:	MORRISTOWN
PROJECT NUMBER:	BRS 0240(3)S/STP HES 030-2(28)
FILE NAME:	s78f329sub.dgn
PROJECT LEADER:	C. CARLSON
DESIGNED BY:	J. OLUND
ABUTMENT #2 PLAN AND ELEVATION	
PLOT DATE:	12-APR-2017
DRAWN BY:	G. ROKES
CHECKED BY:	T. POULIN
SHEET	89 OF 175