


PIER #2 ELEVATION
 SCALE 1/2" = 1'-0"
 (LOOKING UPSTATION)

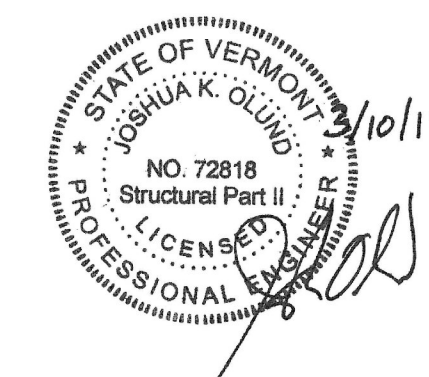

NOTE:
 NF = NEAR FACE
 FF = FAR FACE
 EF = EACH FACE
 ▲ = CUT TO FIT IN FIELD
 4" CLEAR, UNLESS OTHERWISE SPECIFIED ON THE PLANS.
 2'-1" BAR LAP UNLESS OTHERWISE SPECIFIED ON THE PLANS.

PROJECT NAME:	MORRISTOWN
PROJECT NUMBER:	BRS 0240(3)S/STP HES 030-2(28)
FILE NAME:	s78f329sub.dgn
PROJECT LEADER:	C. CARLSON
DESIGNED BY:	D. MYERS
PIER #2 ELEVATION REBAR SHEET	
PLOT DATE:	12-APR-2017
DRAWN BY:	G. ROKES
CHECKED BY:	J. OLUND
SHEET	93 OF 175

TYLIN INTERNATIONAL