




106+00

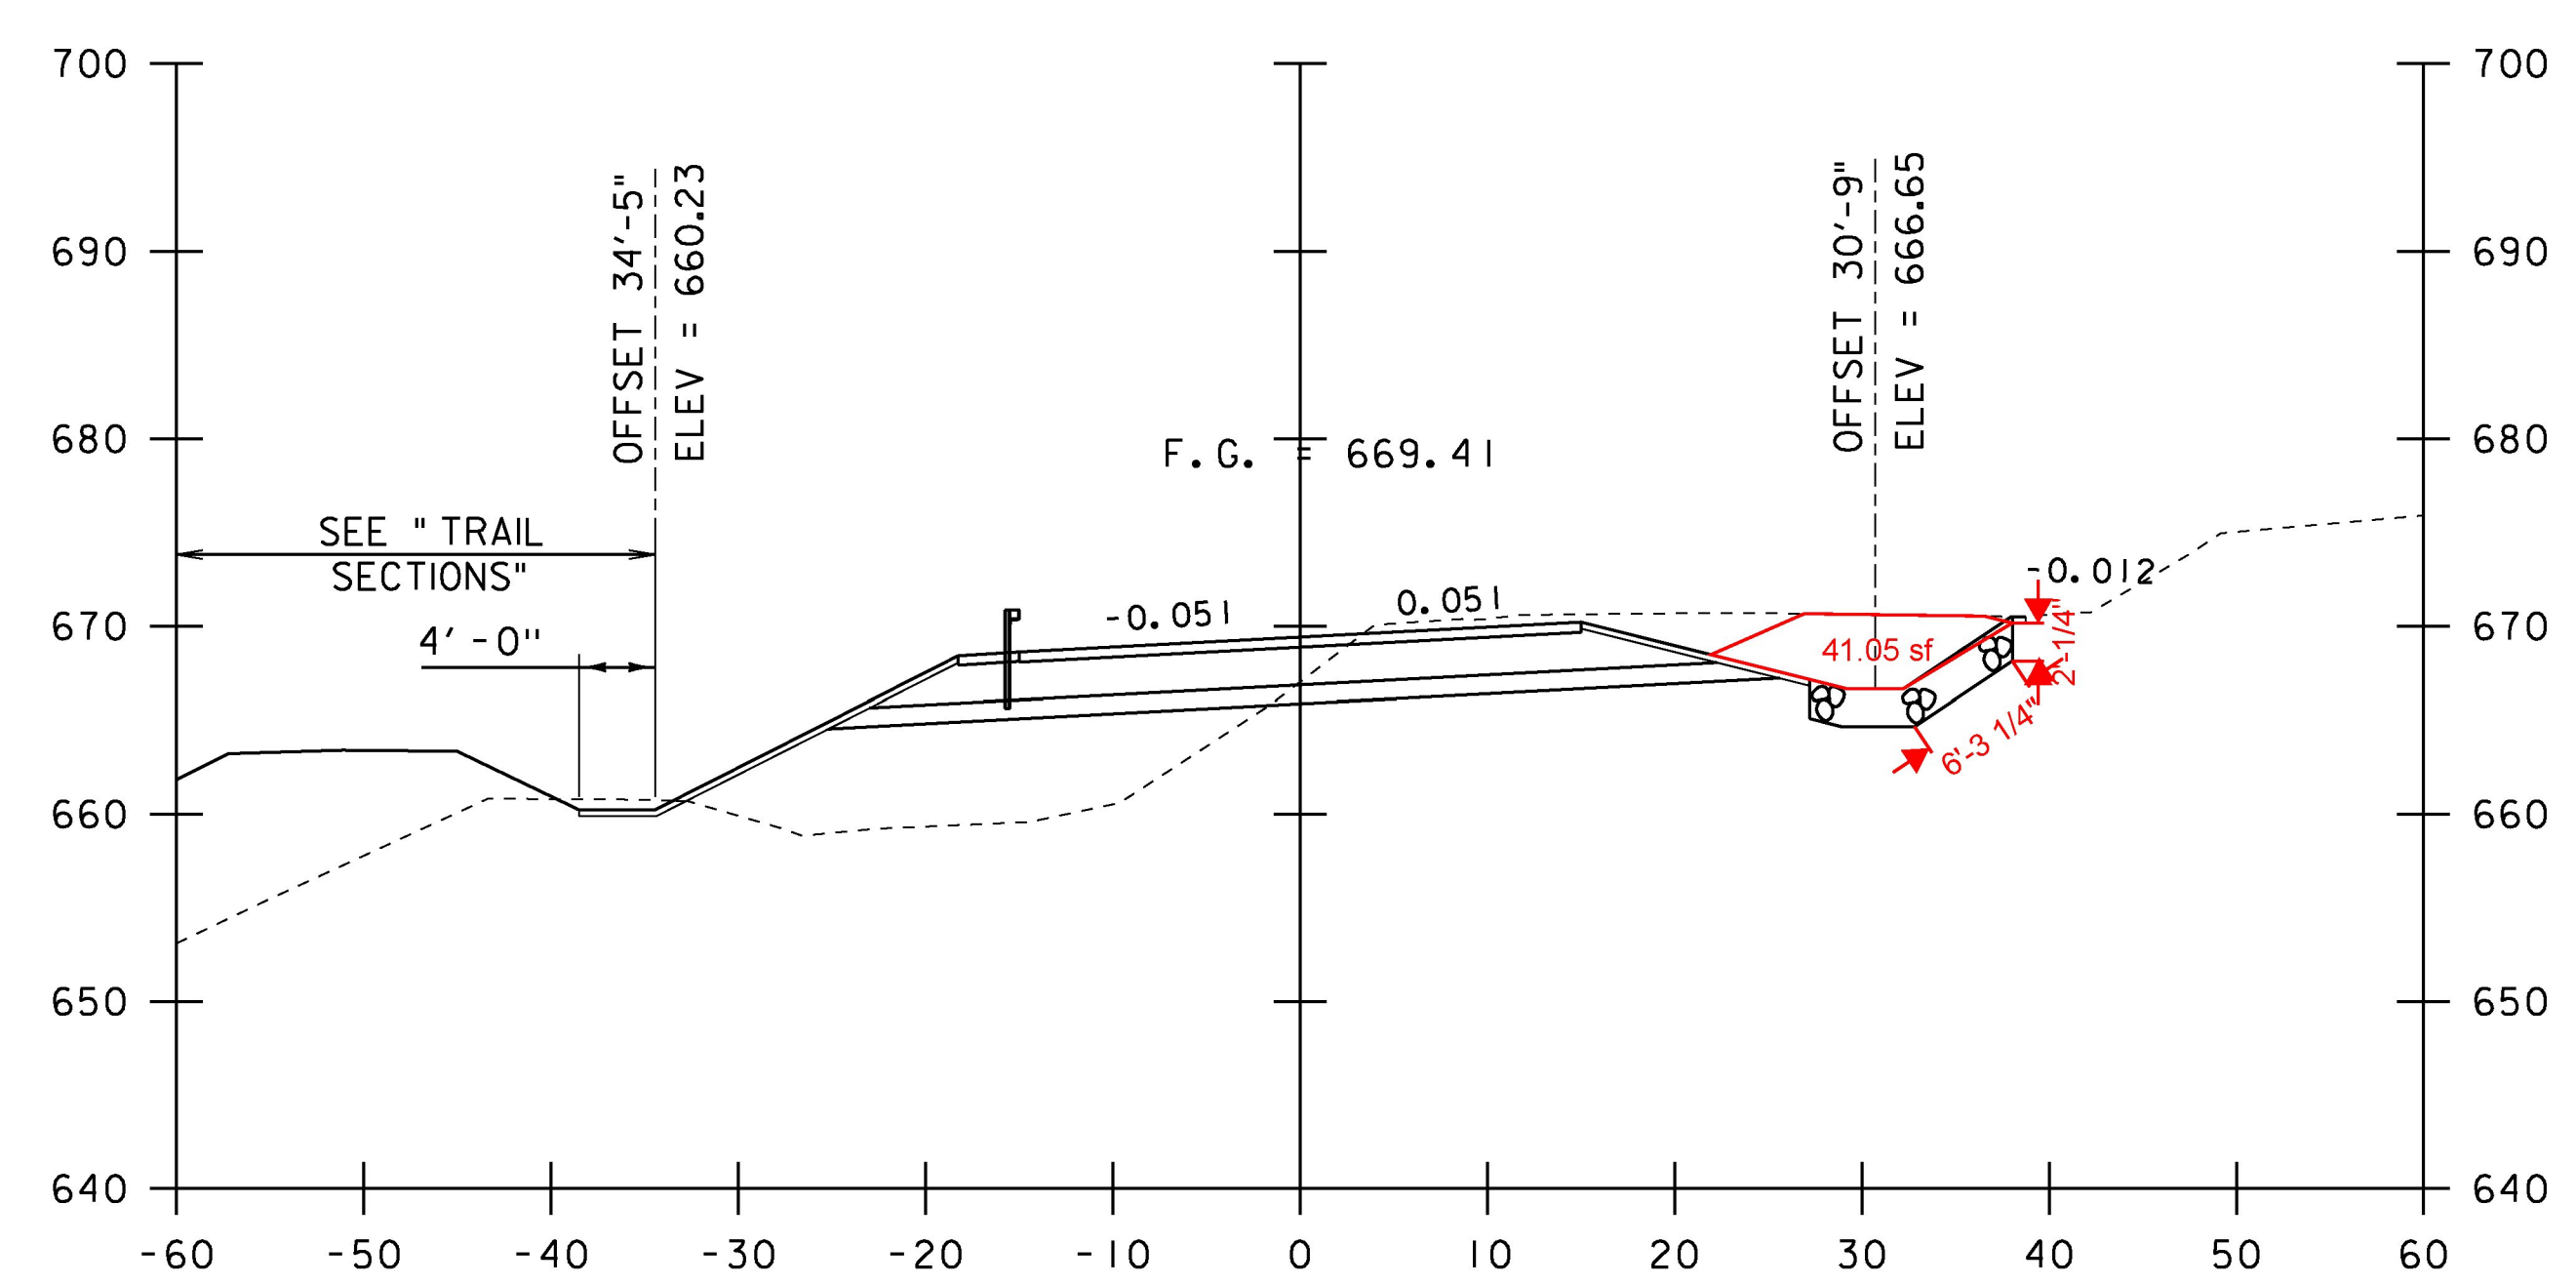

107+00

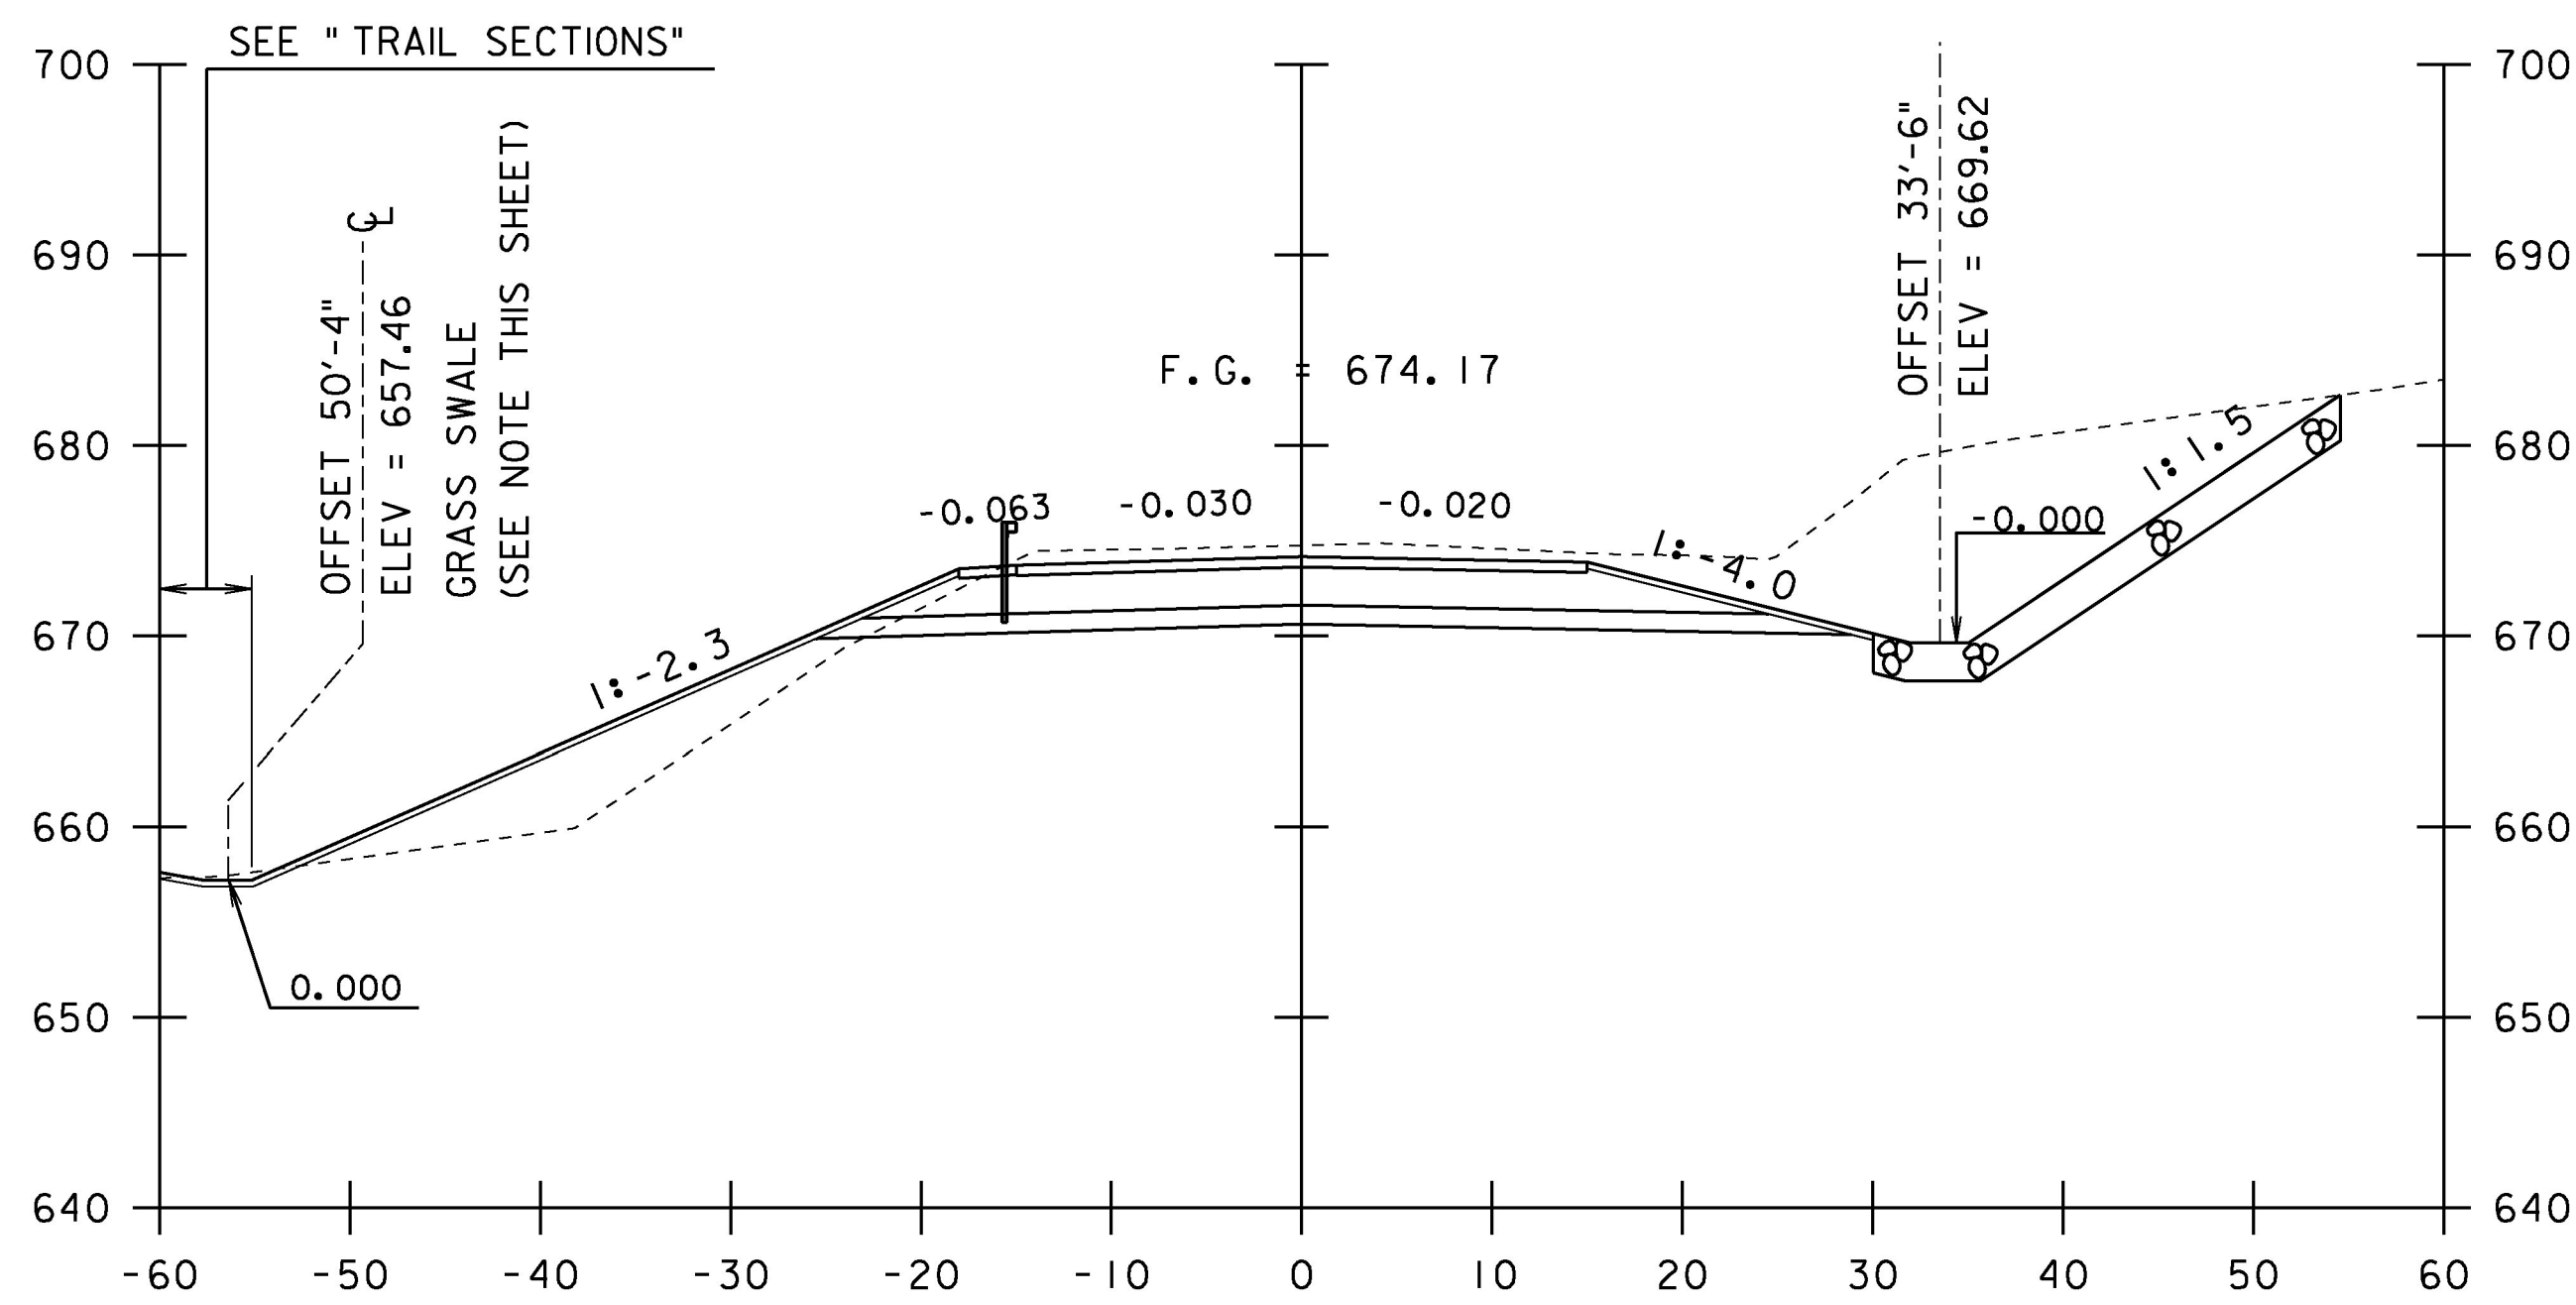

105+50

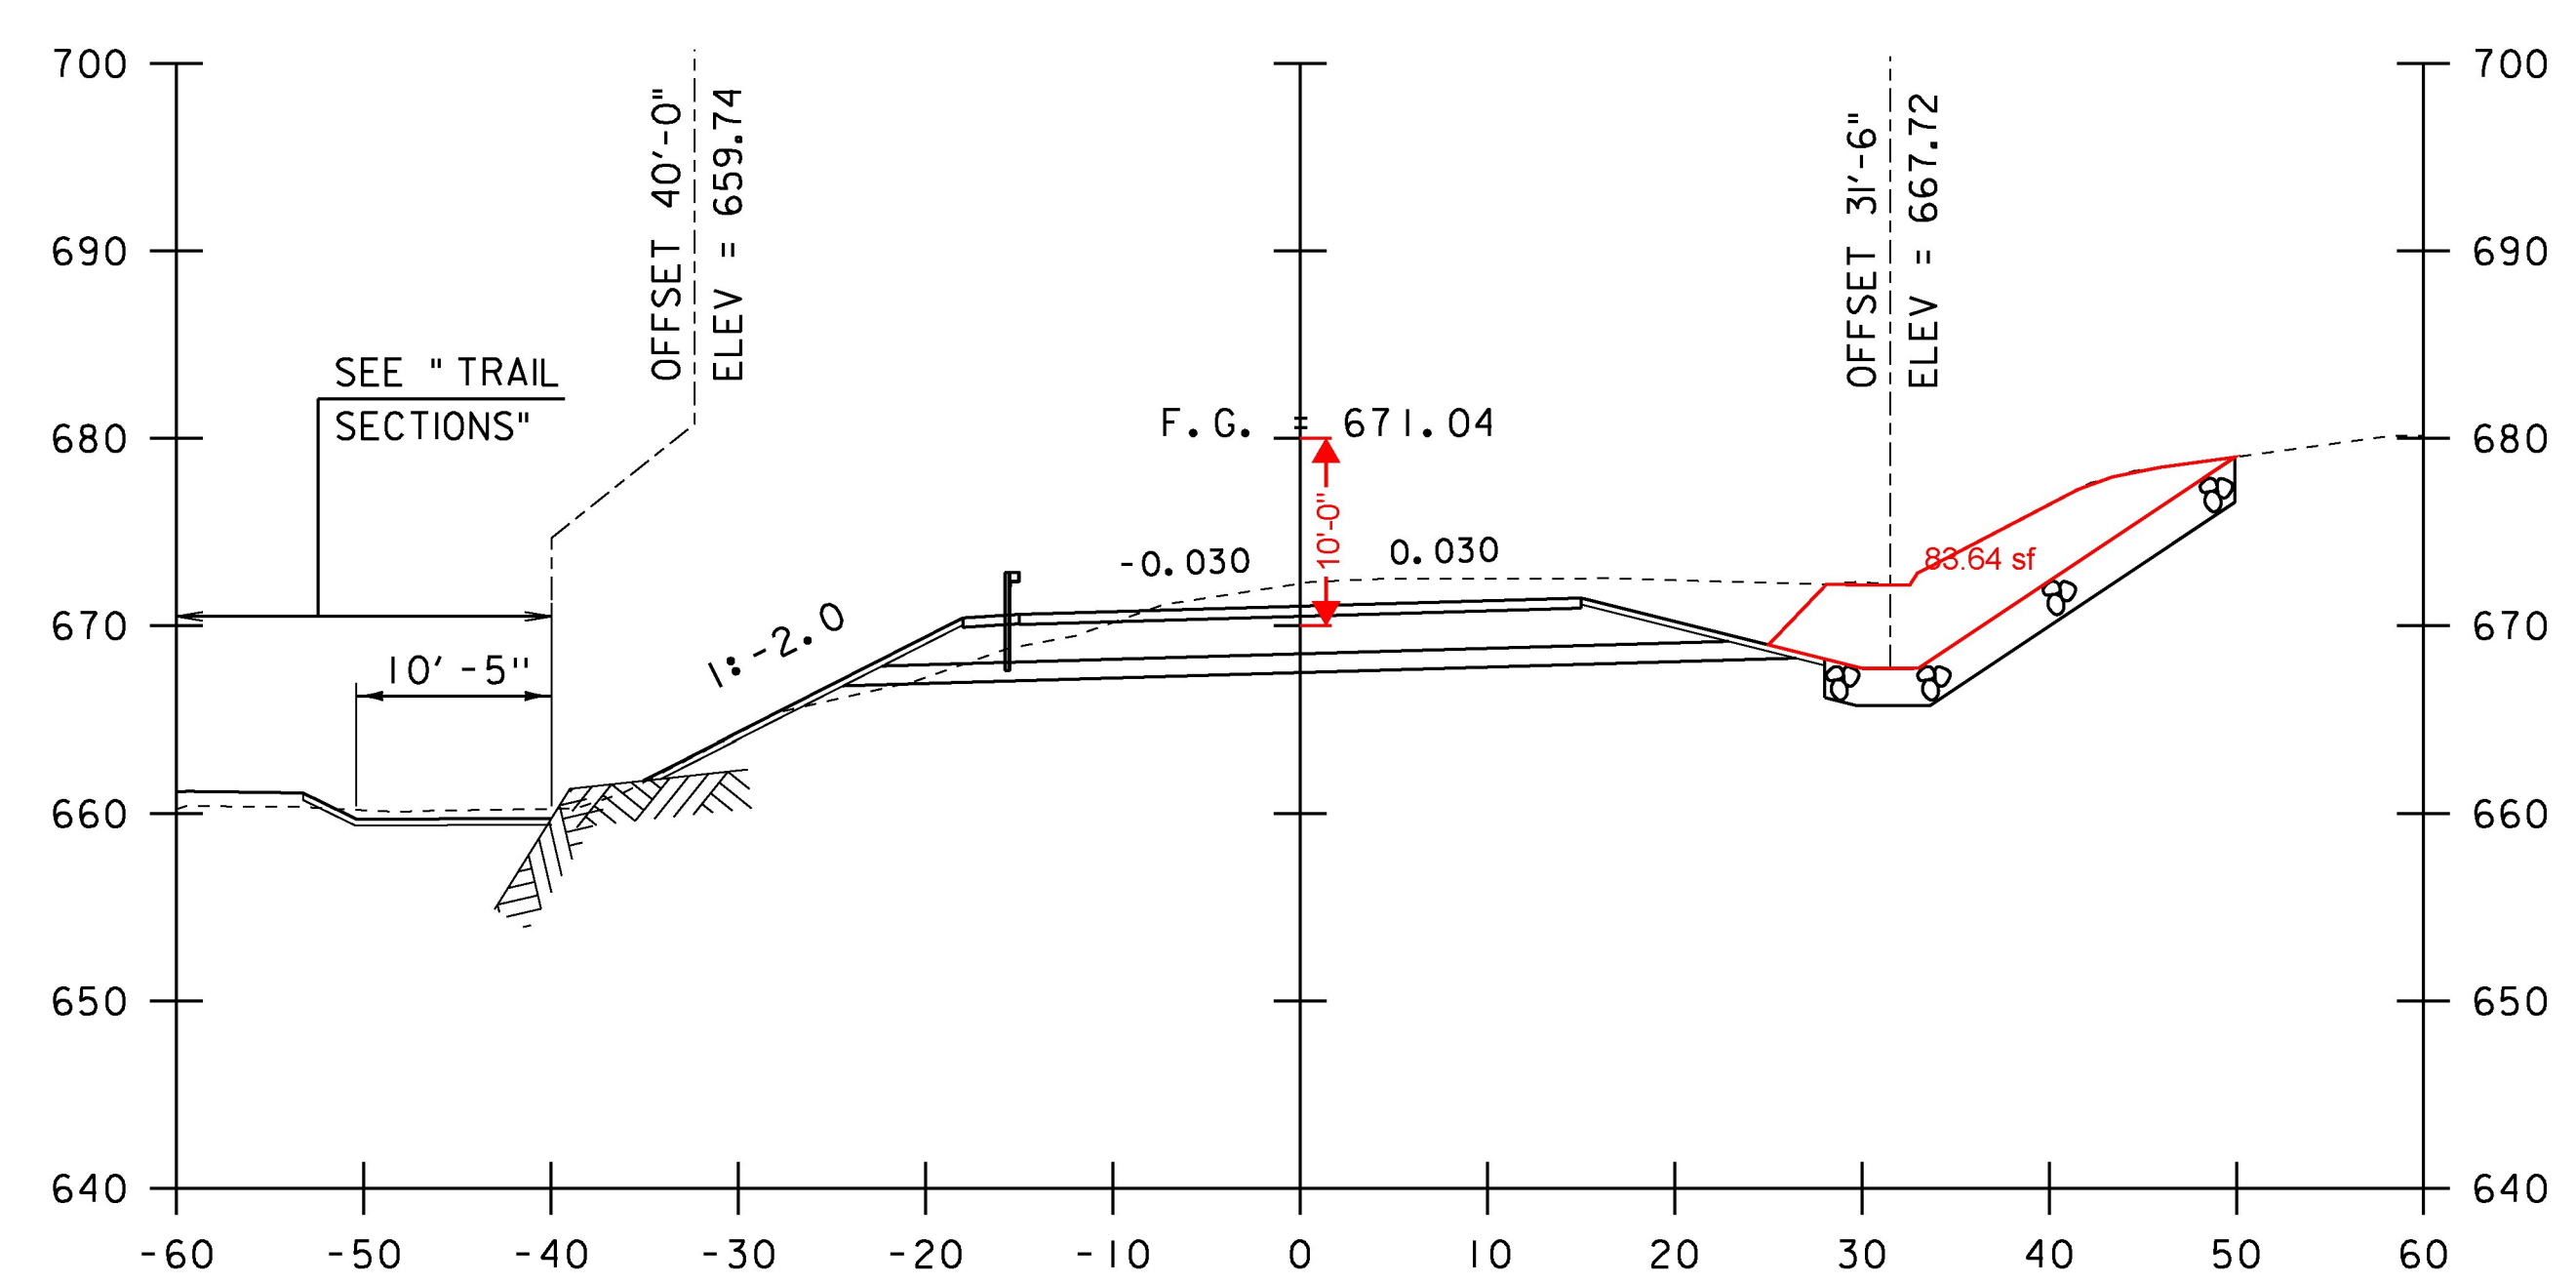

106+50

2 REMOVE EXISTING 18" CGMP FROM STA. 105+89.51 27'-4" LT TO STA. 105+87.76 26'-6" RT

NOTE: FOR ADDITIONAL INFORMATION REGARDING THE STORMWATER GRASS TREATMENT SWALE, SEE "GRASS TREATMENT SWALE PLAN" SHEET FOR ALIGNMENT INFORMATION, "GRASS TREATMENT SWALE PROFILE" ON THE "DRAINAGE SYSTEMS PROFILES" SHEET AND THE "GRASS TREATMENT SWALE SECTIONS" SHEETS.

STA. 105+50 TO STA. 107+00

PROJECT NAME:	MORRISTOWN
PROJECT NUMBER:	BRS 0240(3)S/STP HES 030-2(28)
FILE NAME:	s78f329xs.dgn
PROJECT LEADER:	C. CARLSON
DESIGNED BY:	C. BURRALL
VT 15A SECTIONS SHEET 3	
PLOT DATE:	12-APR-2017
DRAWN BY:	G. ROKES
CHECKED BY:	J. LACROIX
SHEET	104 OF 175