



107+50

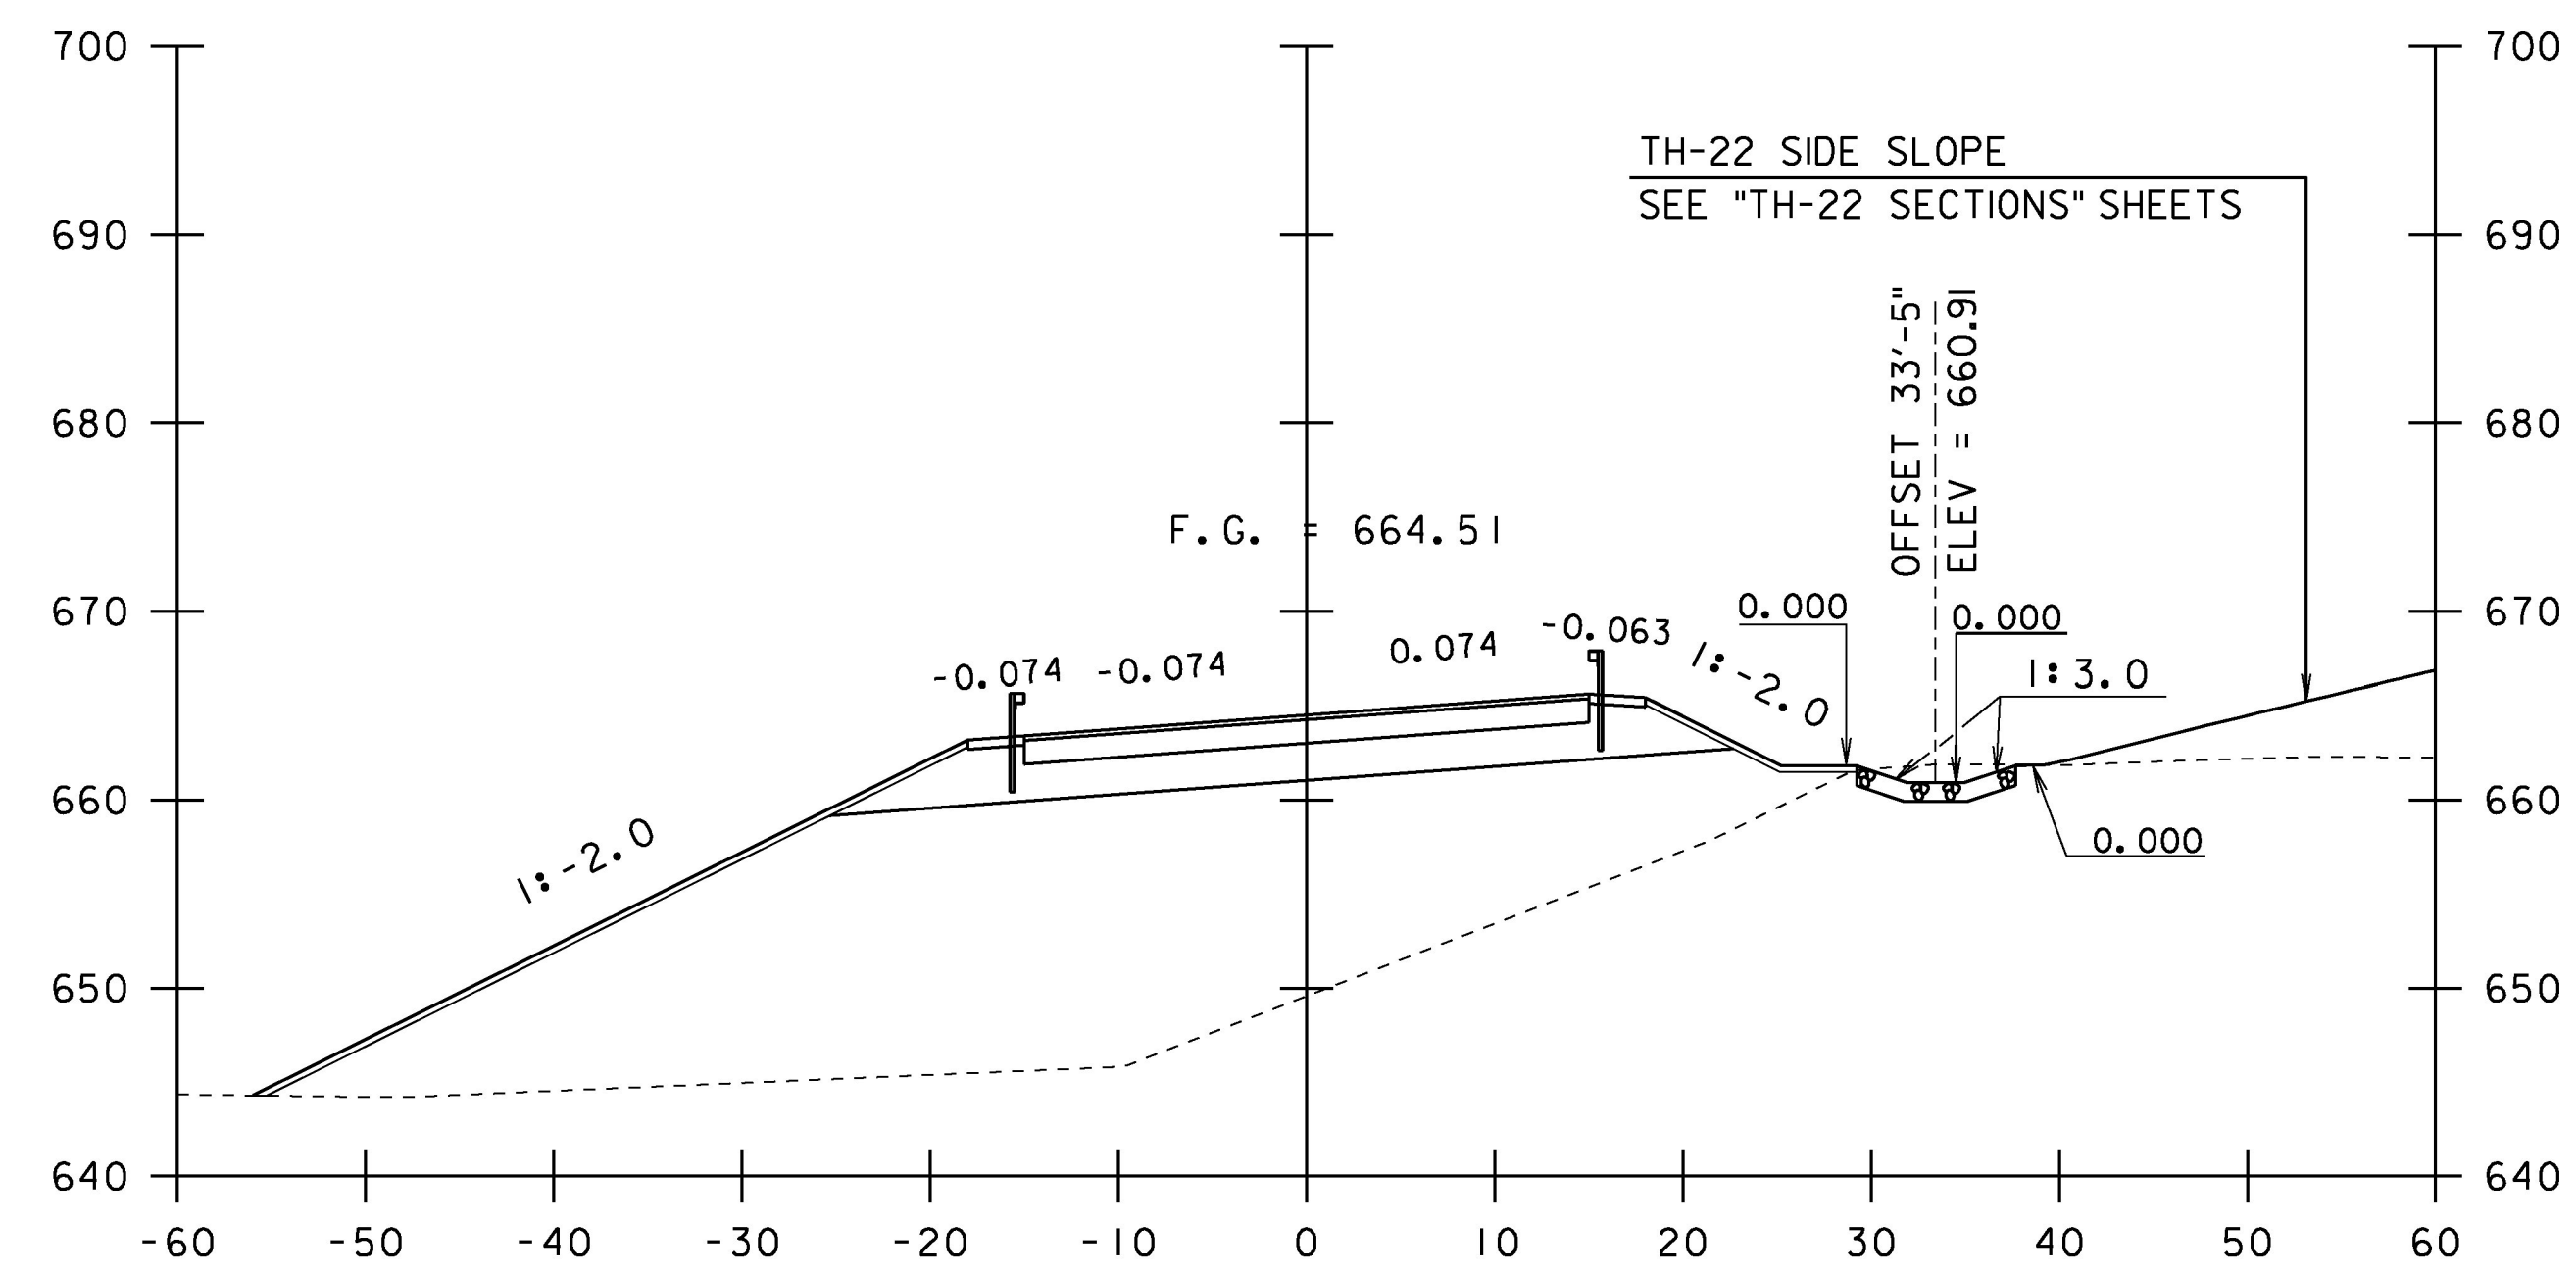


108+50

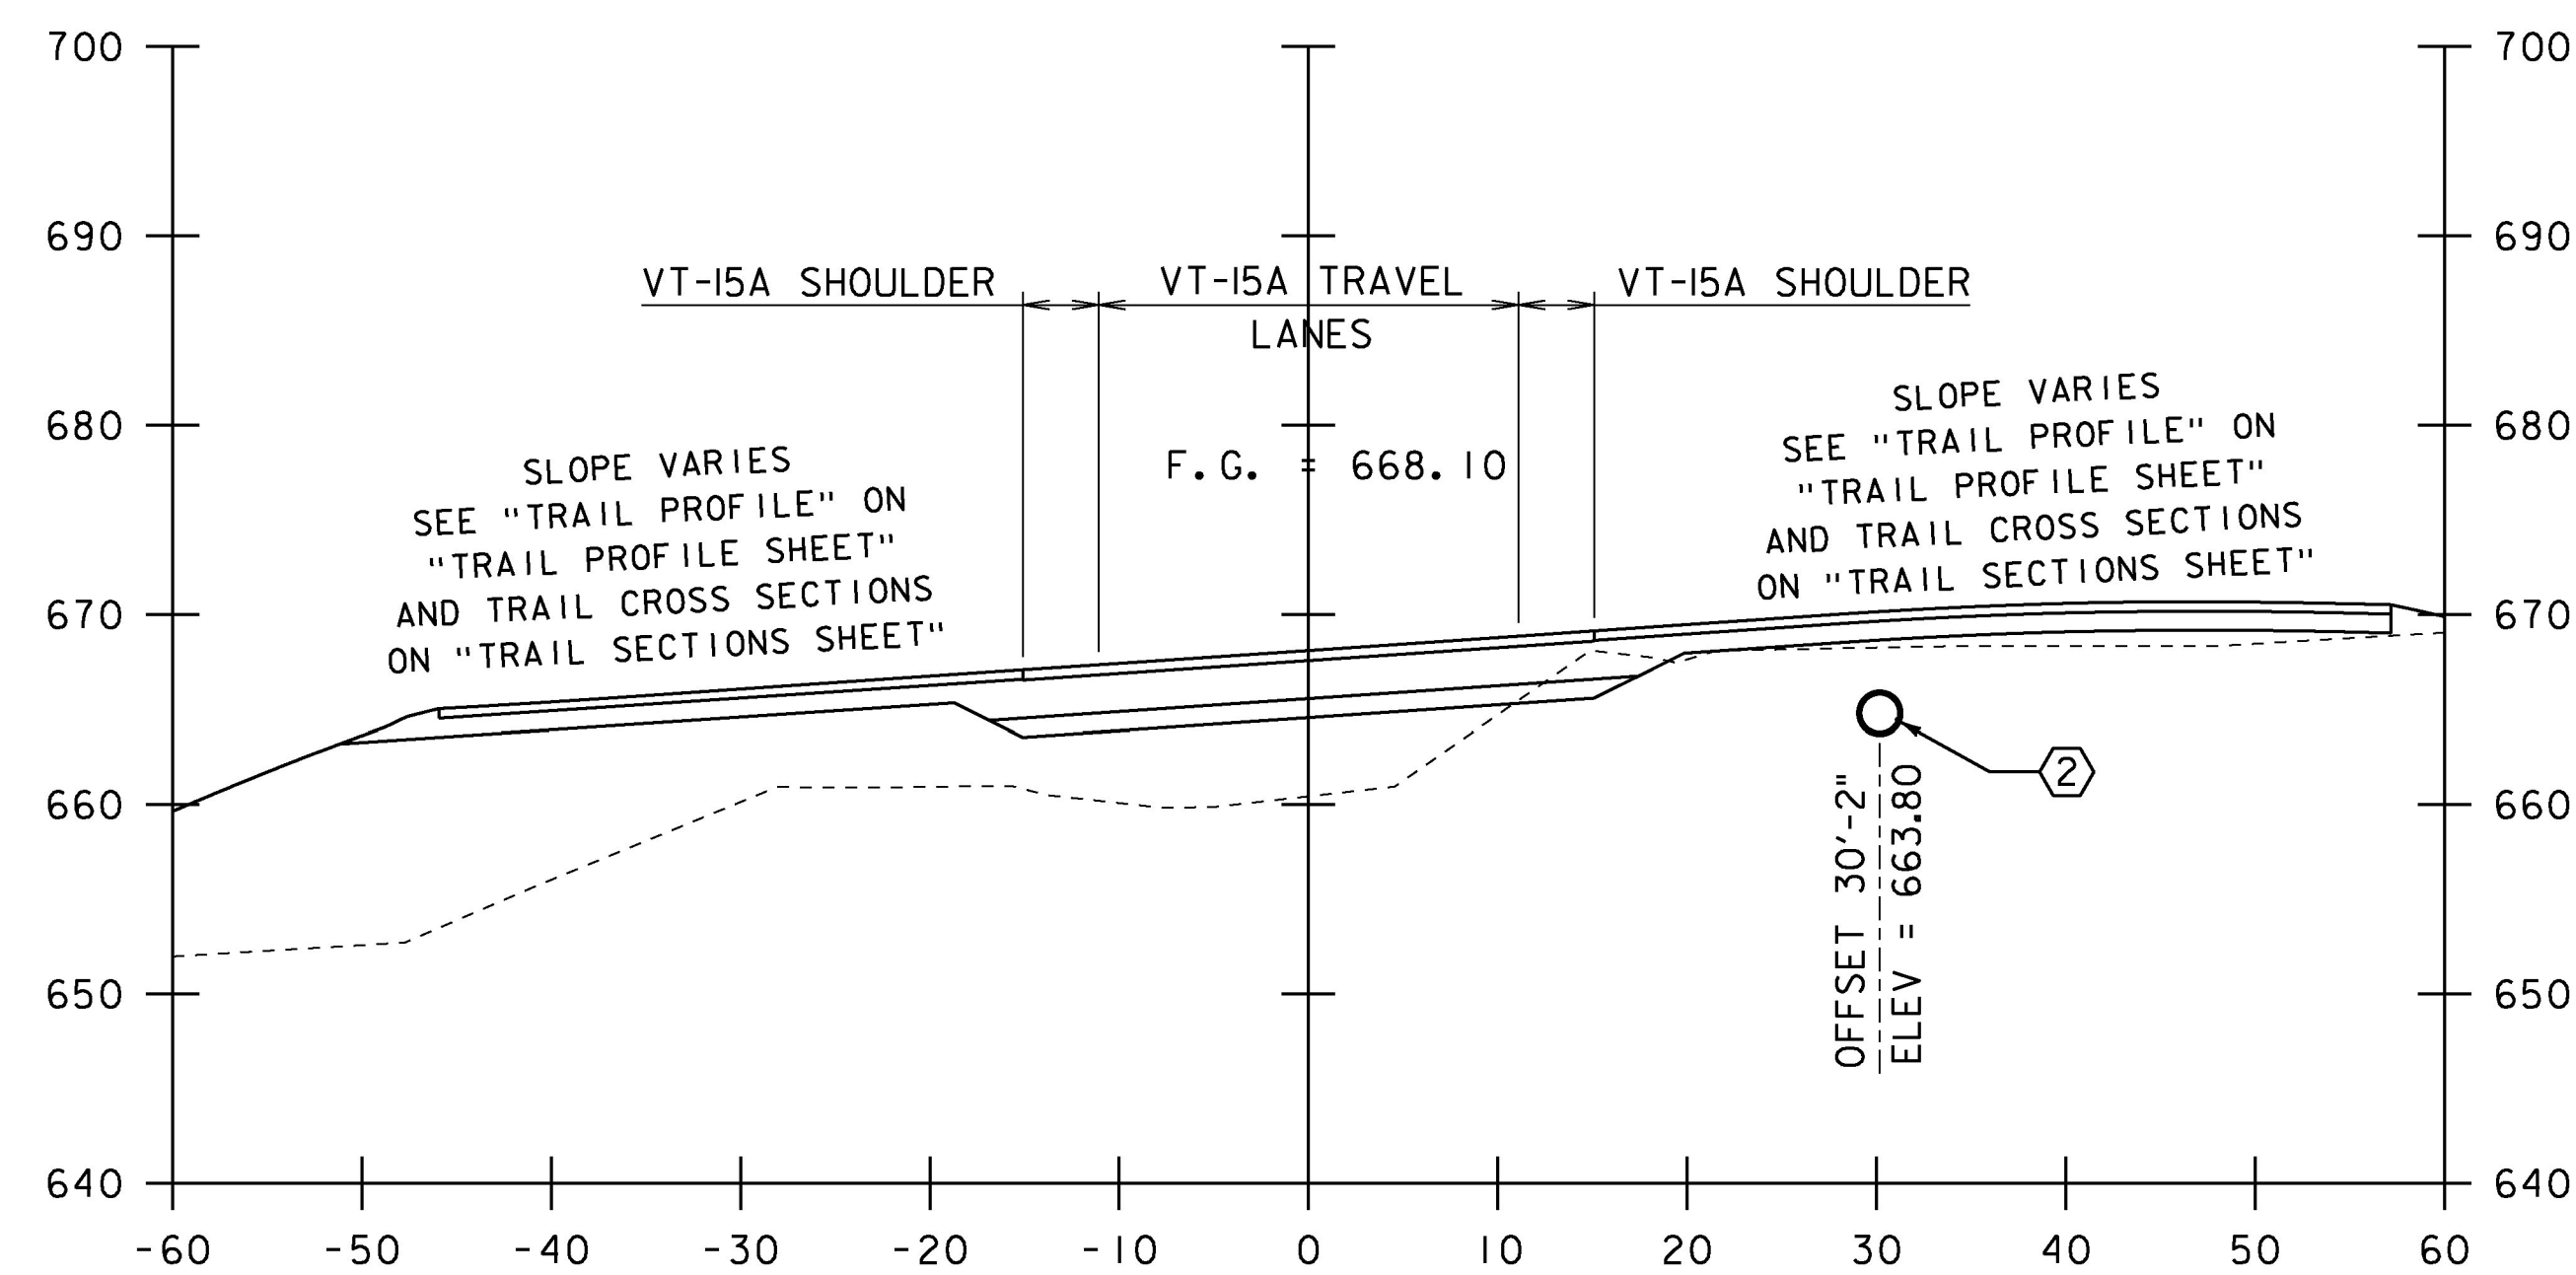

107+40

INTERSECTION VT-15A AND  
RAIL CROSSING STA. 55+59.67 (SKEWED)

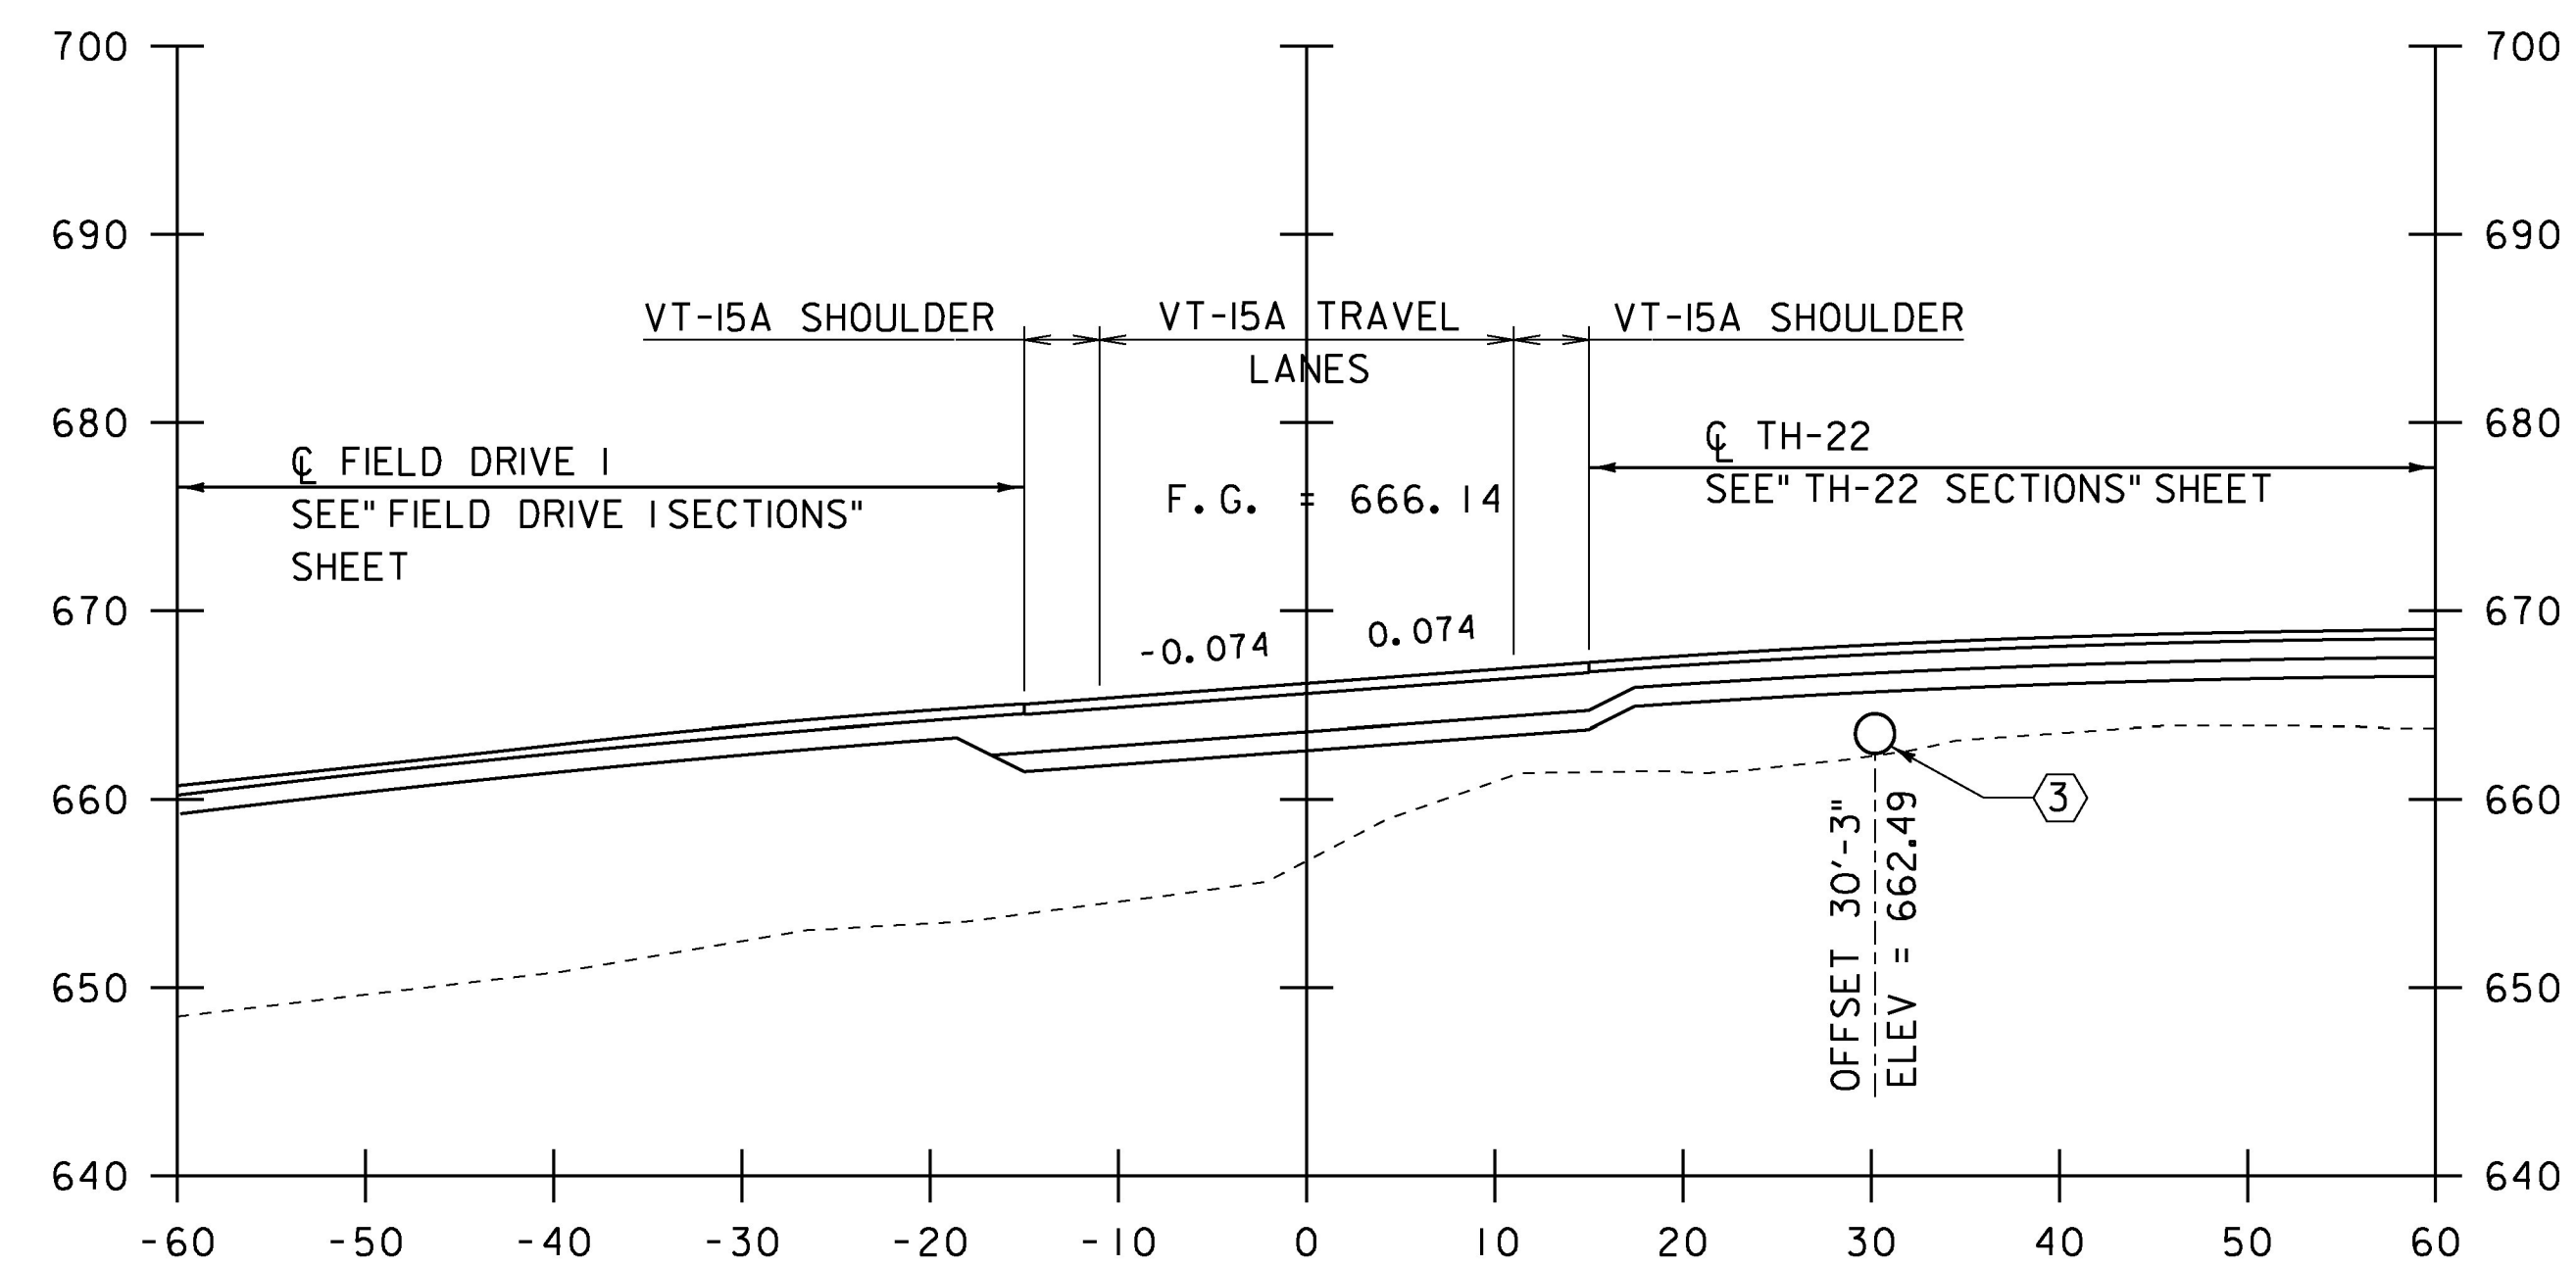

108+00

VT-15A INTERSECTION WITH  
FIELD DRIVE I STA. 10+00.00 LT  
AND TH-22 20+00.00 RT

- ① NEW 24 INCH DIA. PIPE  
SEE "TH-22 AND TRAIL DRAINAGE PROFILE"  
ON THE "DRAINAGE SYSTEMS PROFILE" SHEET
- ③ NEW 24 INCH DIA. PIPE  
SEE "TH-22 AND TRAIL DRAINAGE PROFILE"  
ON THE "DRAINAGE SYSTEMS PROFILE" SHEET

STA. 107+40 TO STA. 108+50

PROJECT NAME:	MORRISTOWN
PROJECT NUMBER:	BRS 0240(3)S/STP HES 030-2(28)
FILE NAME:	s78f329xs.dgn
PROJECT LEADER:	C. CARLSON
DESIGNED BY:	C. BURRALL
VT 15A SECTIONS SHEET 4	
PLOT DATE:	12-APR-2017
DRAWN BY:	G. ROKES
CHECKED BY:	J. LACROIX
SHEET	105 OF 175