




113+50

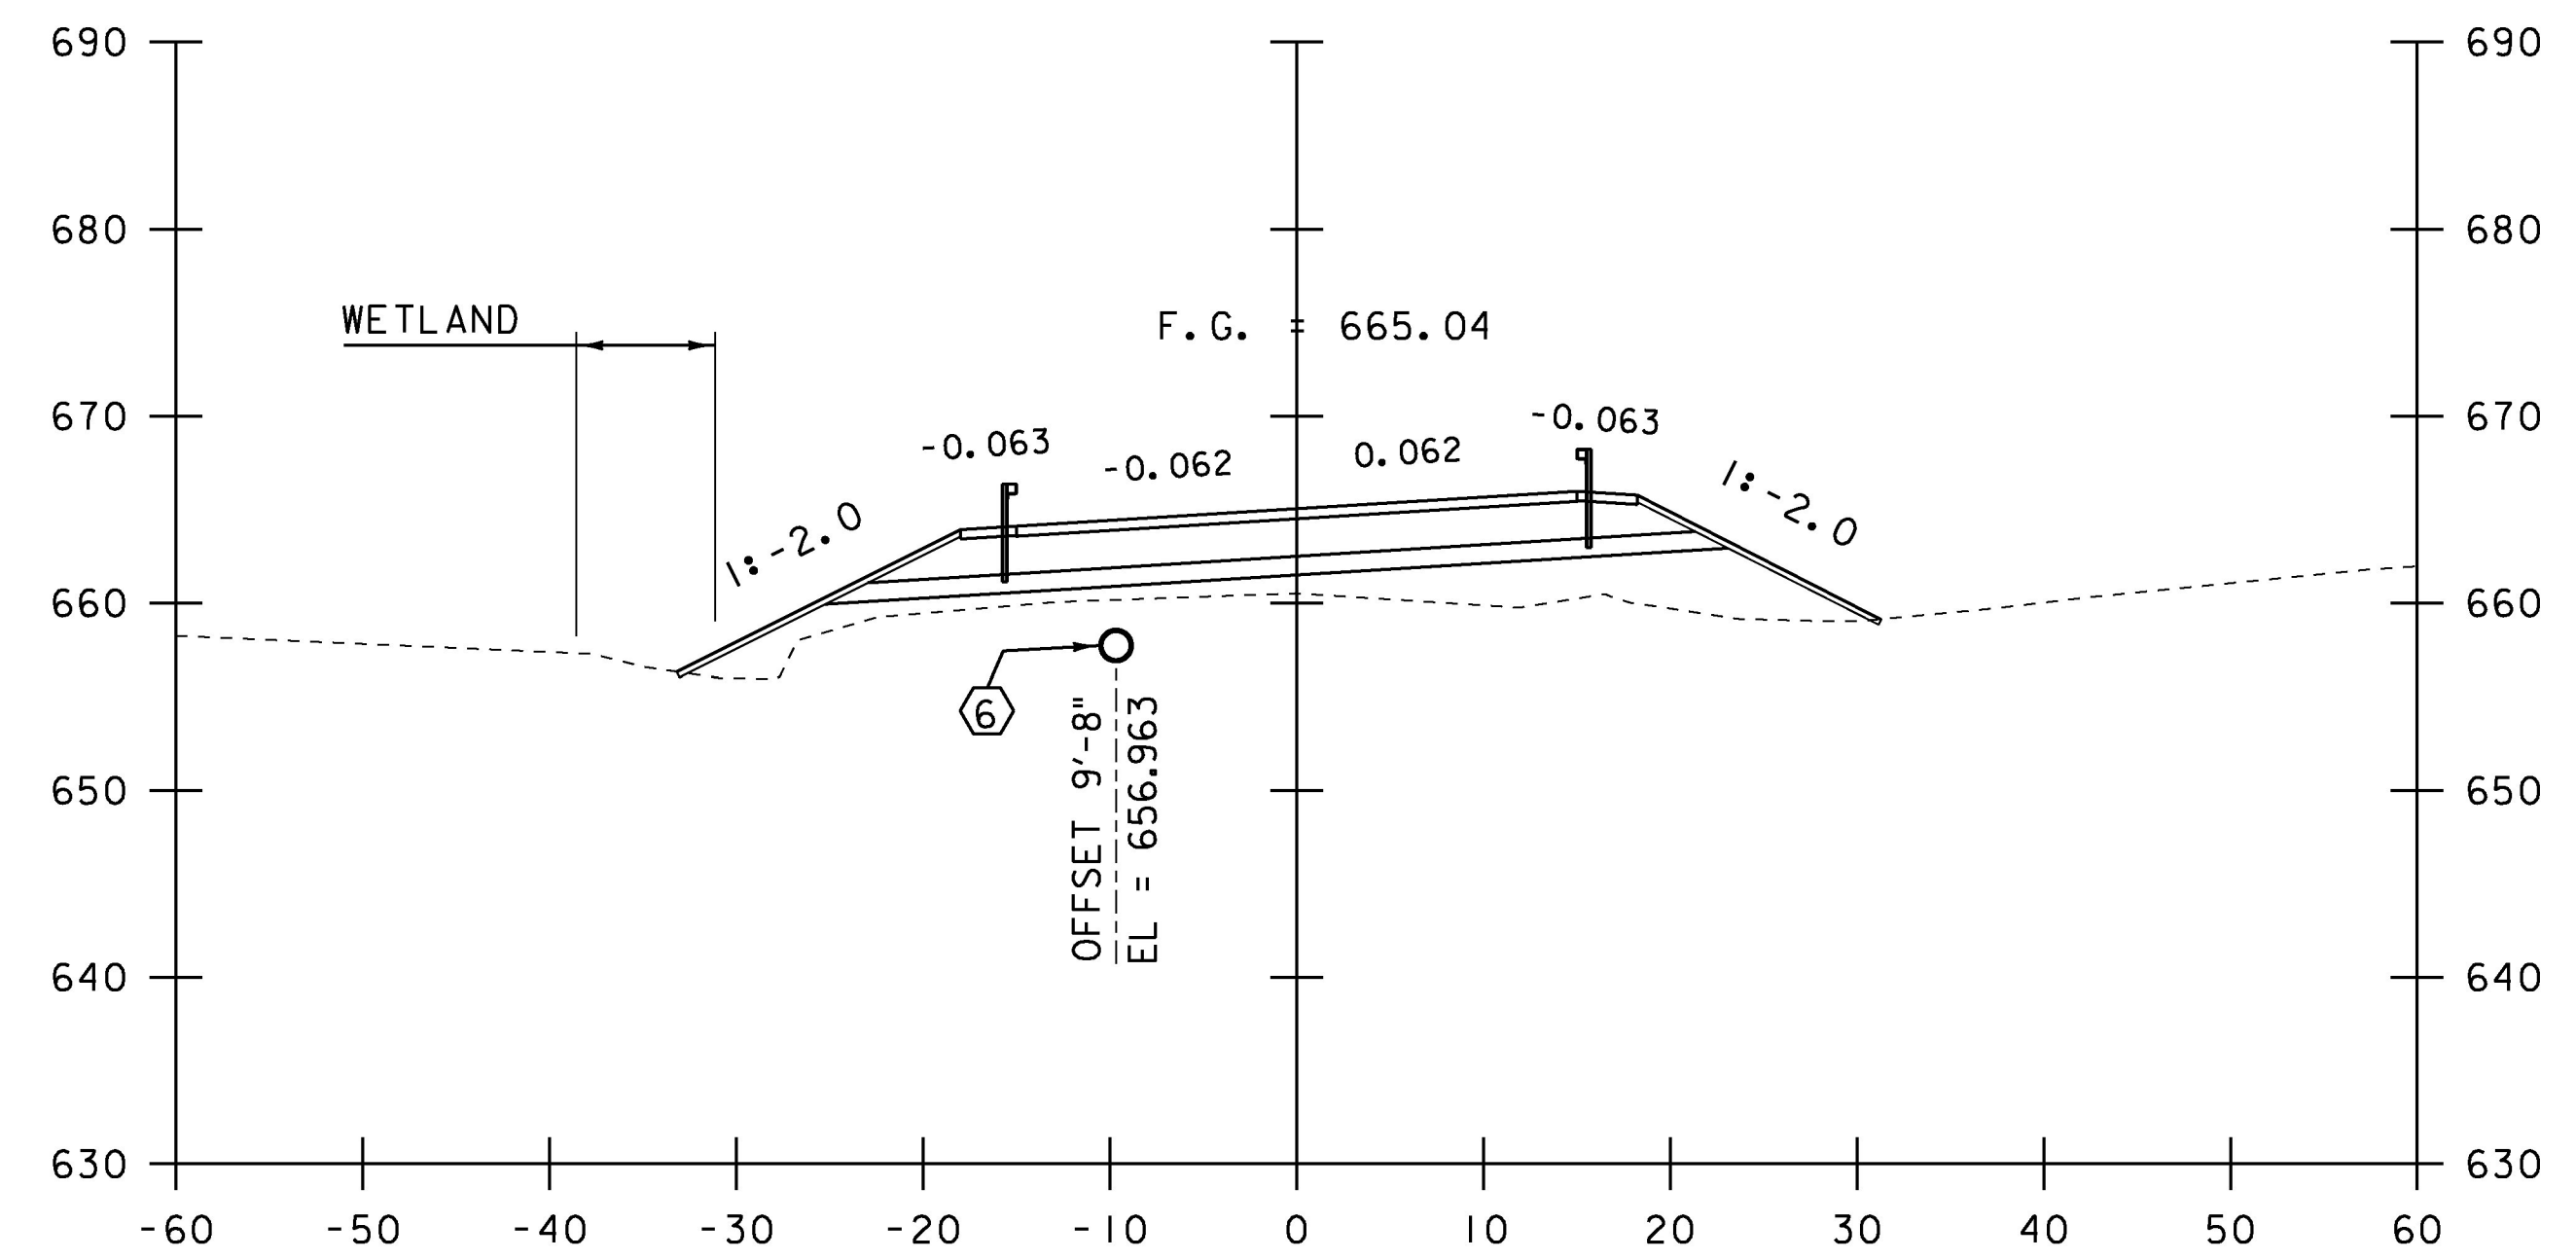

114+00

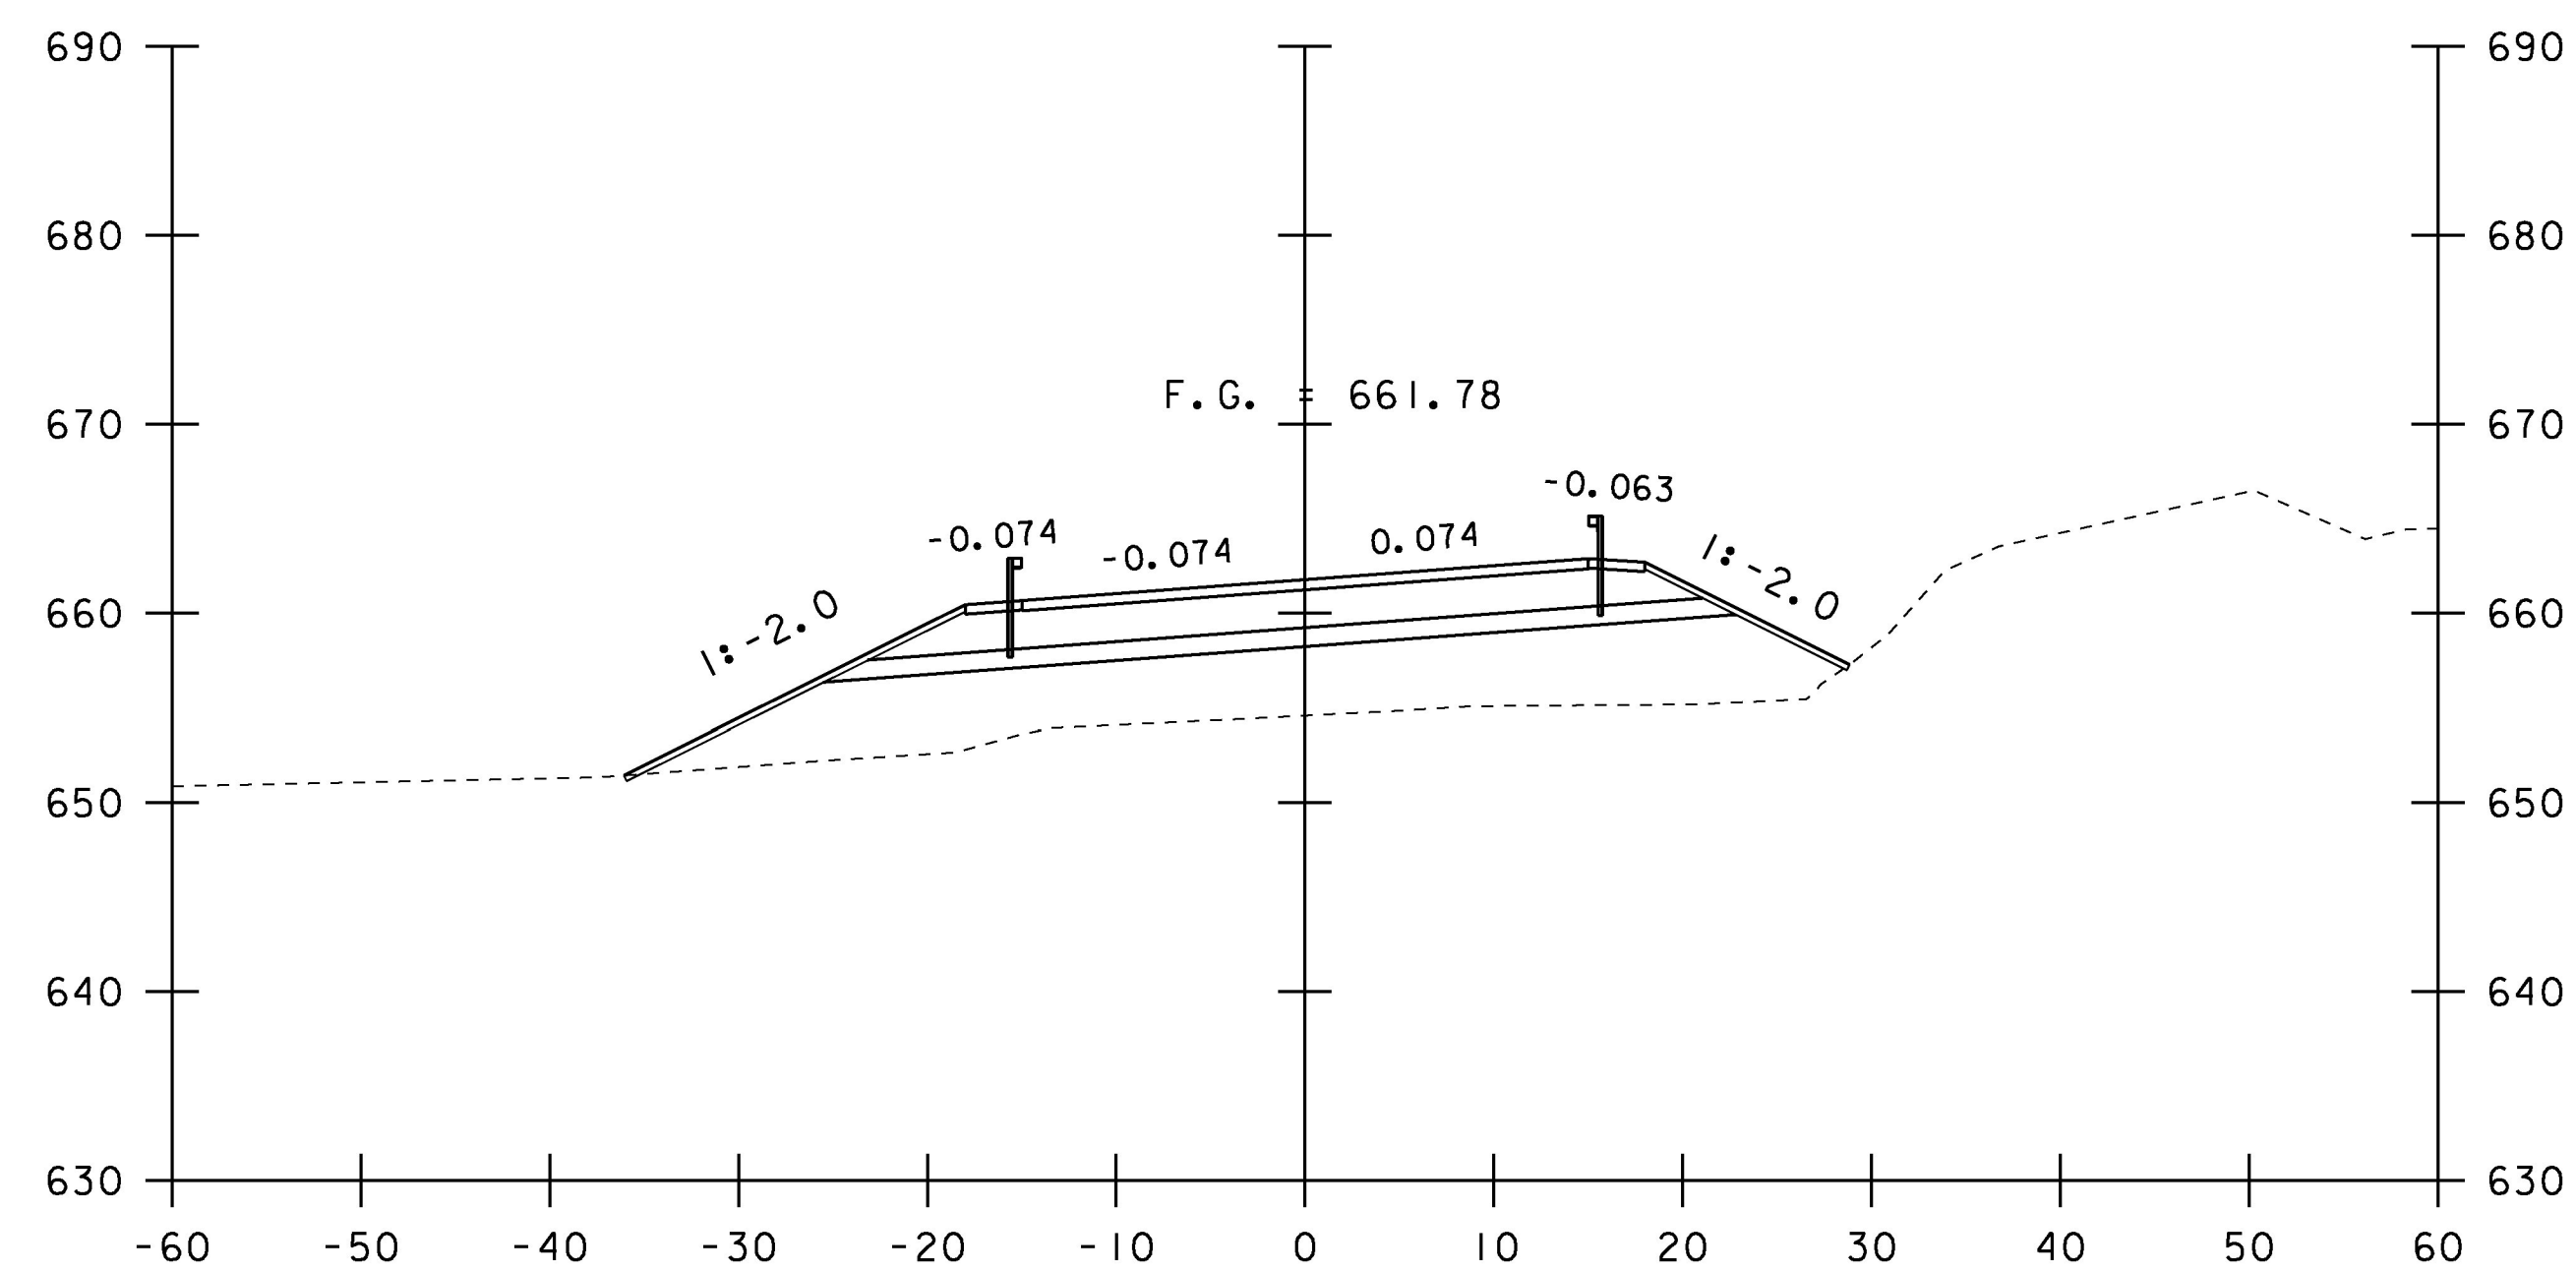

113+00

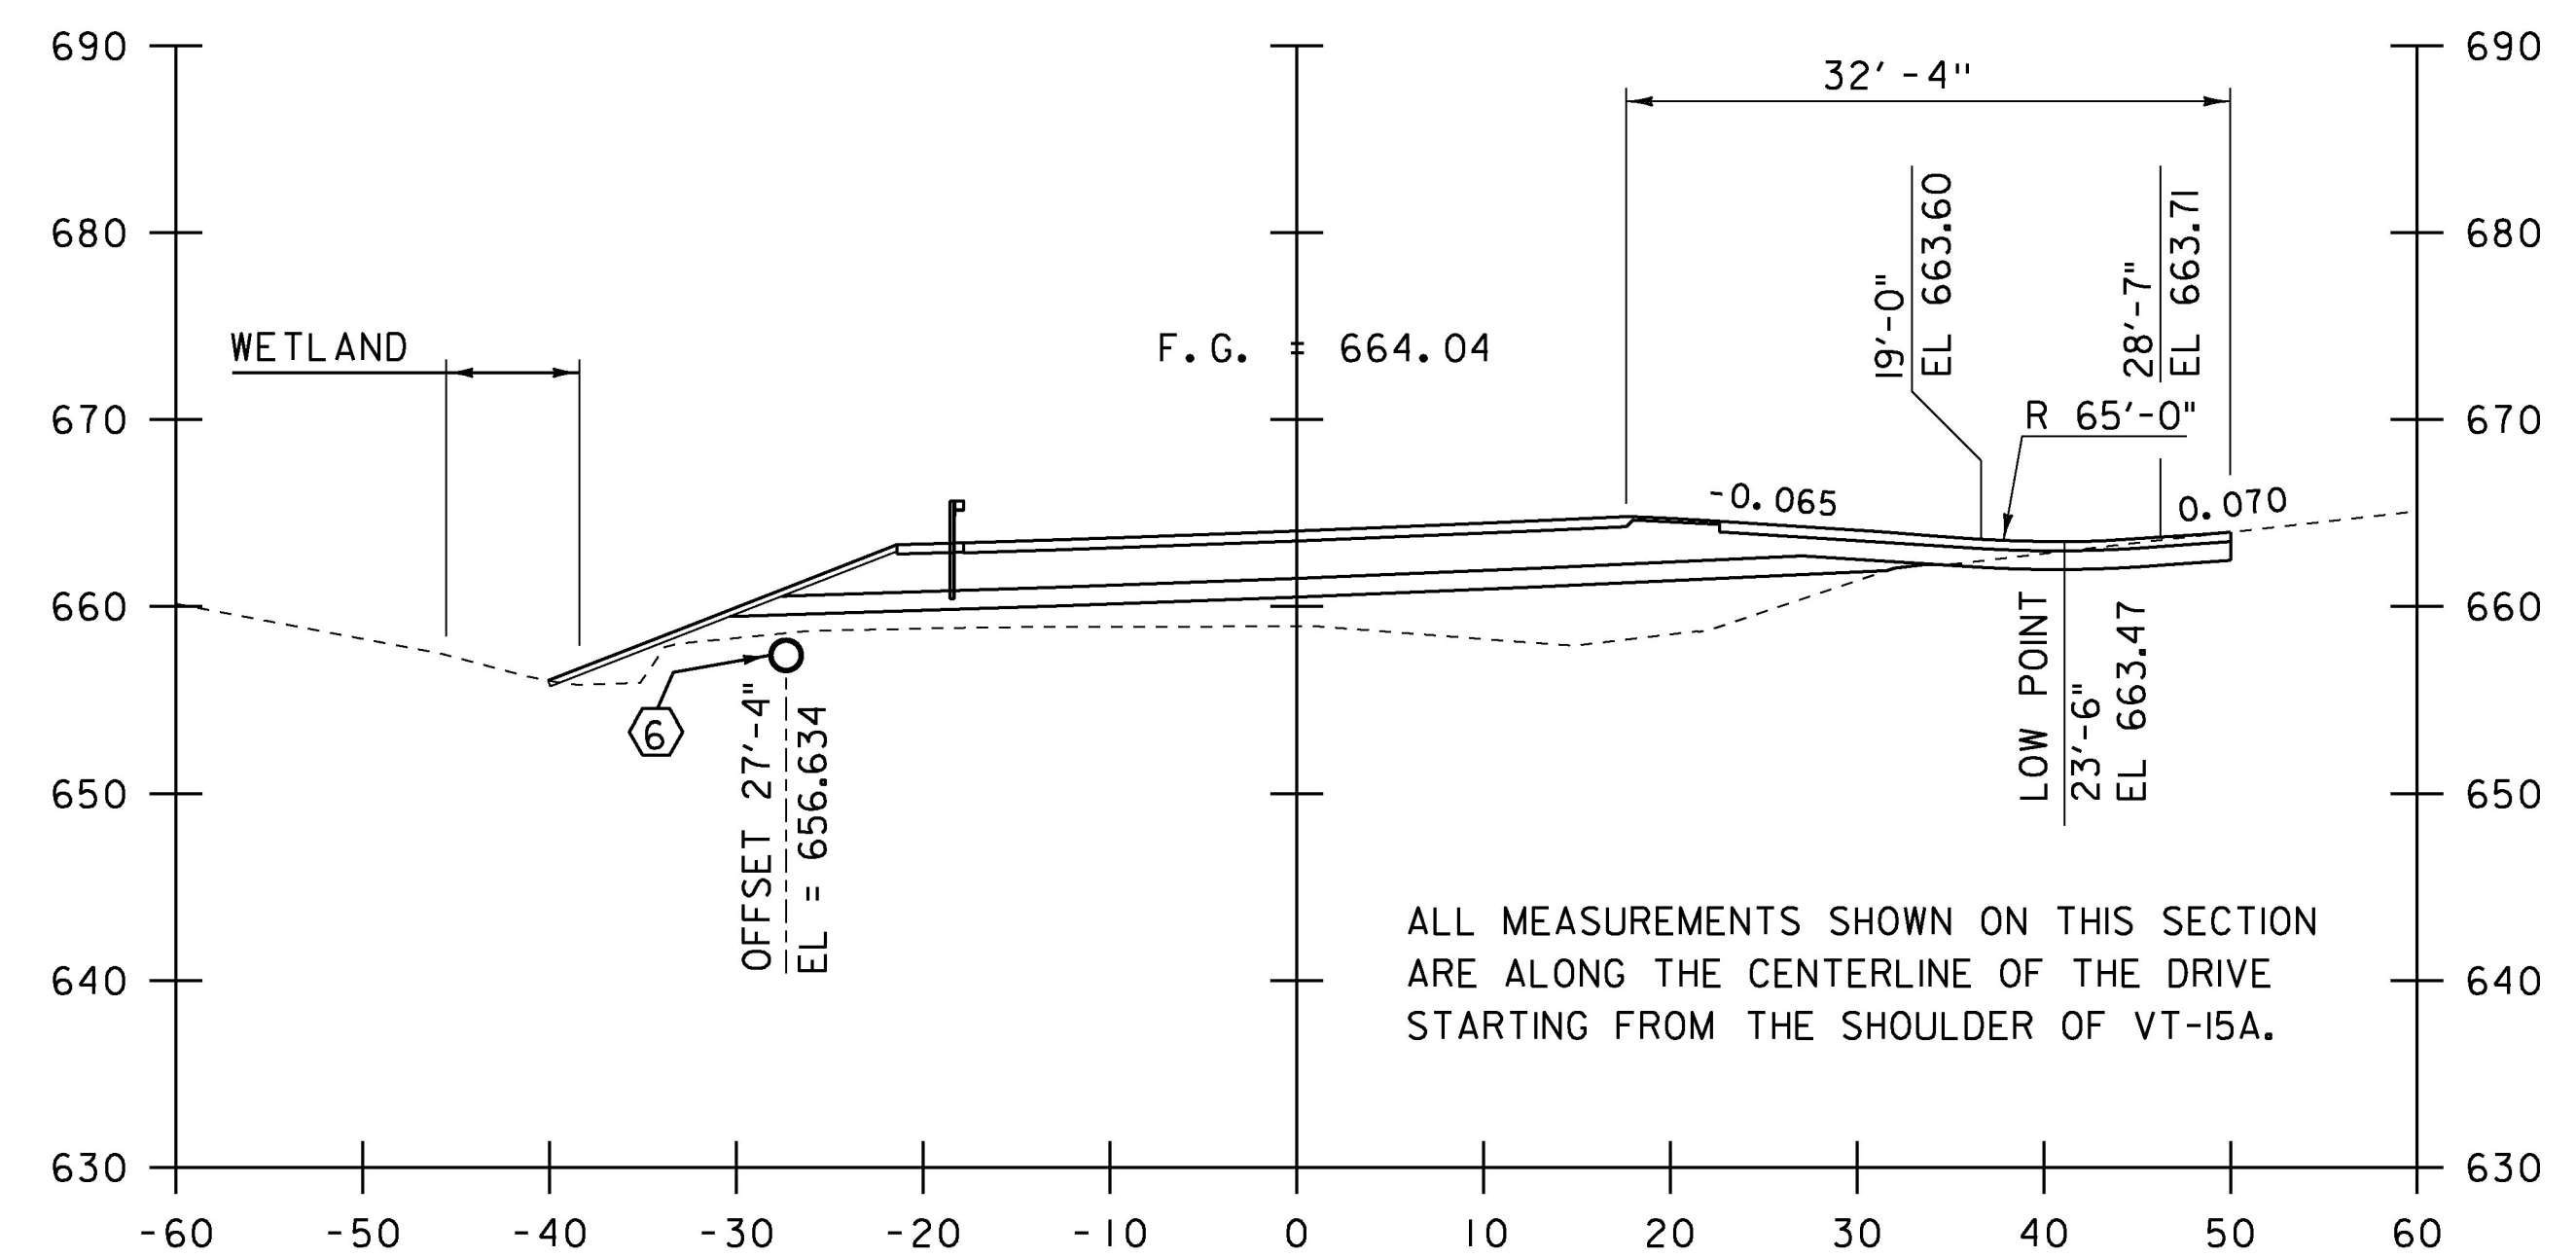

113+75

SKEWED FIELD DRIVE 3

⑥ NEW 18 INCH DIA. PIPE

STA. 113+00 TO STA. 114+00

PROJECT NAME:	MORRISTOWN
PROJECT NUMBER:	BRS 0240(3)S/STP HES 030-2(28)
FILE NAME:	s78f329xs.dgn
PROJECT LEADER:	C. CARLSON
DESIGNED BY:	C. BURRALL
VT 15A SECTIONS SHEET 8	
PLOT DATE:	12-APR-2017
DRAWN BY:	G. ROKES
CHECKED BY:	J. LACROIX
SHEET	109 OF 175