




114+50

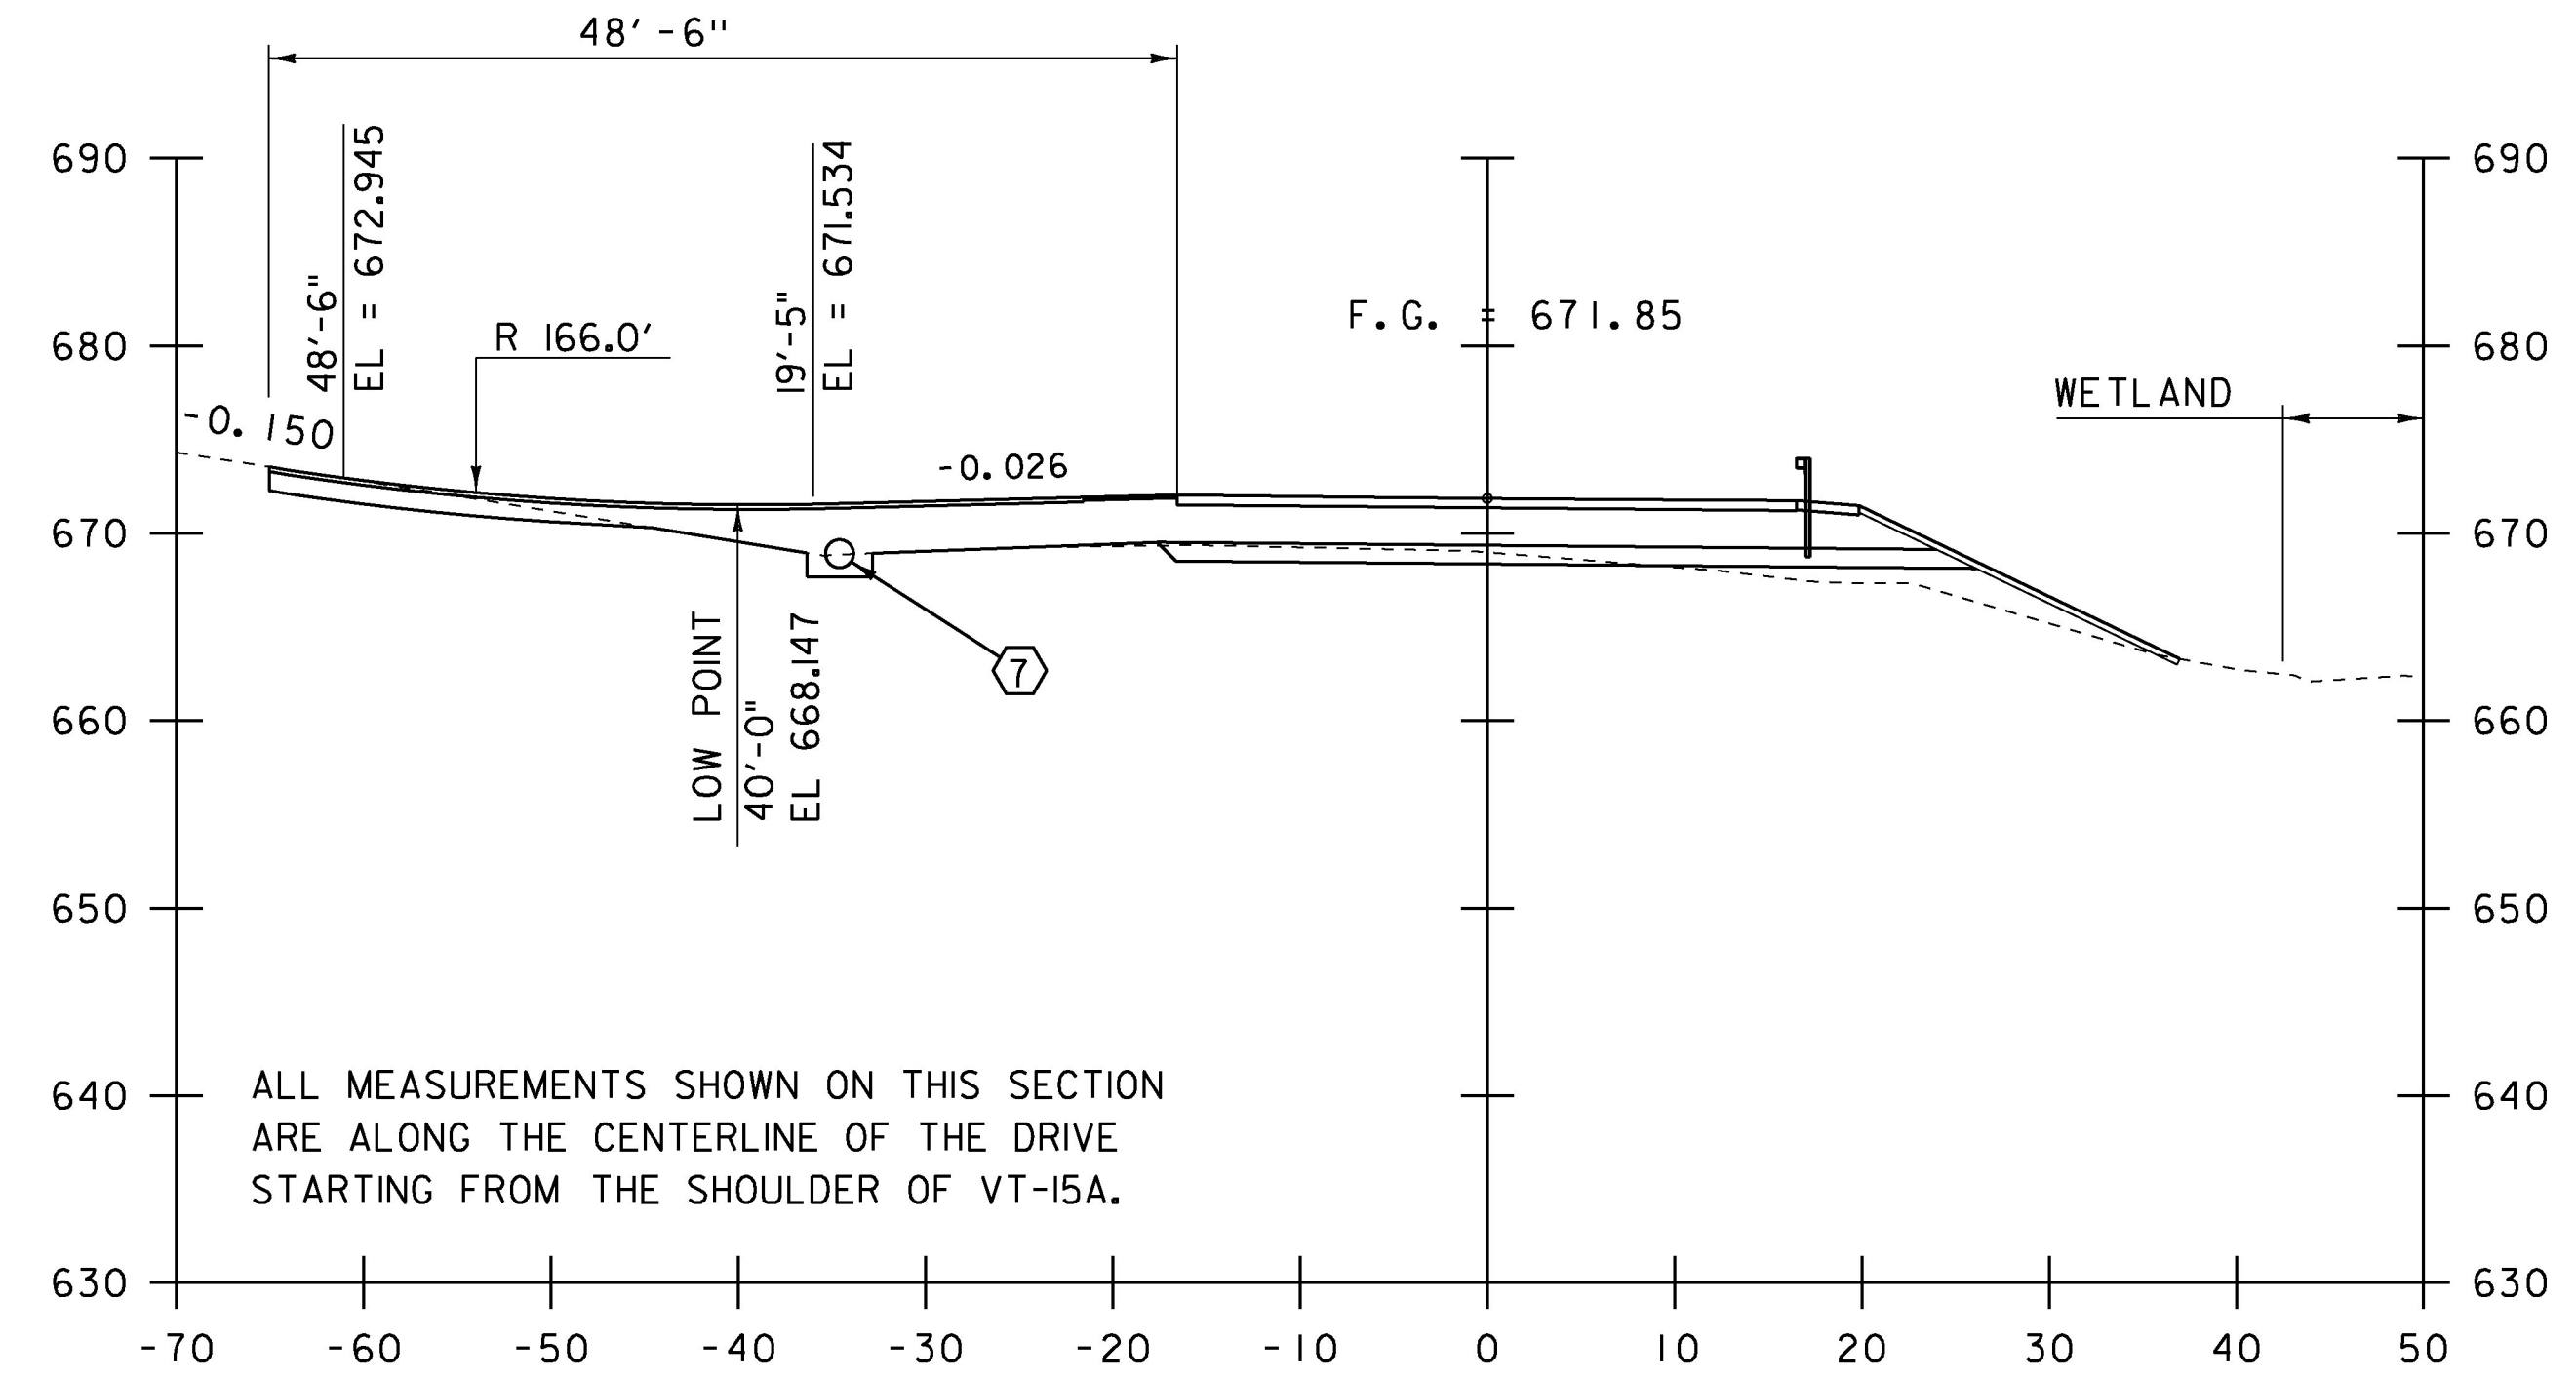

115+25
SKEWED FIELD DRIVE 4

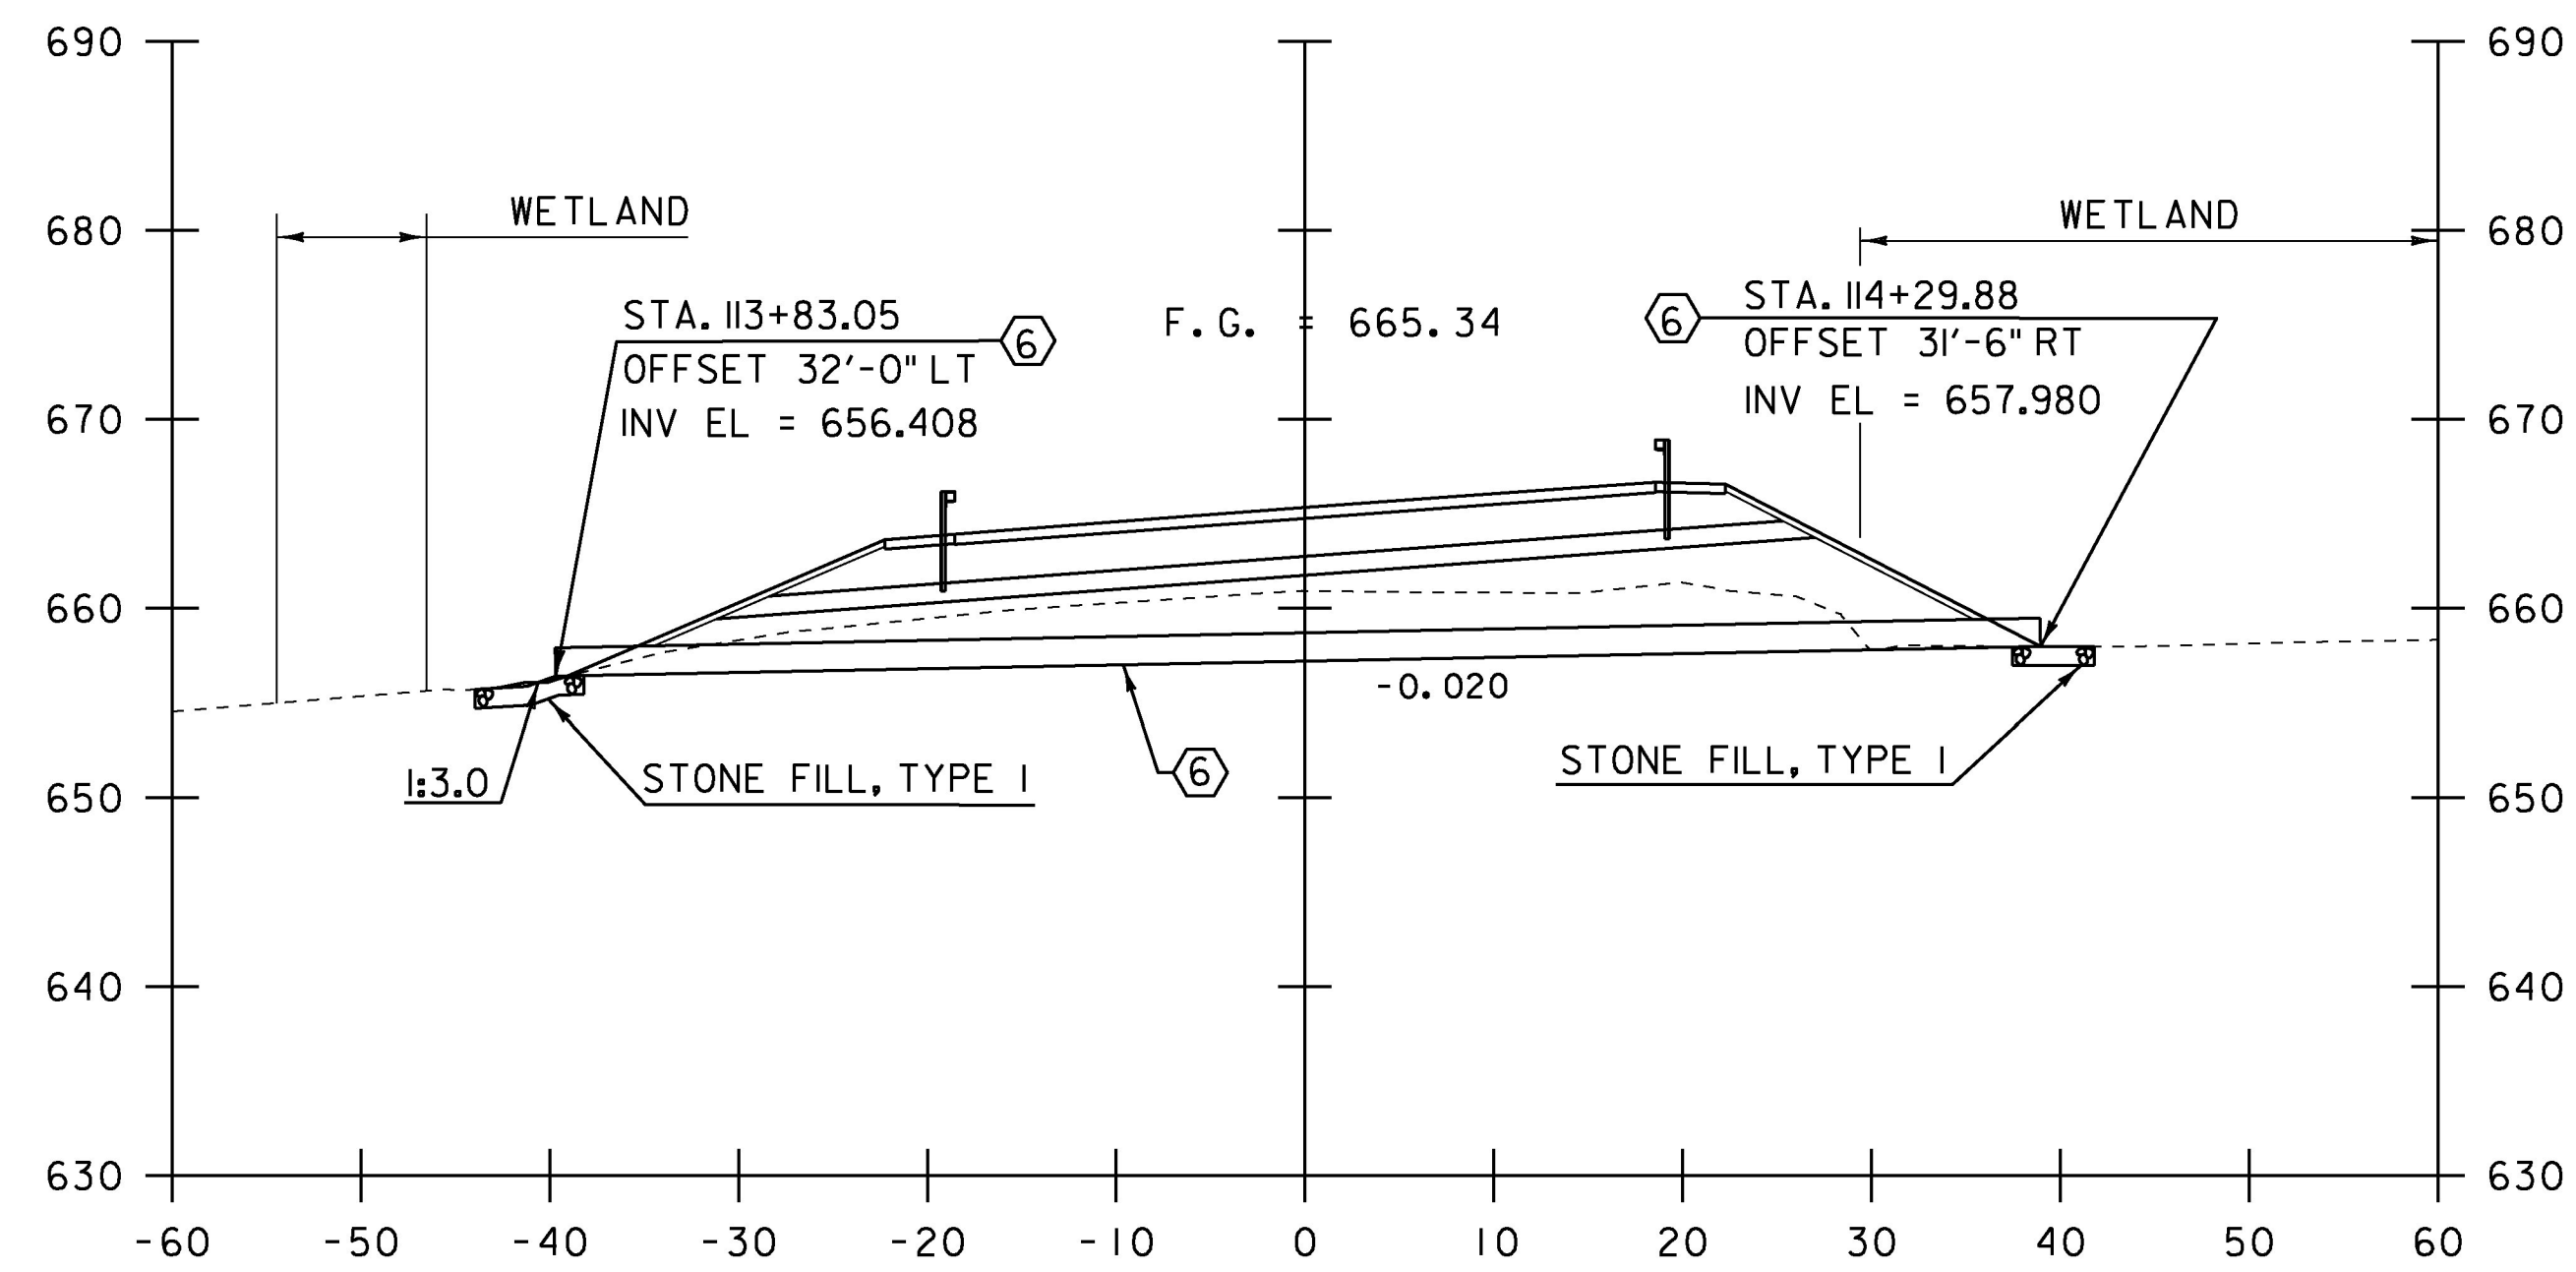

114+07
SKEWED PIPE SECTION

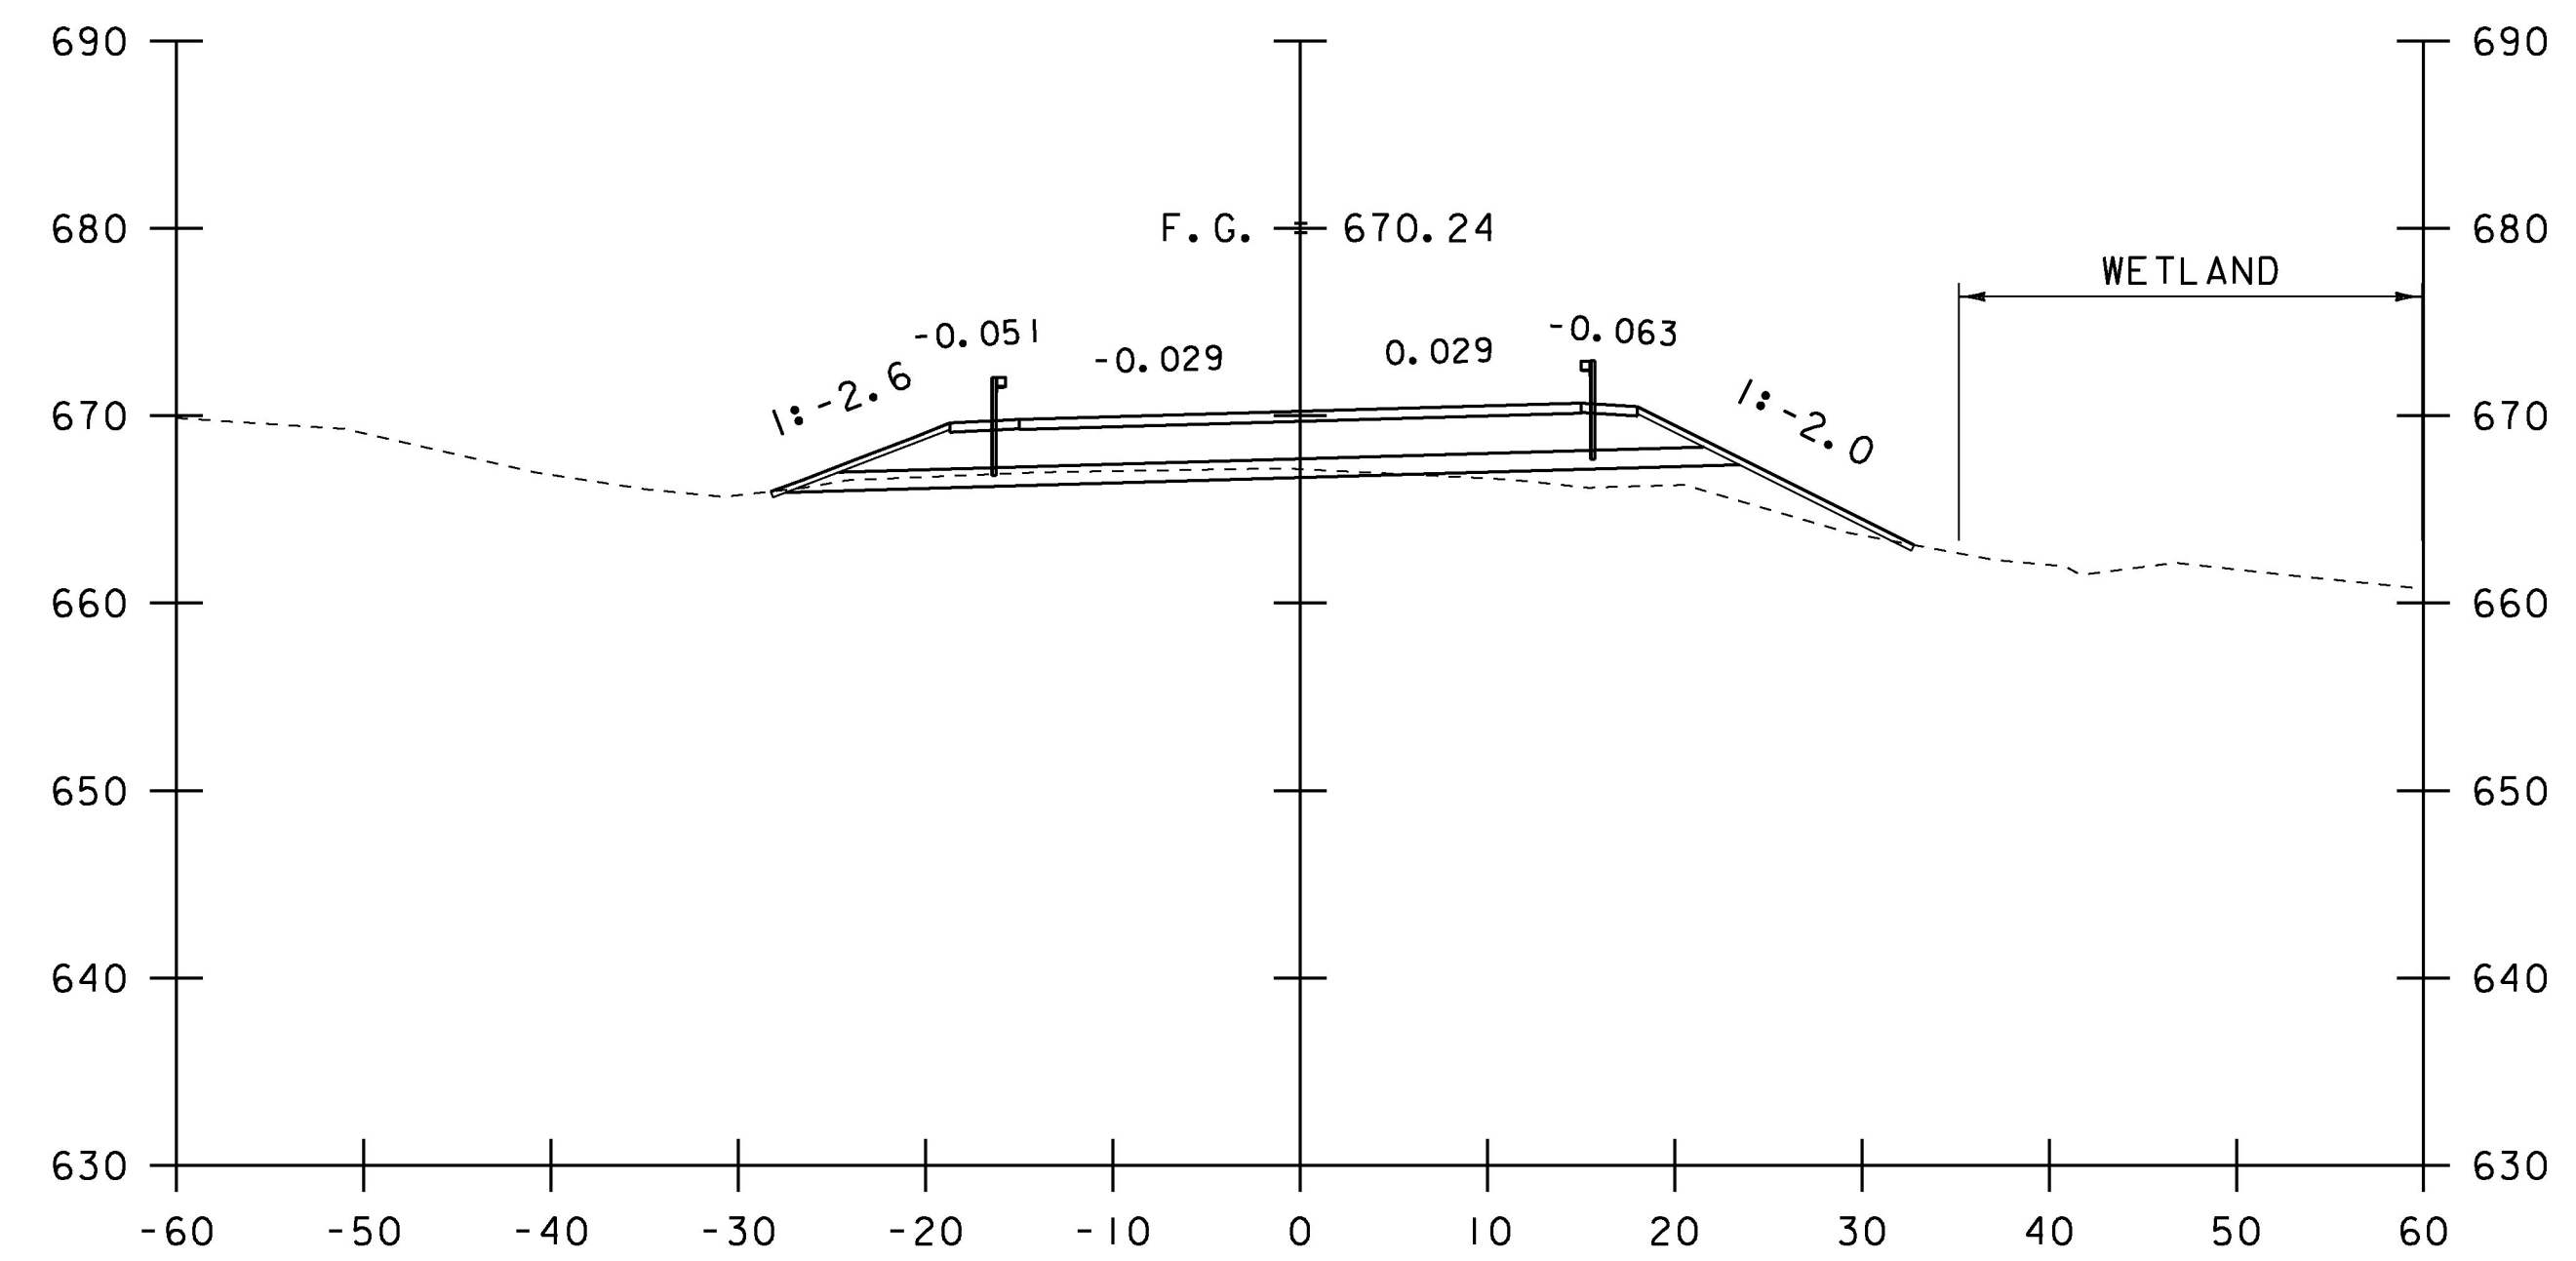

115+00

⑥ NEW 18 INCH DIA. PIPE LENGTH 78'-7"

STA. 114+07 TO STA. 115+25

PROJECT NAME:	MORRISTOWN
PROJECT NUMBER:	BRS 0240(3)S/STP HES 030-2(28)
FILE NAME:	s78f329xs.dgn
PROJECT LEADER:	C. CARLSON
DESIGNED BY:	C. BURRALL
VT 15A SECTIONS SHEET 9	
PLOT DATE:	12-APR-2017
DRAWN BY:	G. ROKES
CHECKED BY:	J. LACROIX
SHEET	110 OF 175