




END PROJECT BRS 0240 (3) S
 BEGIN PROJECT STP HES 030-2 (28)
 116+00

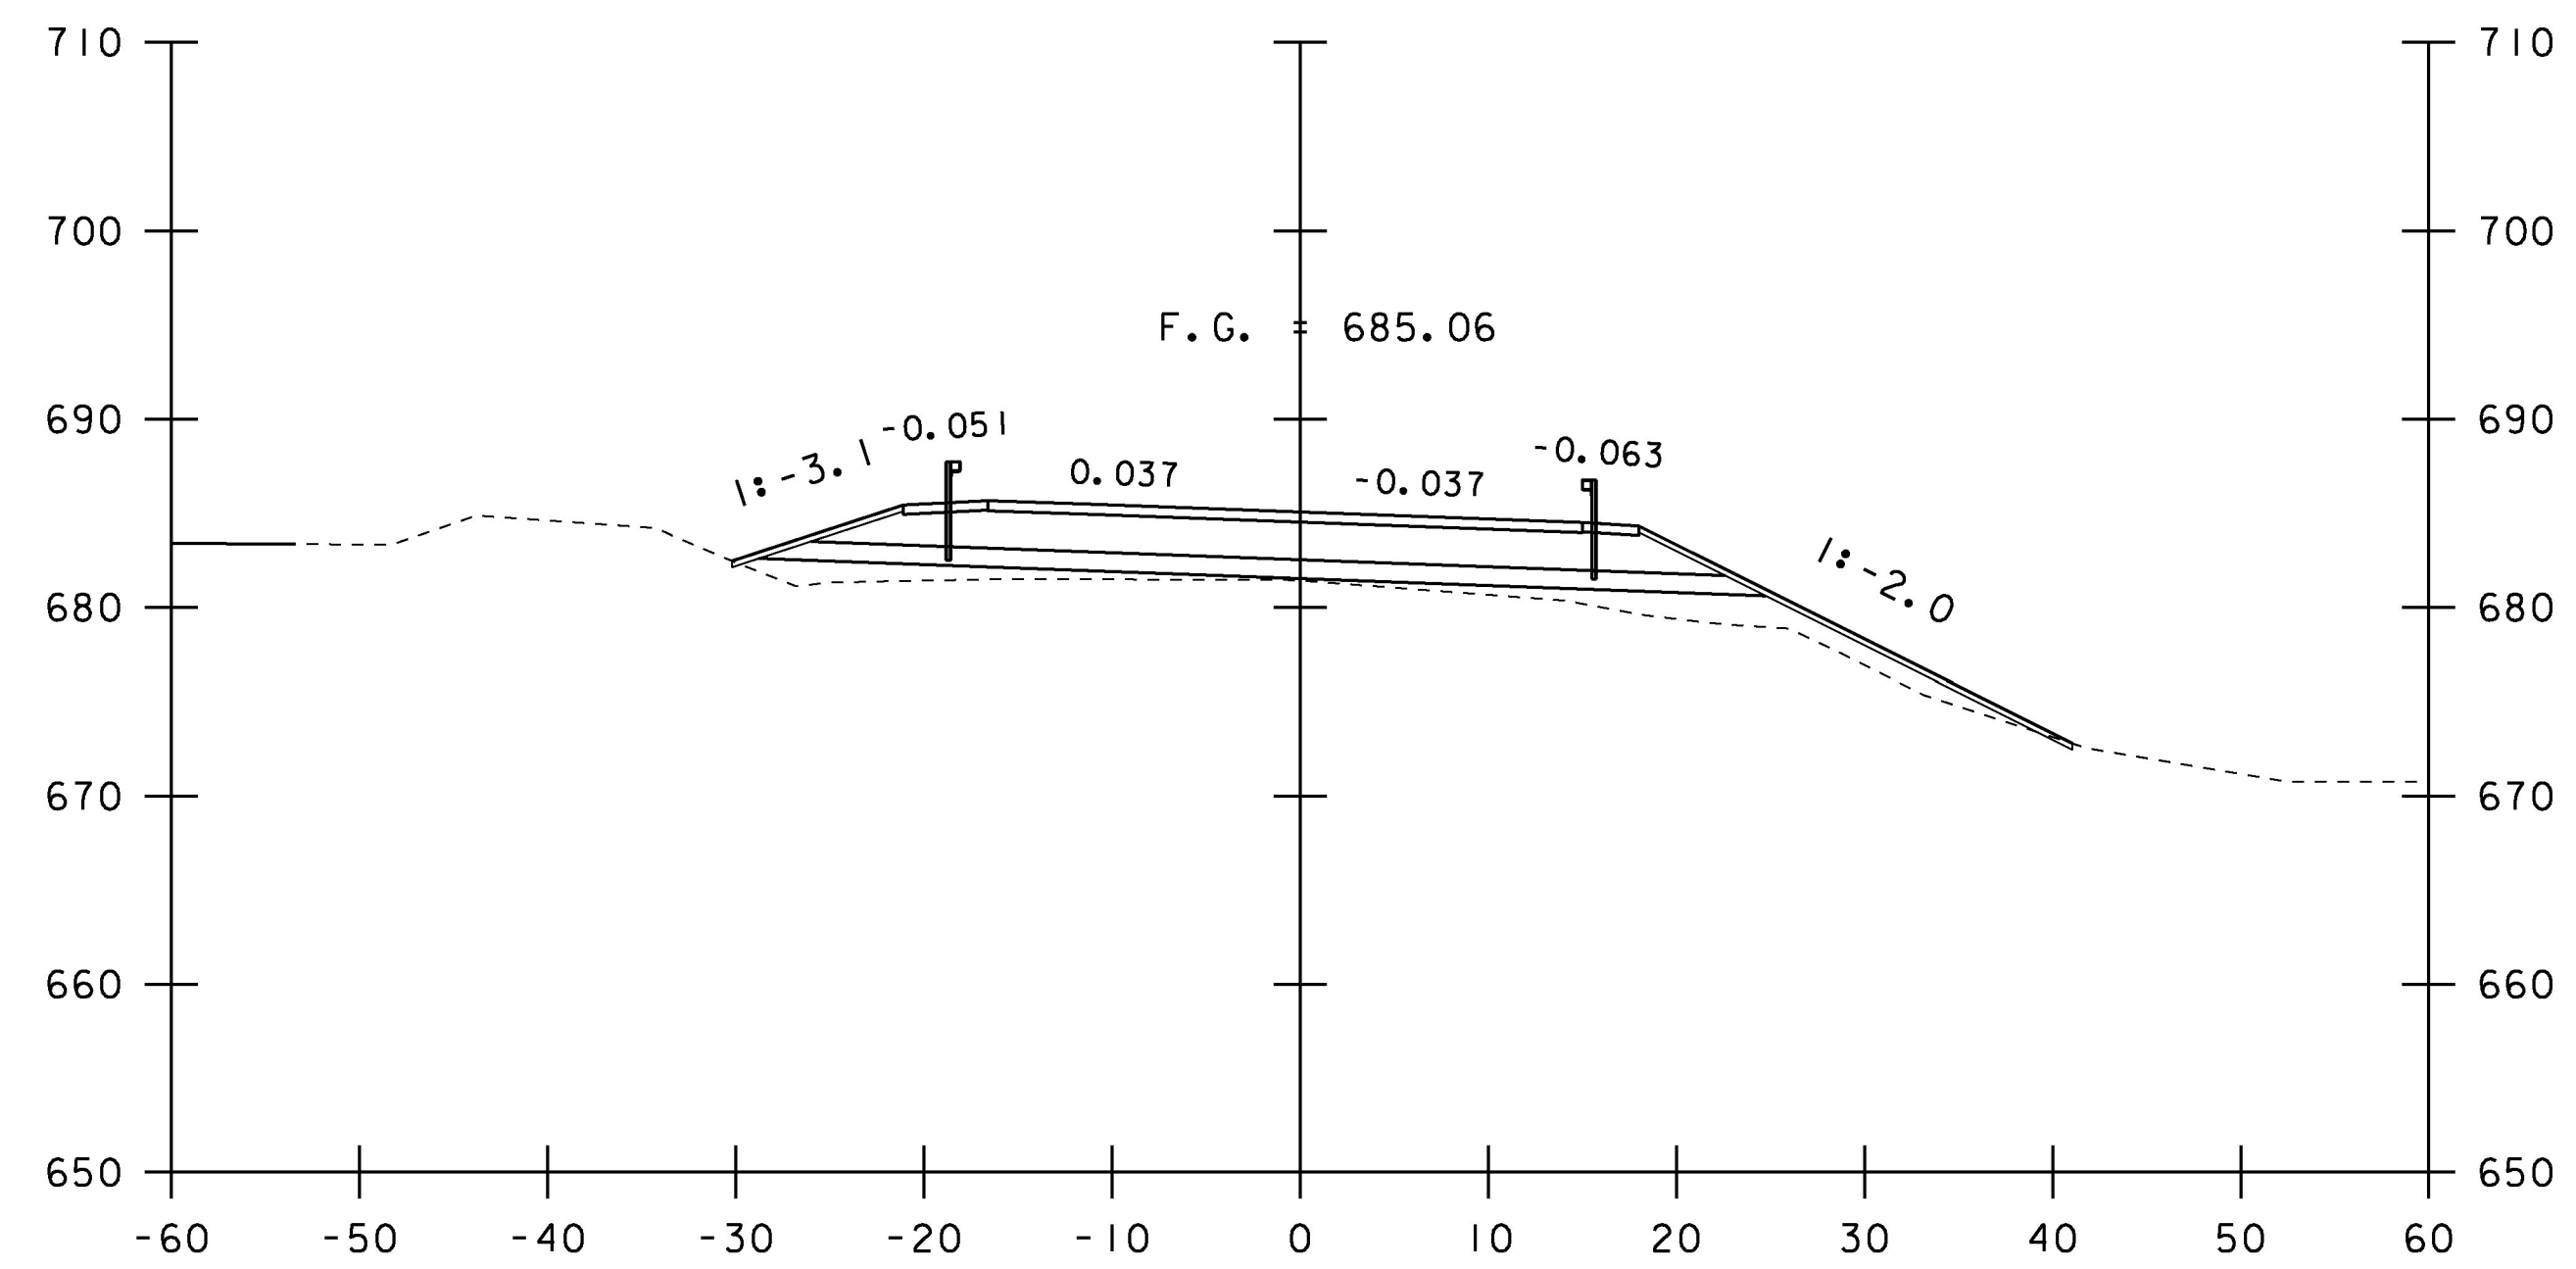

117+00

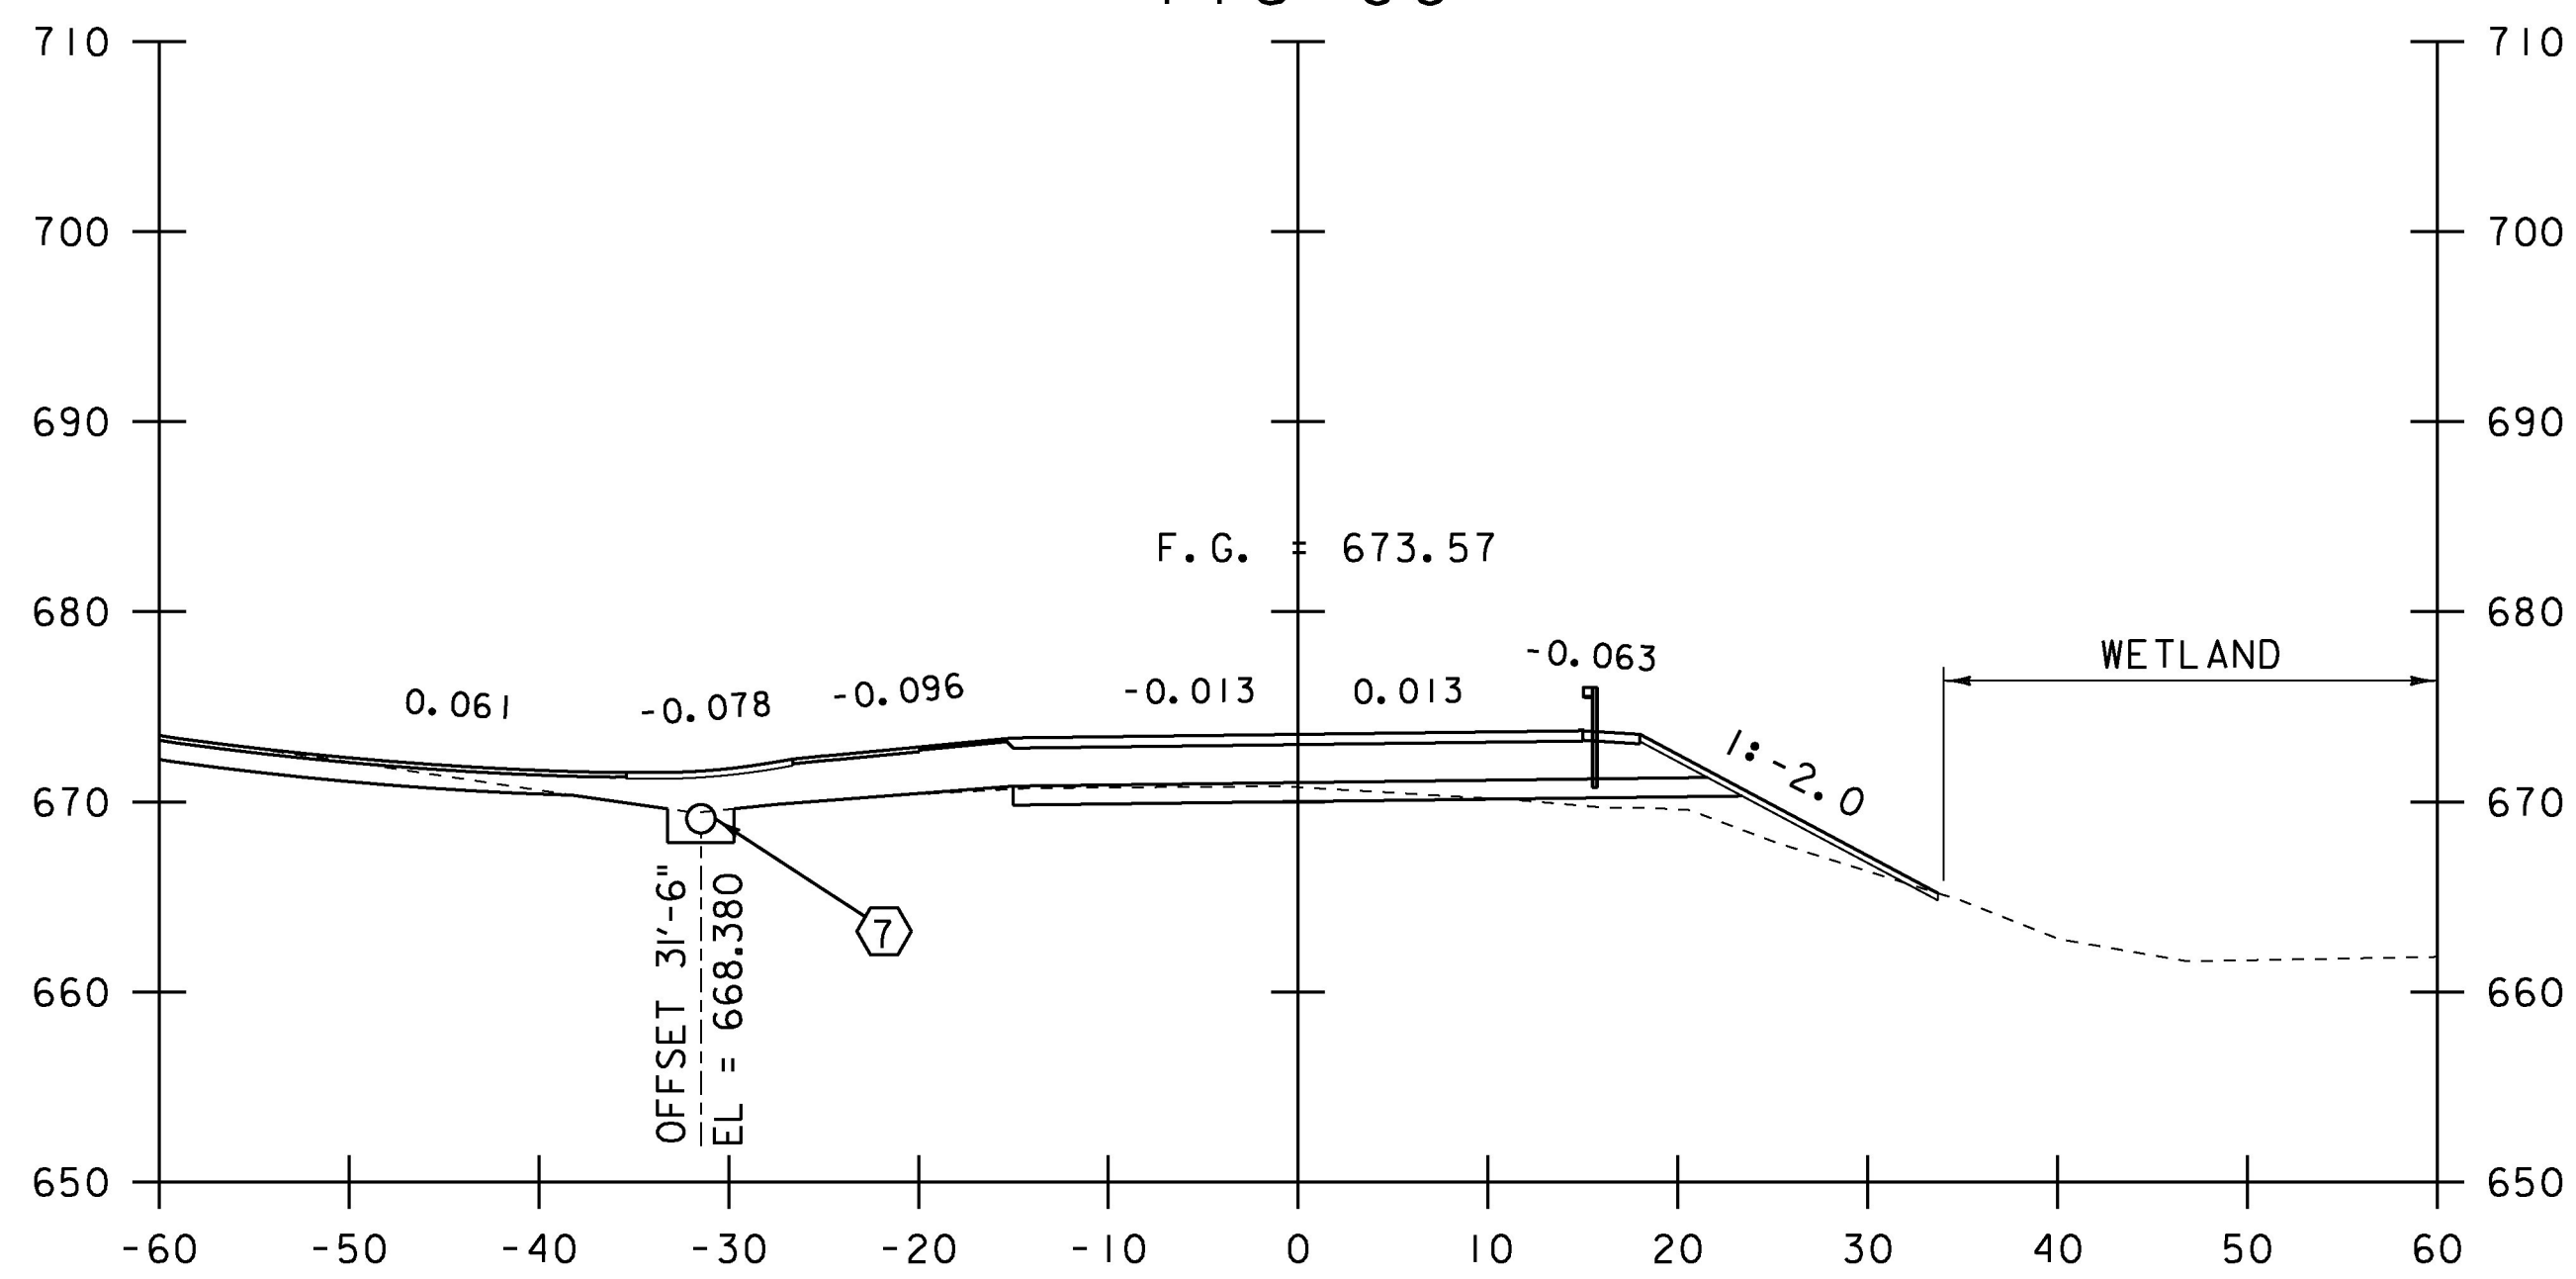

115+50

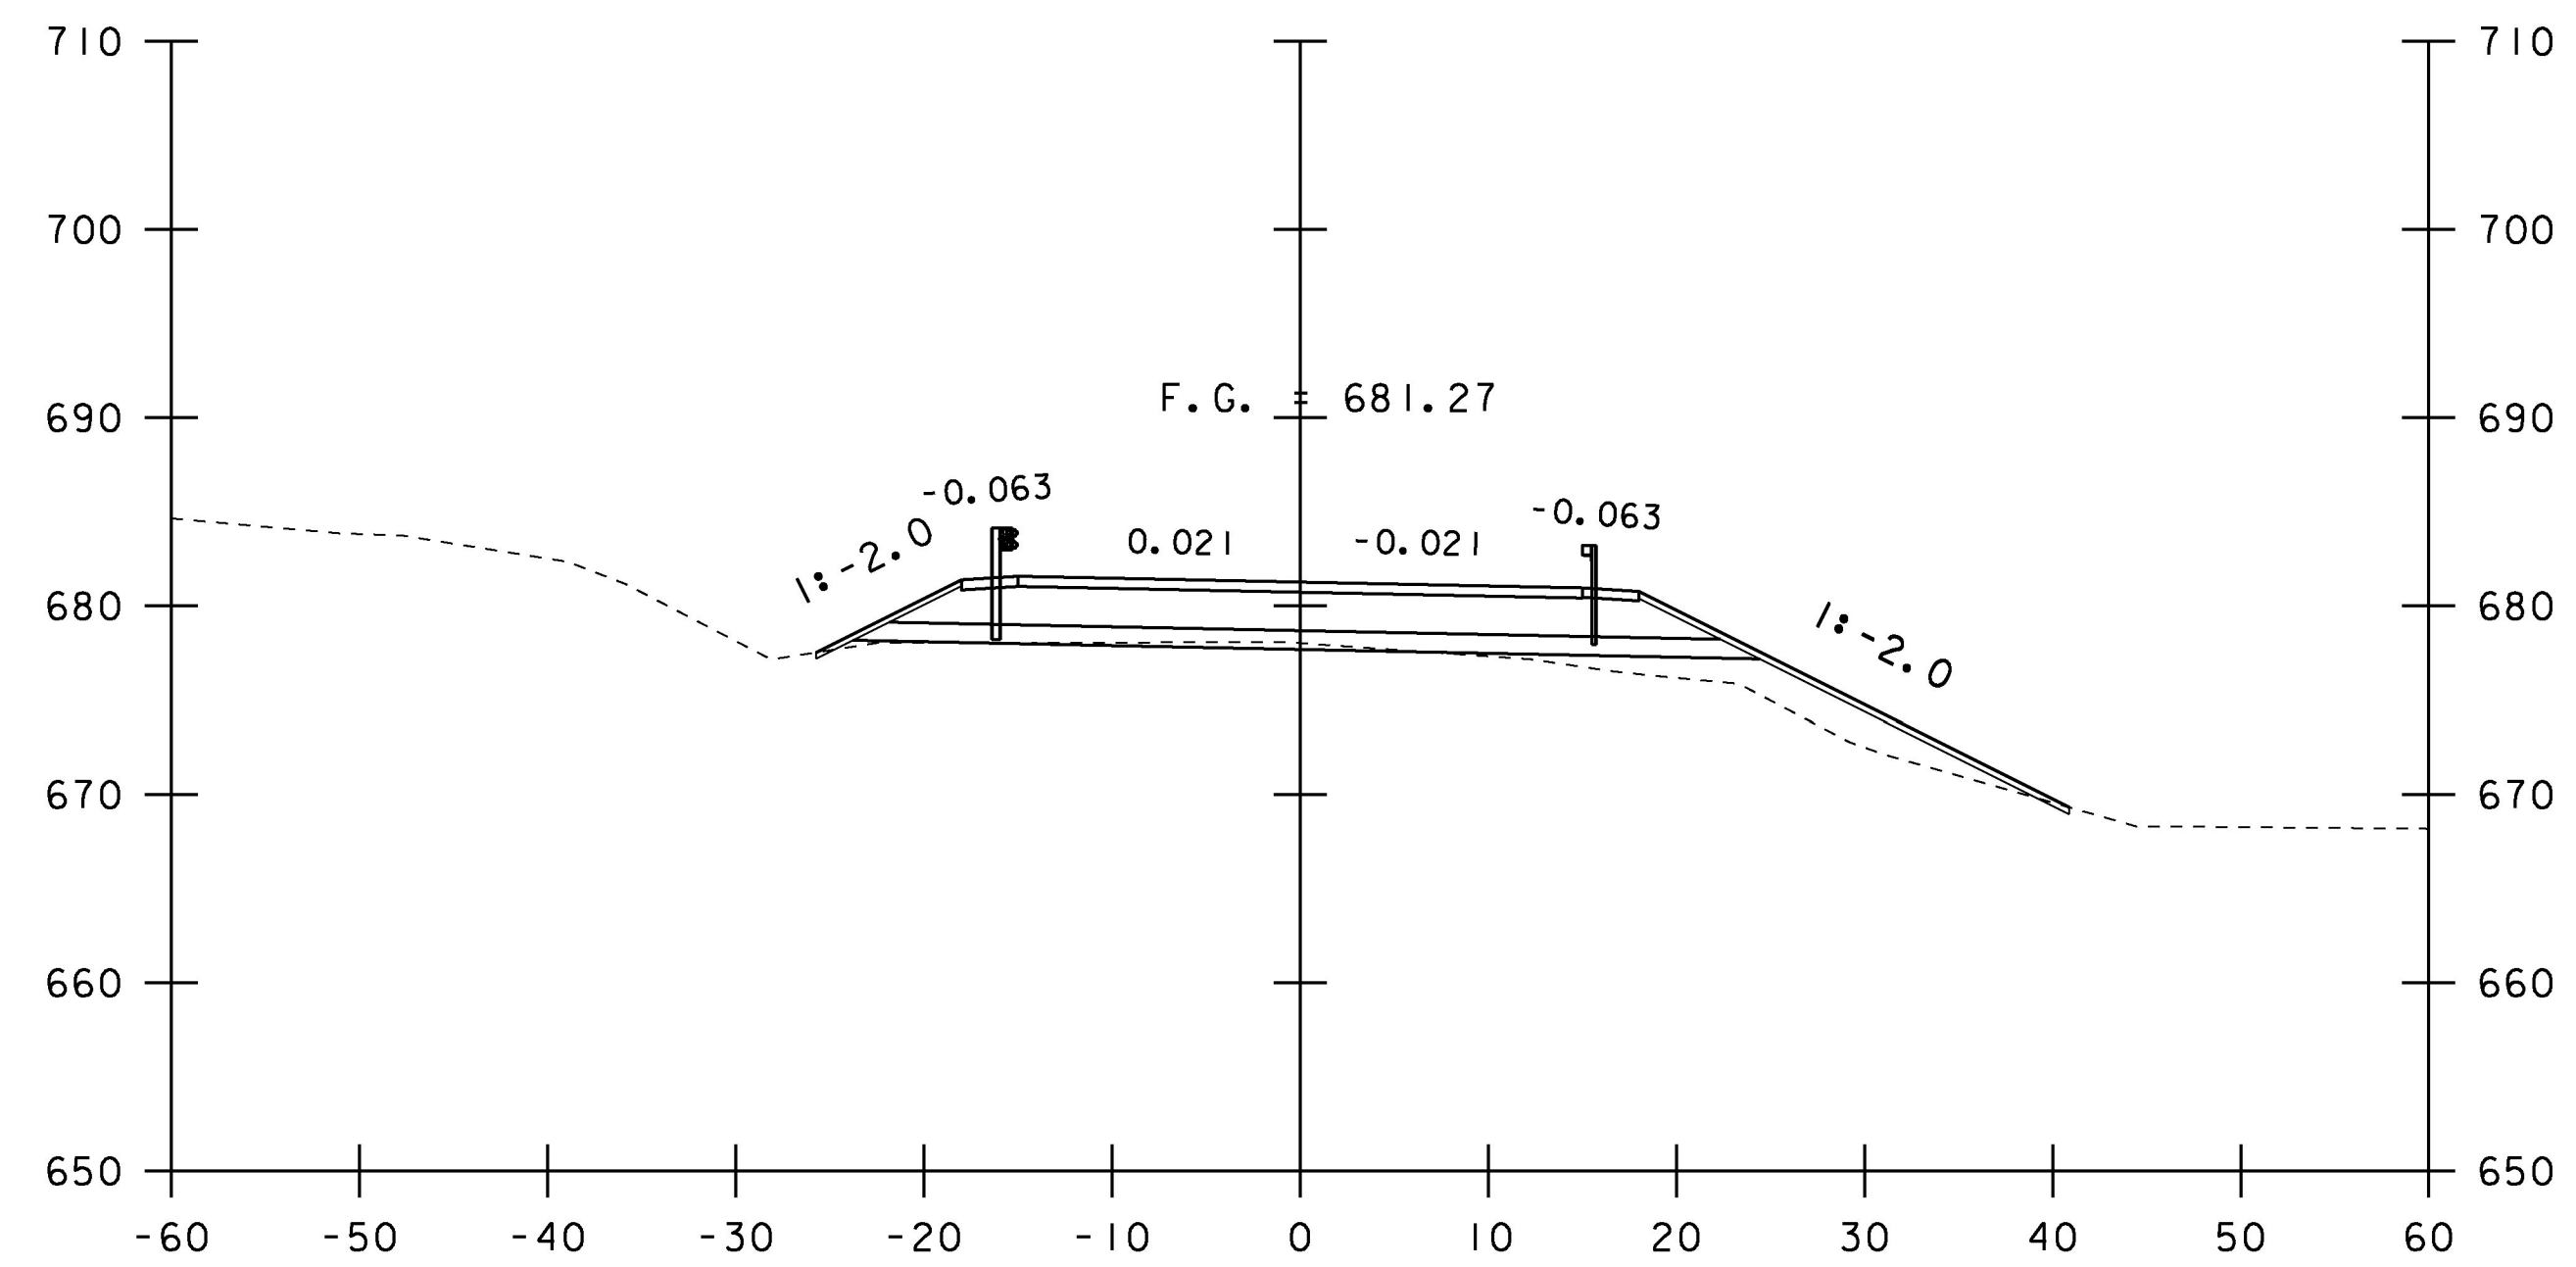

116+50

STA. 115+50 TO STA. 117+00

PROJECT NAME:	MORRISTOWN
PROJECT NUMBER:	BRS 0240(3)S/STP HES 030-2(28)
FILE NAME:	s78f329xs.dgn
PROJECT LEADER:	C. CARLSON
DESIGNED BY:	C. BURRALL
VT 15A SECTIONS SHEET 10	
PLOT DATE:	12-APR-2017
DRAWN BY:	G. ROKES
CHECKED BY:	J. LACROIX
SHEET	III OF 175