




208+21
DRIVE LEFT

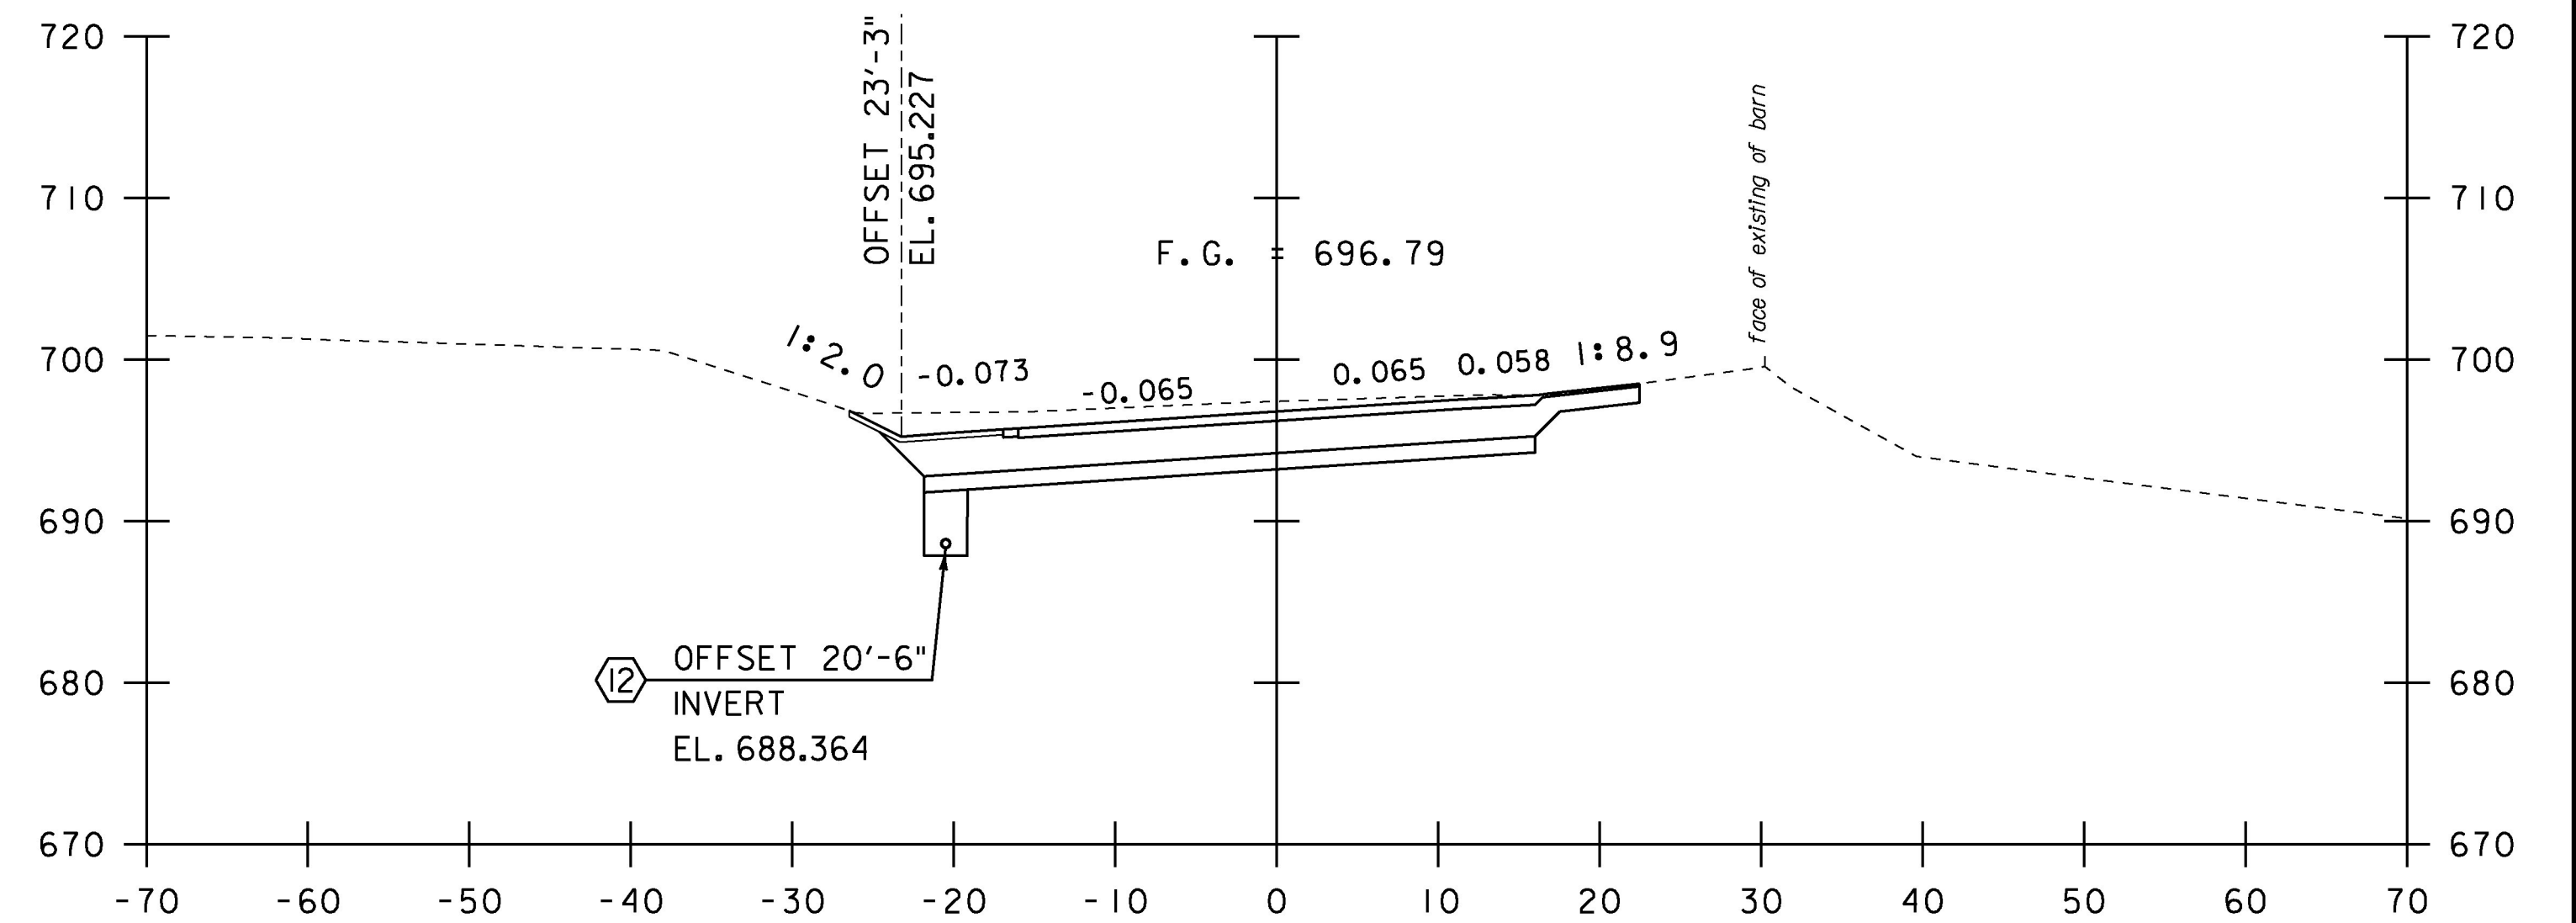

208+50

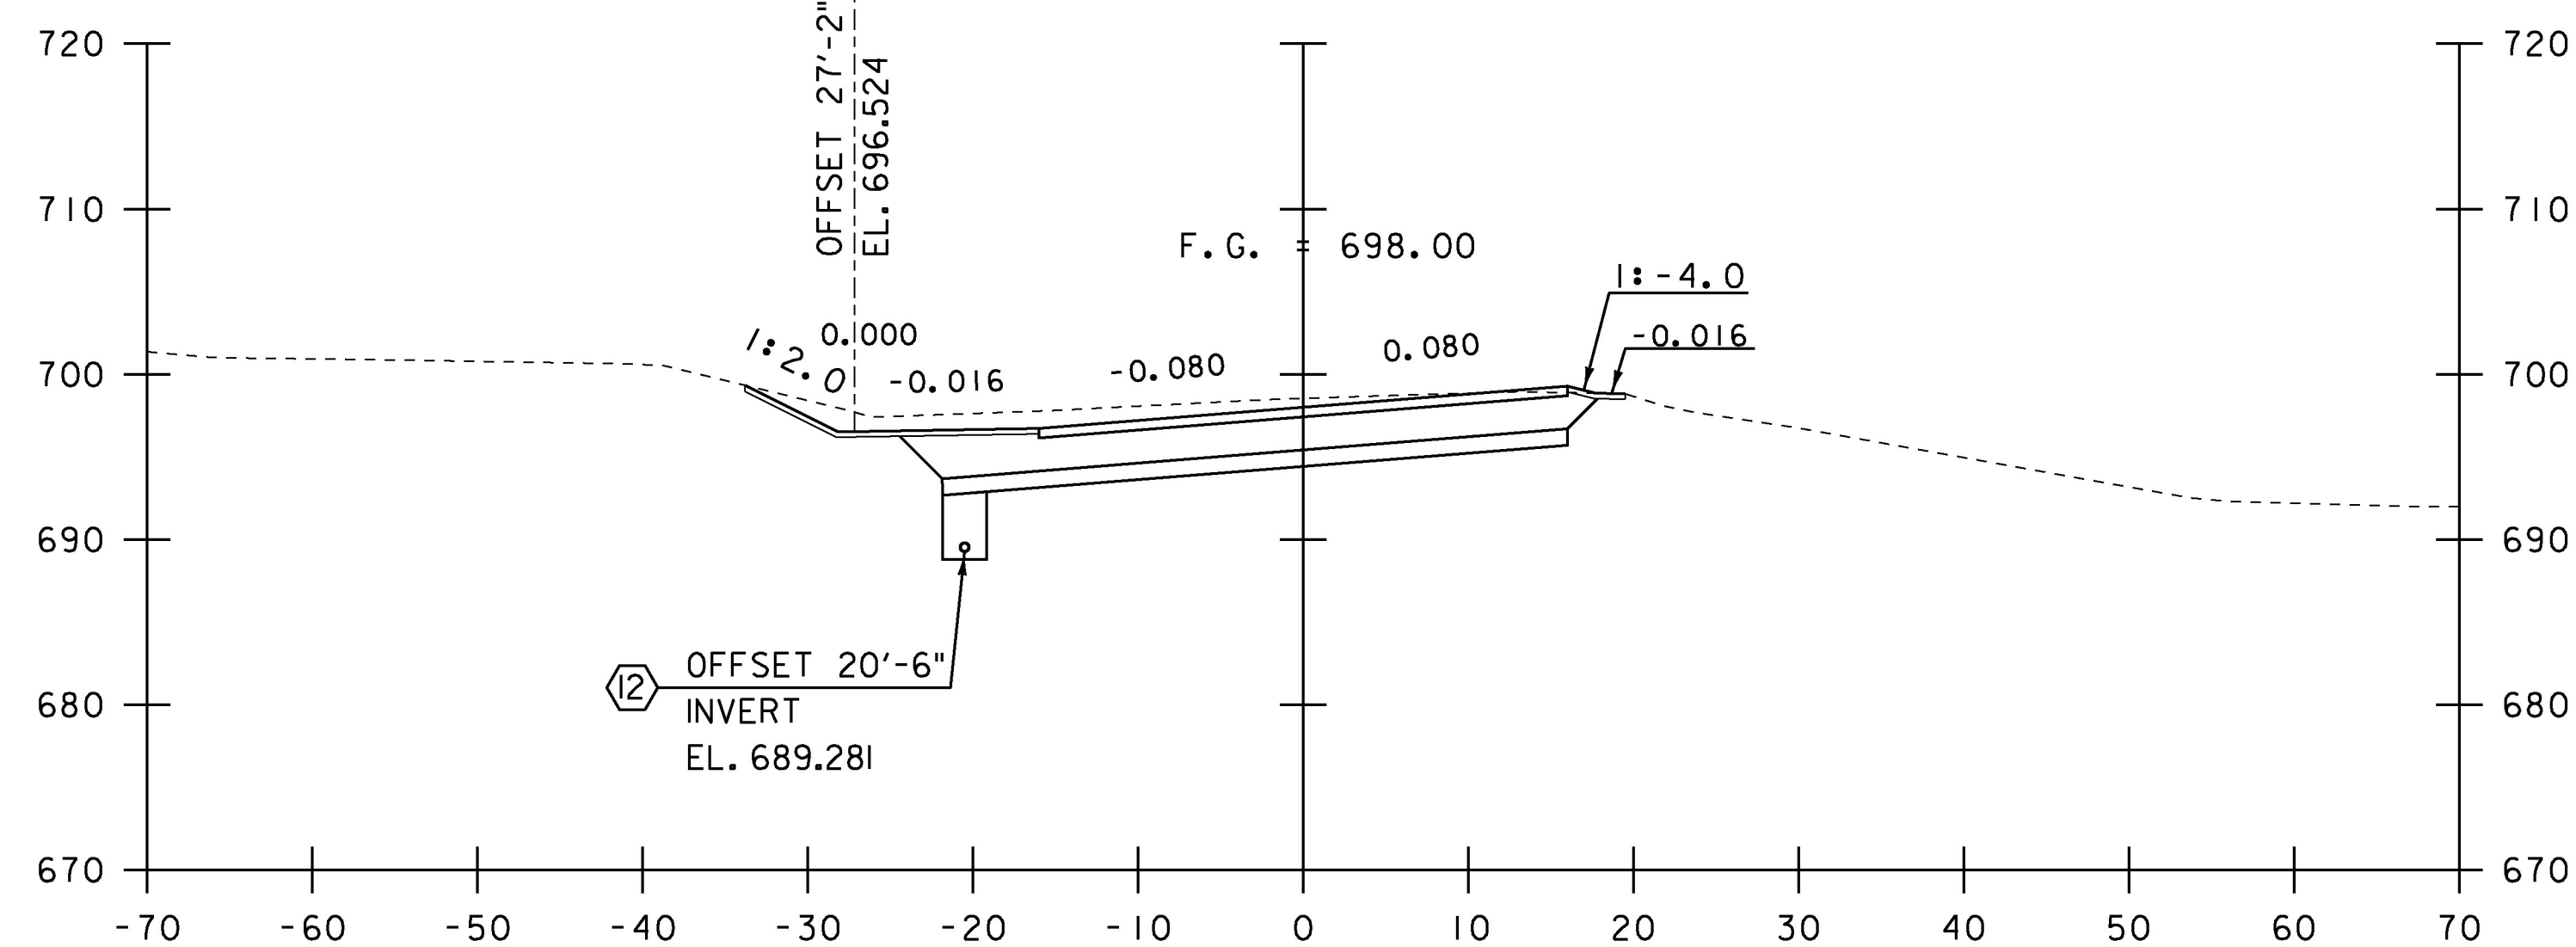

208+00

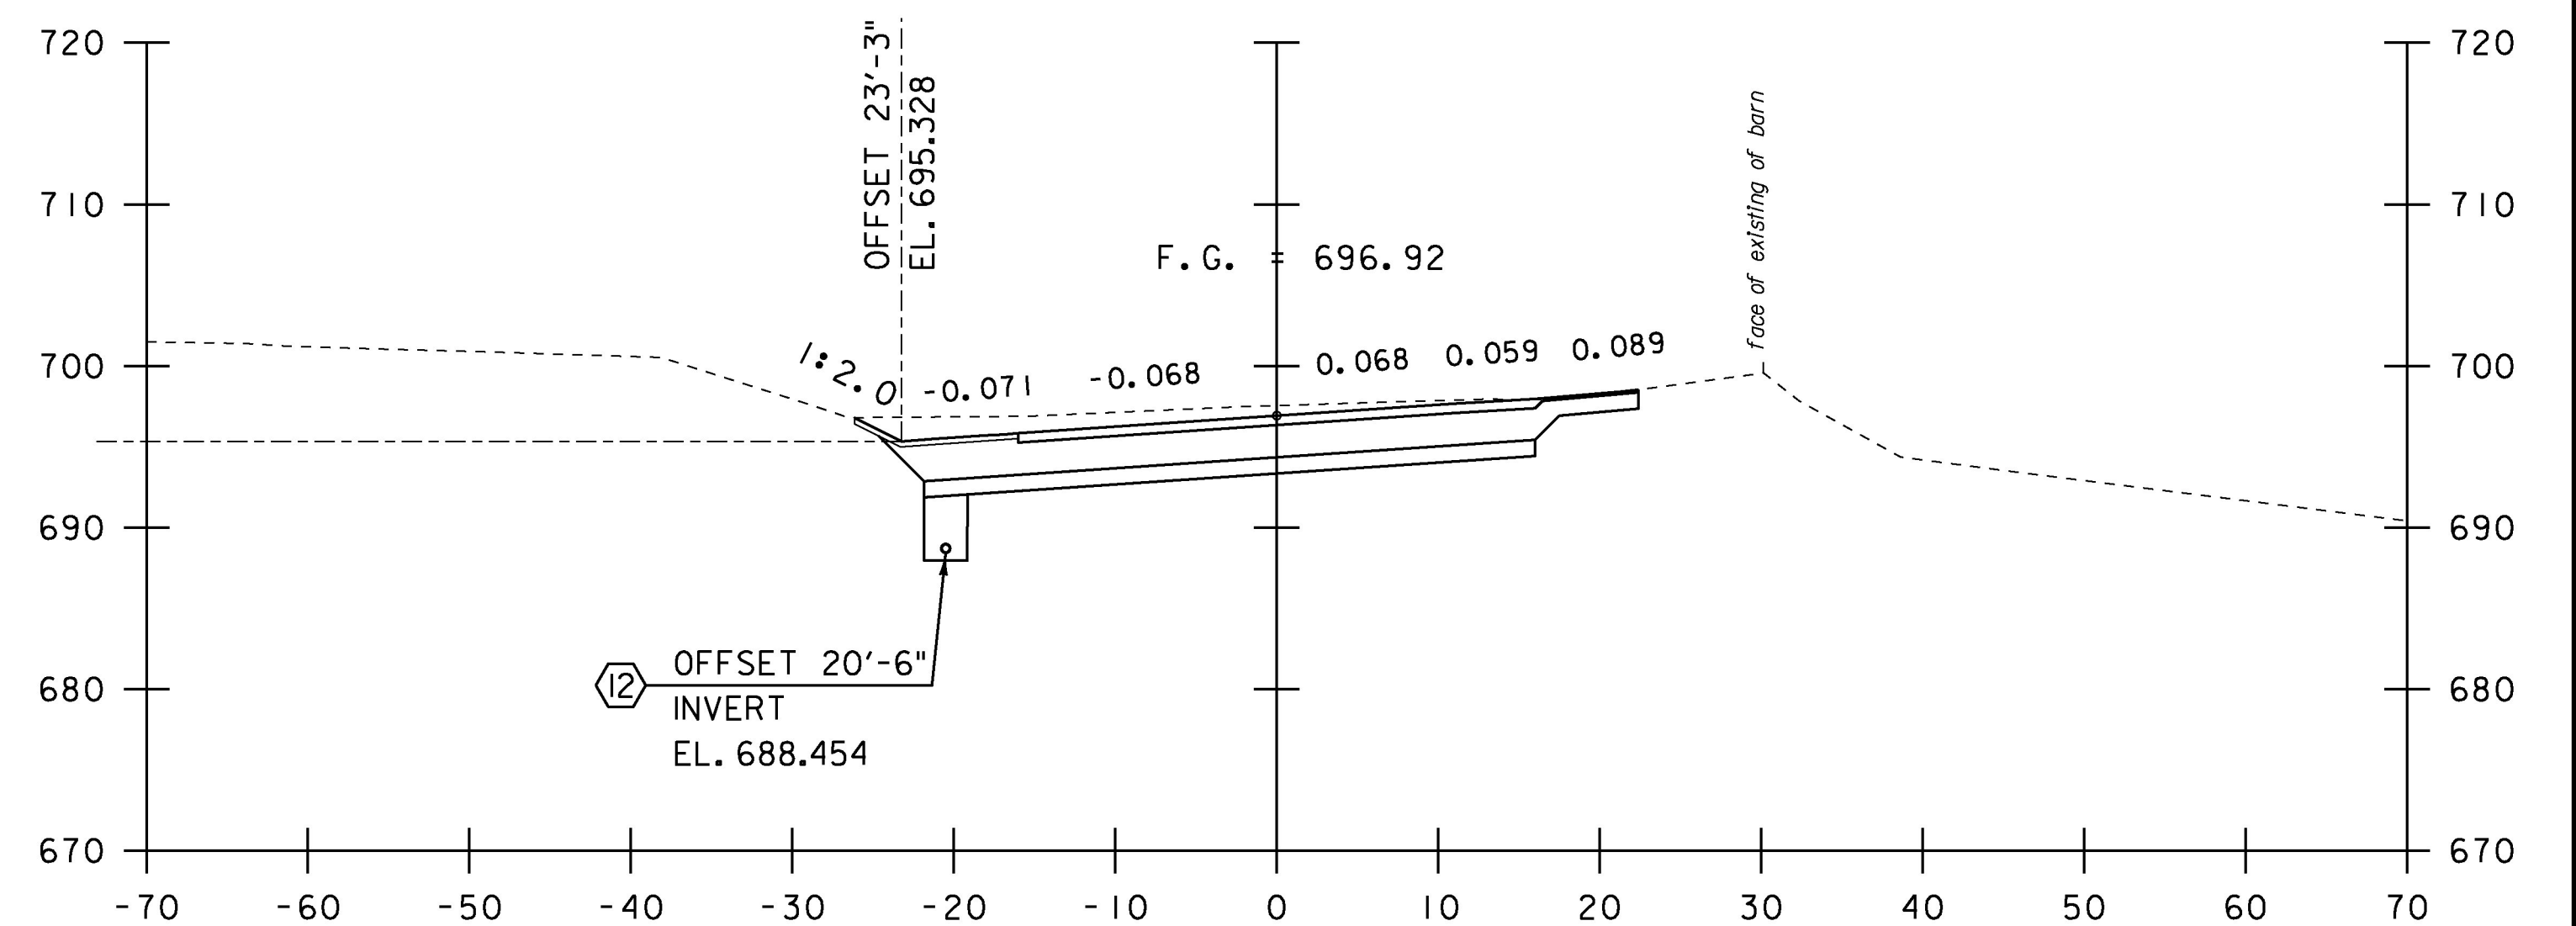

208+45
BARN DRIVE RT

STA. 208+00 TO STA. 208+50

PROJECT NAME:	MORRISTOWN
PROJECT NUMBER:	BRS 0240(3)S/STP HES 030-2(28)
FILE NAME:	s78f329xs.dgn
PROJECT LEADER:	C. CARLSON
DESIGNED BY:	C. BURRALL
VT 15 SECTIONS SHEET 4	
PLOT DATE:	12-APR-2017
DRAWN BY:	G. ROKES
CHECKED BY:	J. LACROIX
SHEET	117 OF 175