




212+00

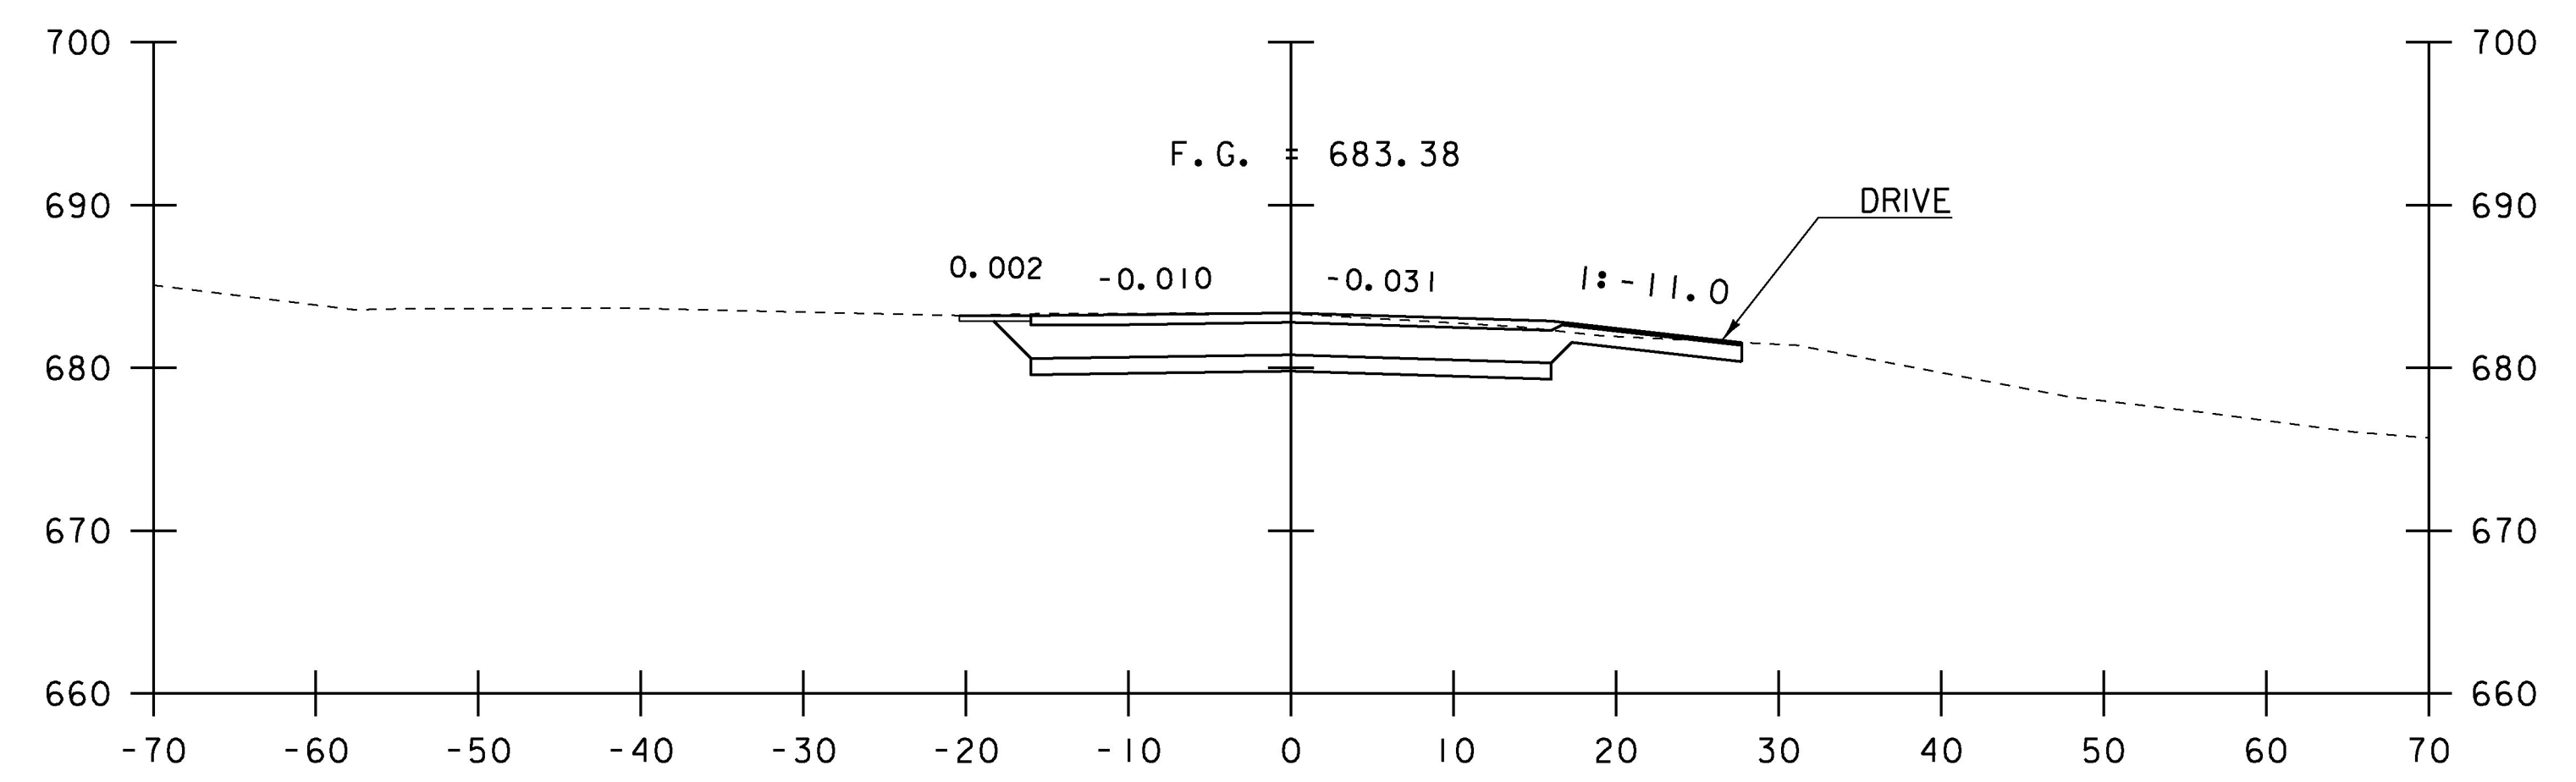


213+00
END PROJECT

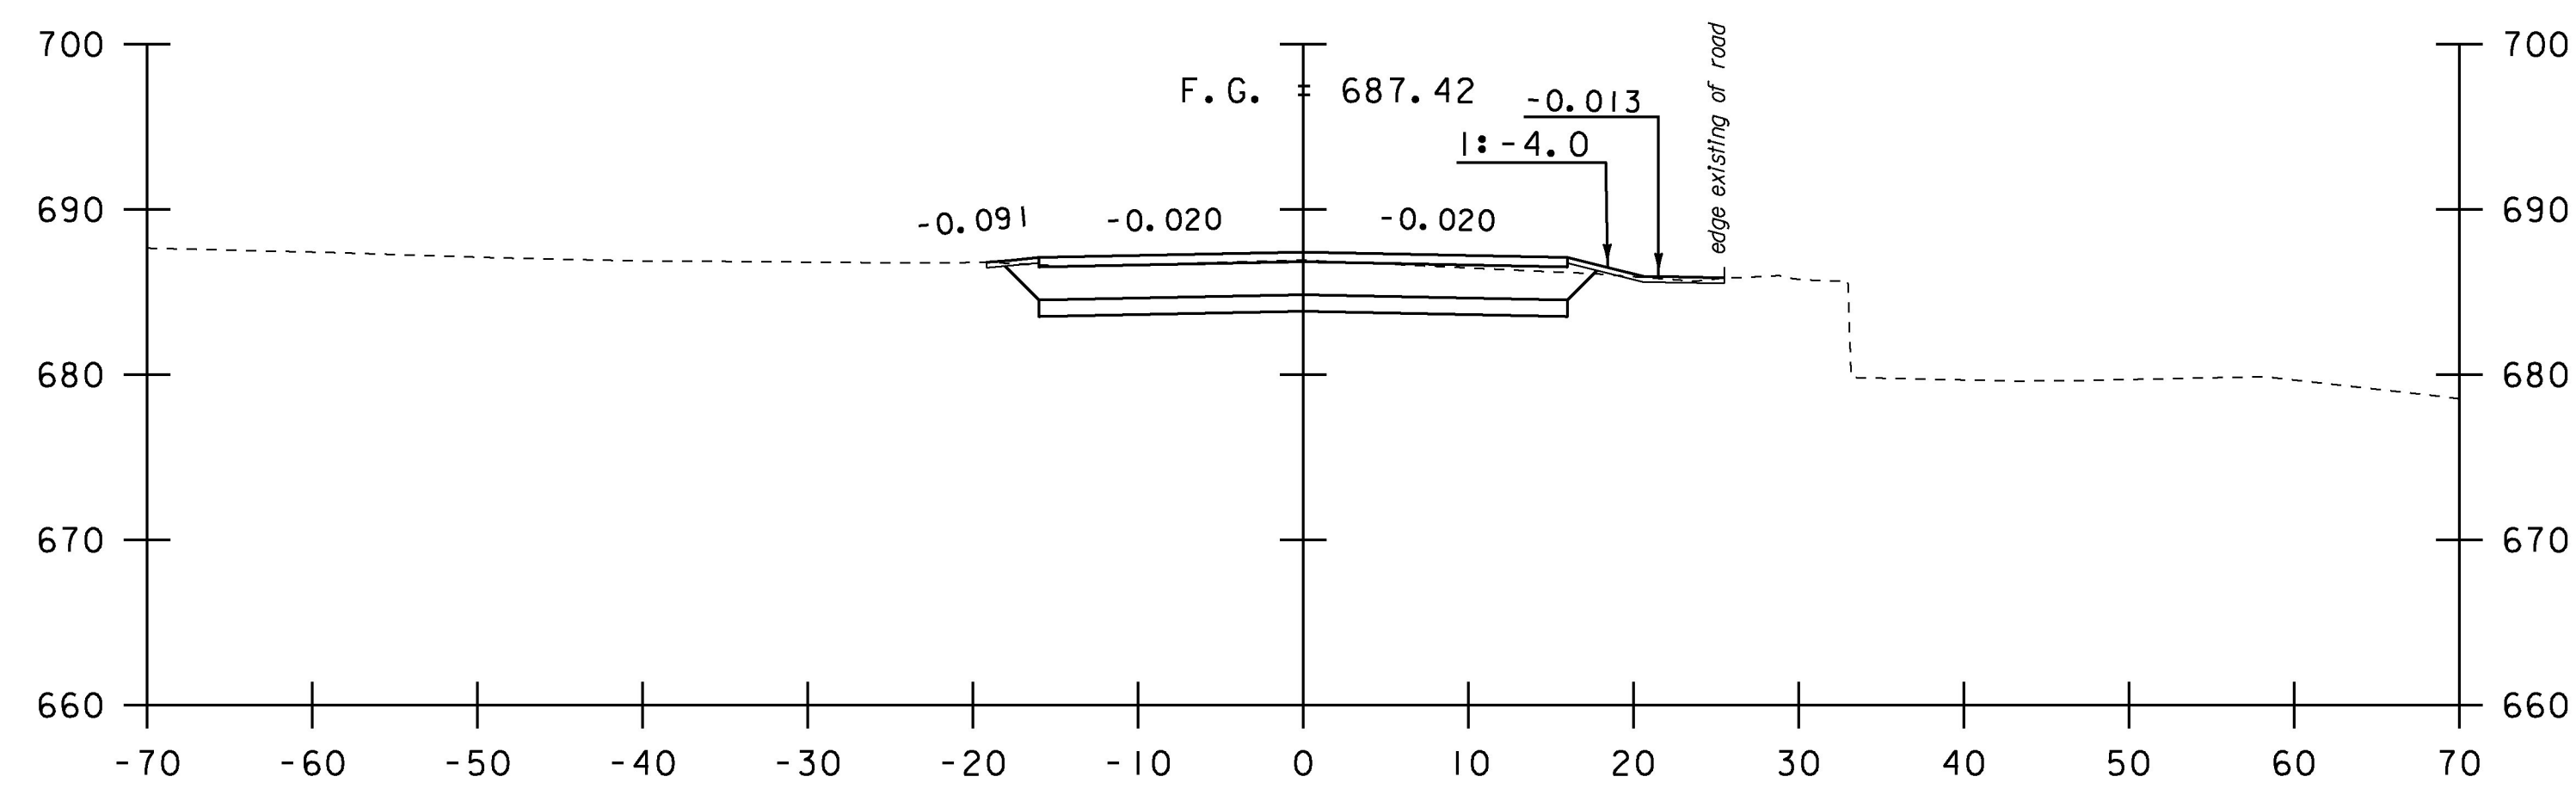


211+50

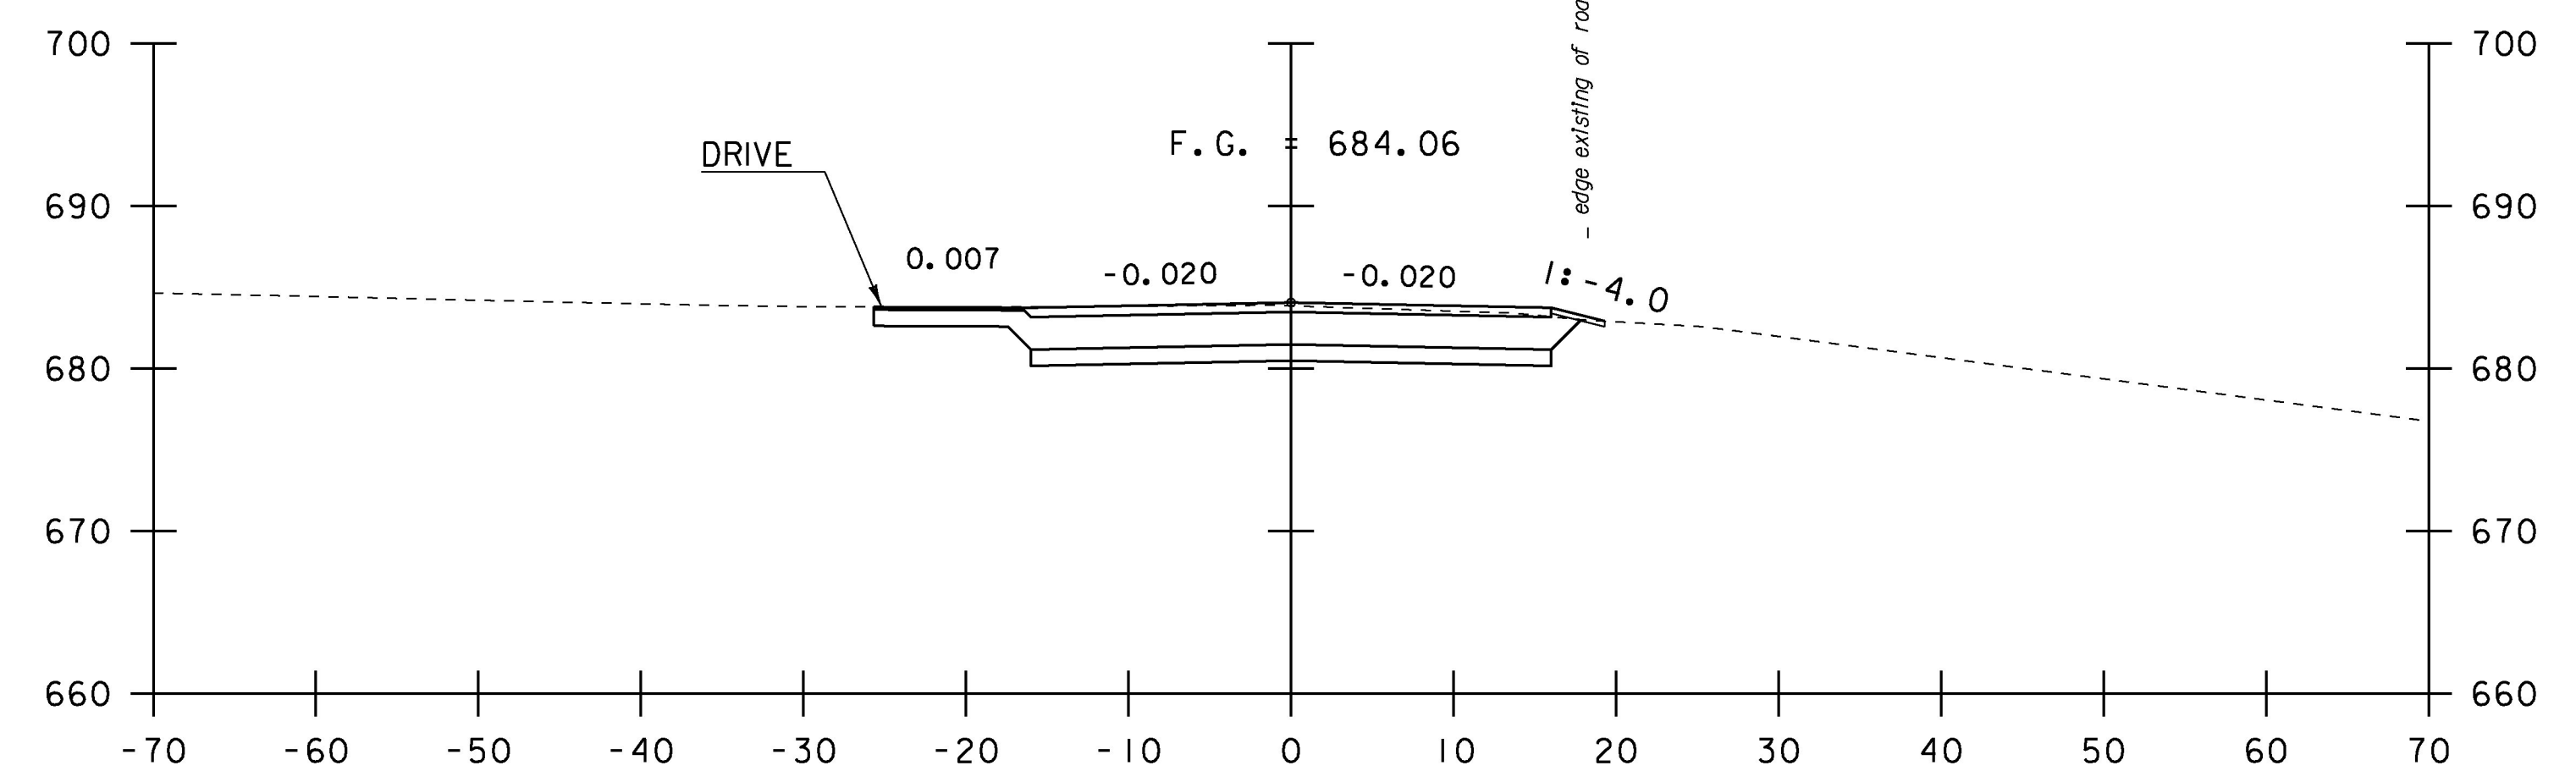

212+68
DRIVE LEFT

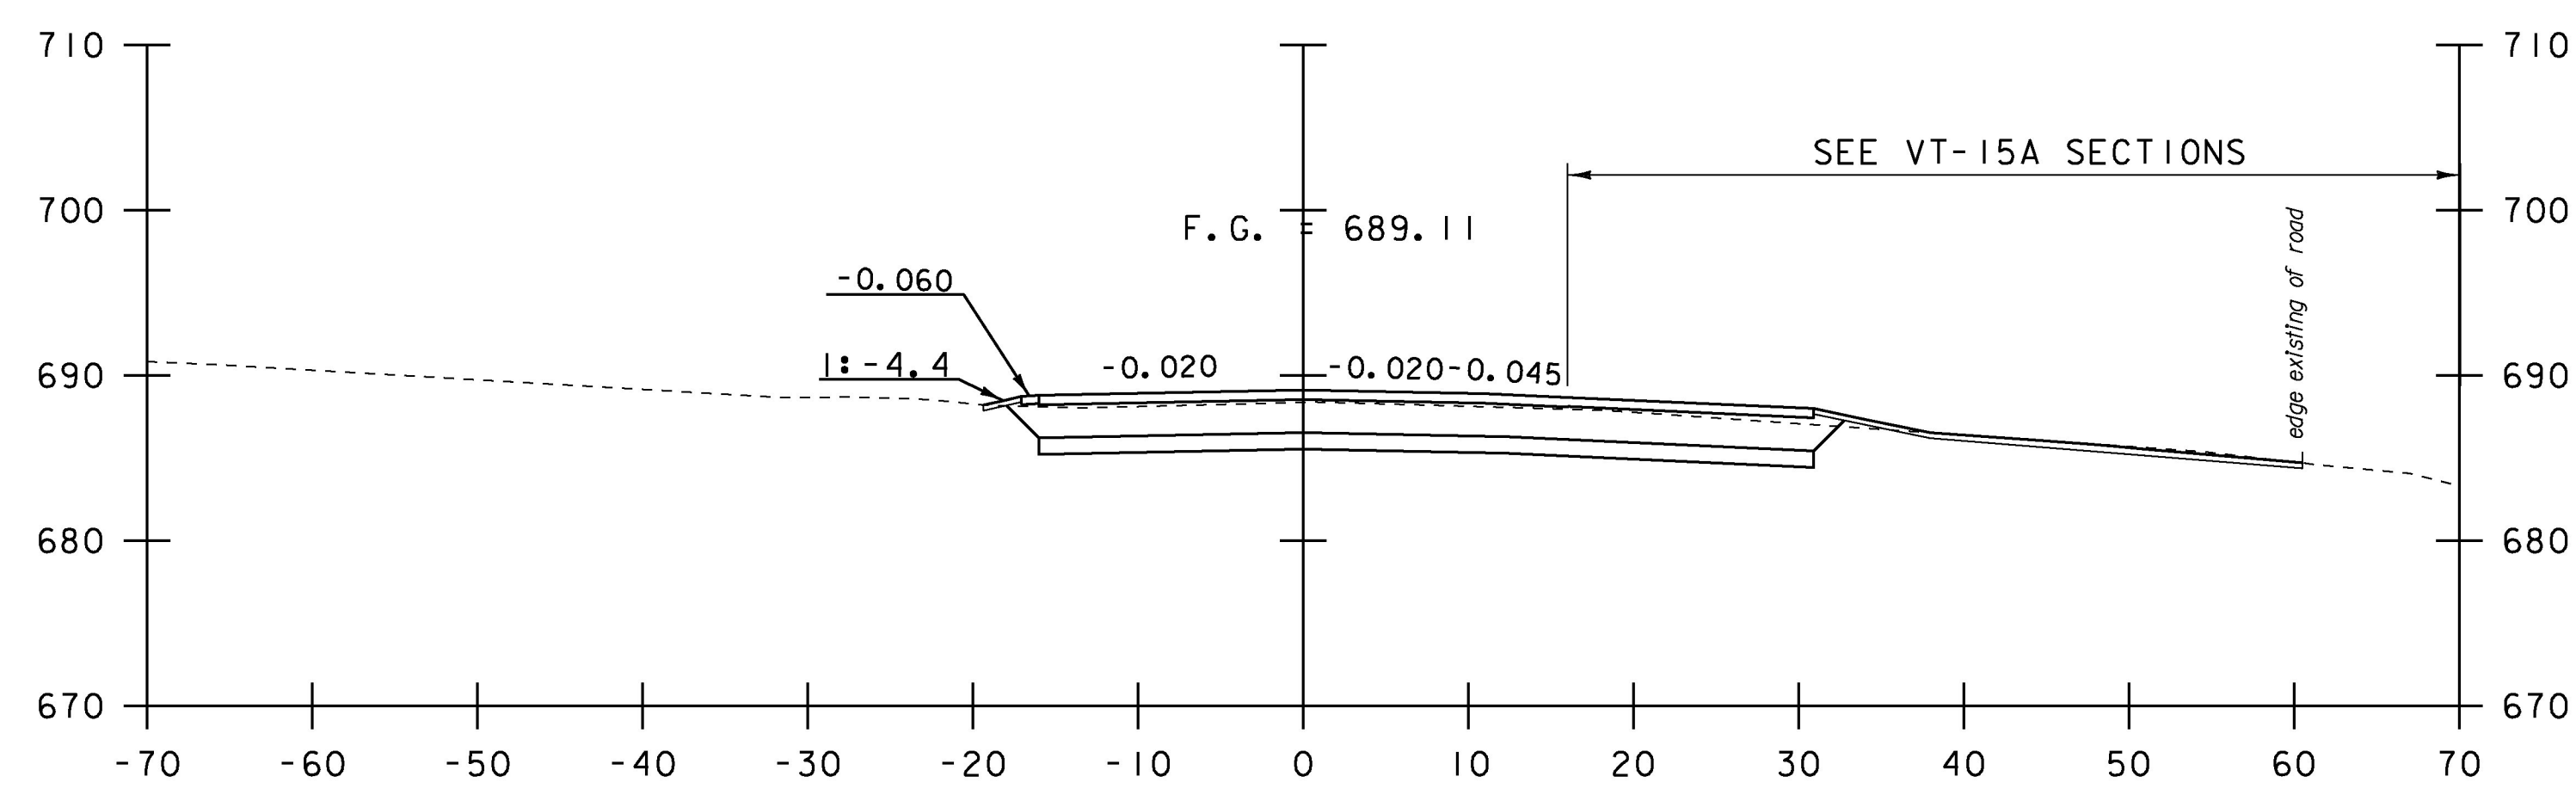

211+00

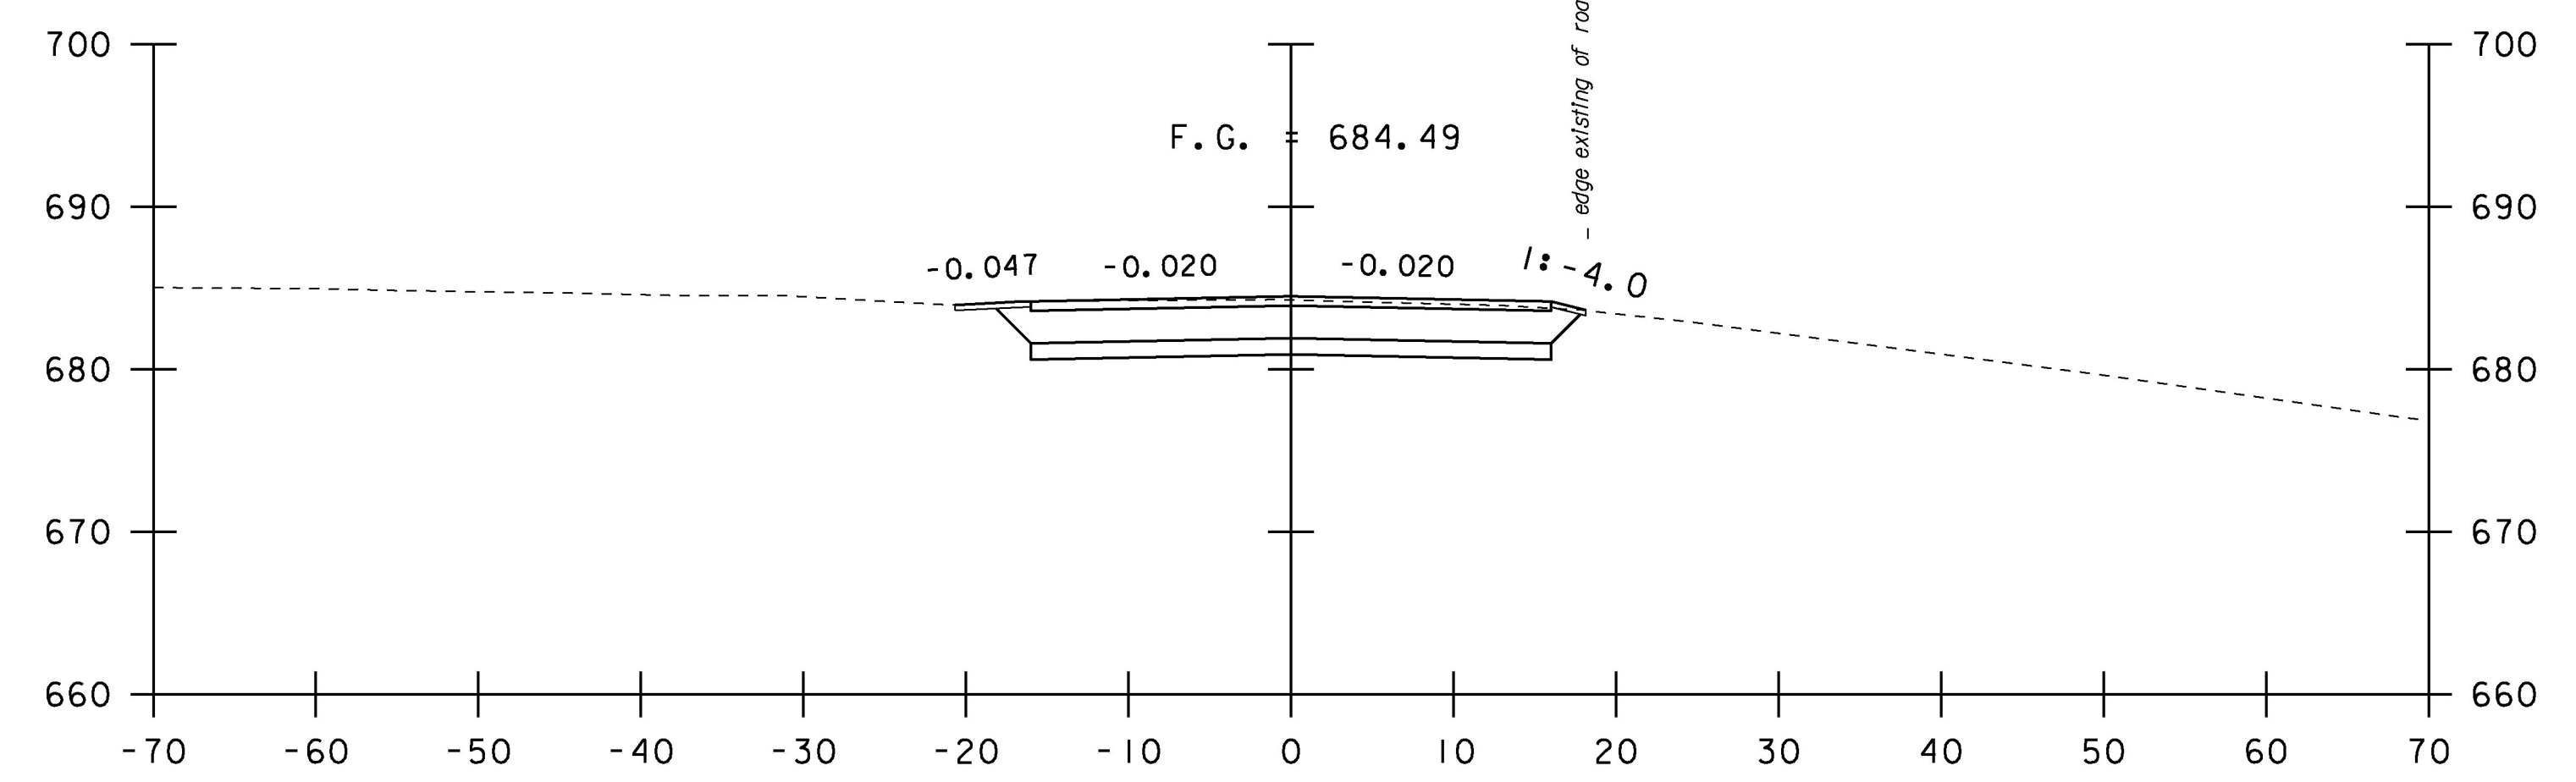

212+50

STA. 211+00 TO STA. 213+00

PROJECT NAME:	MORRISTOWN
PROJECT NUMBER:	BRS 0240(3)S/STP HES 030-2(28)
FILE NAME:	s78f329xs.dgn
PROJECT LEADER:	C. CARLSON
DESIGNED BY:	C. BURRALL
VT 15 SECTIONS SHEET 6	
PLOT DATE:	12-APR-2017
DRAWN BY:	G. ROKES
CHECKED BY:	J. LACROIX
SHEET	119 OF 175