


VT-15 BANKING DIAGRAM
 VERTICAL SCALE N.T.S.
 HORIZONTAL SCALE 1" = 50'-0"

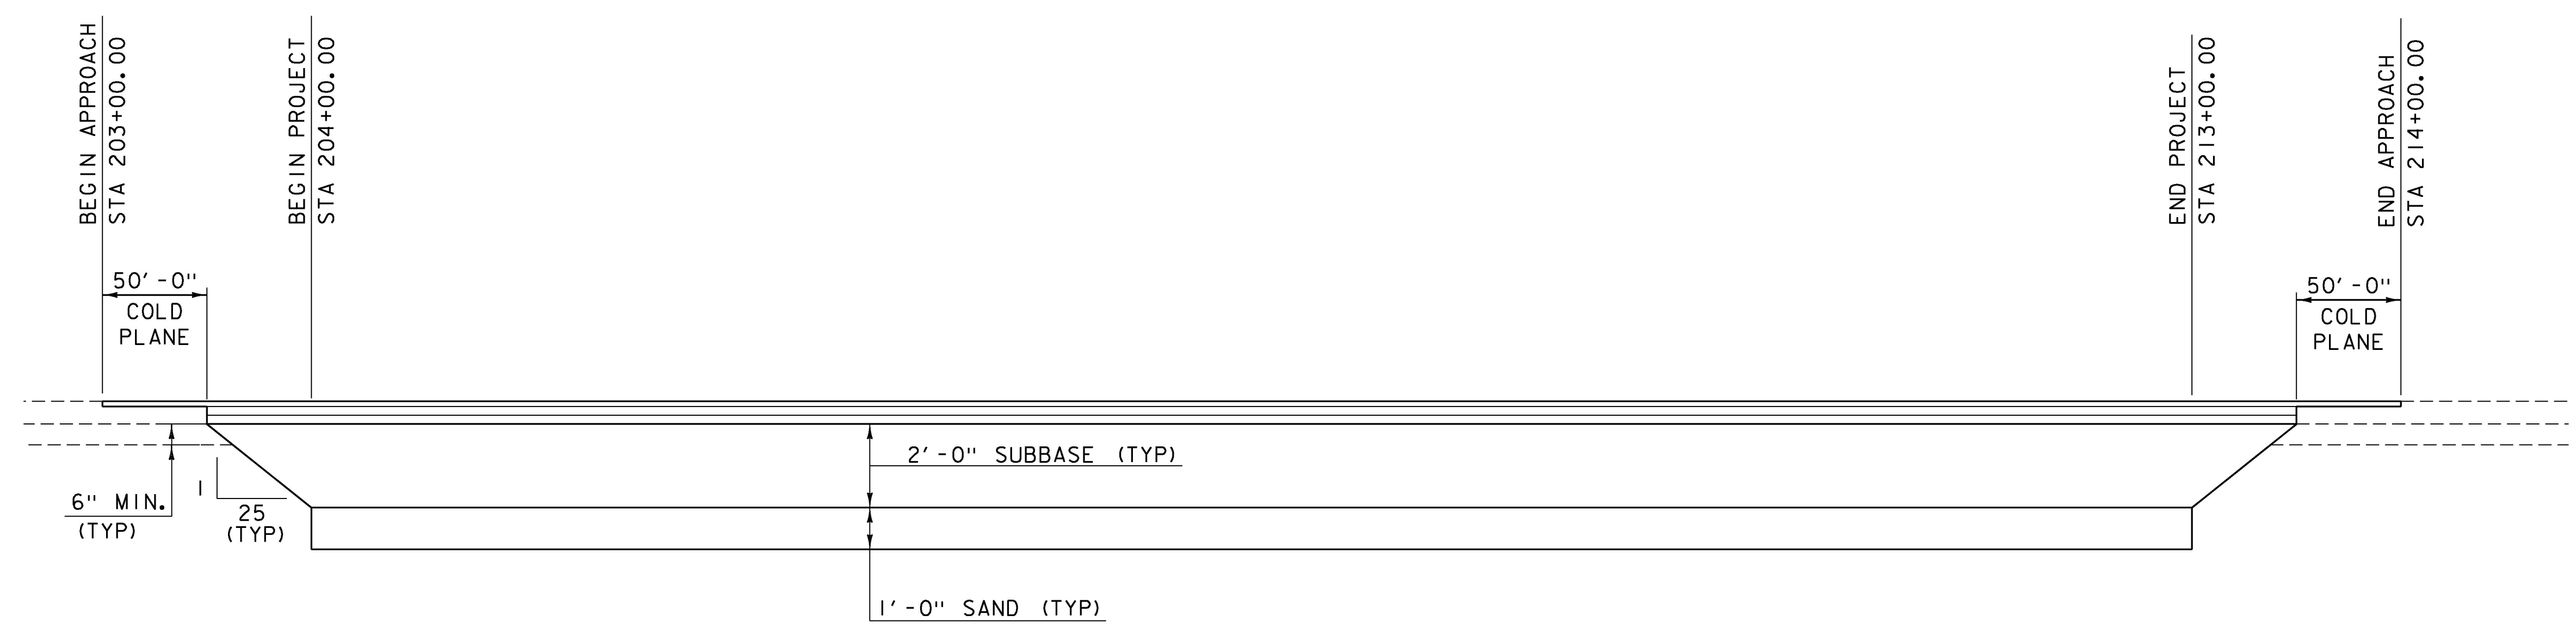

VT-15 MATERIAL TRANSITION DIAGRAM
 VERTICAL SCALE N.T.S.
 HORIZONTAL SCALE 1" = 50'-0"

SEE "VT-15 ROAD TYPICAL" FOR MATERIAL DEPTH AND TYPE

PROJECT NAME:	MORRISTOWN
PROJECT NUMBER:	BRS 0240(3)S/STP HES 030-2(28)
FILE NAME:	s78f329bnkmat.dgn
PROJECT LEADER:	C. CARLSON
DESIGNED BY:	C. BURRALL
VT 15 BANKING & MATERIAL TRANSITION	
PLOT DATE:	12-APR-2017
DRAWN BY:	G. ROKES
CHECKED BY:	J. LACROIX
SHEET	121 OF 175