
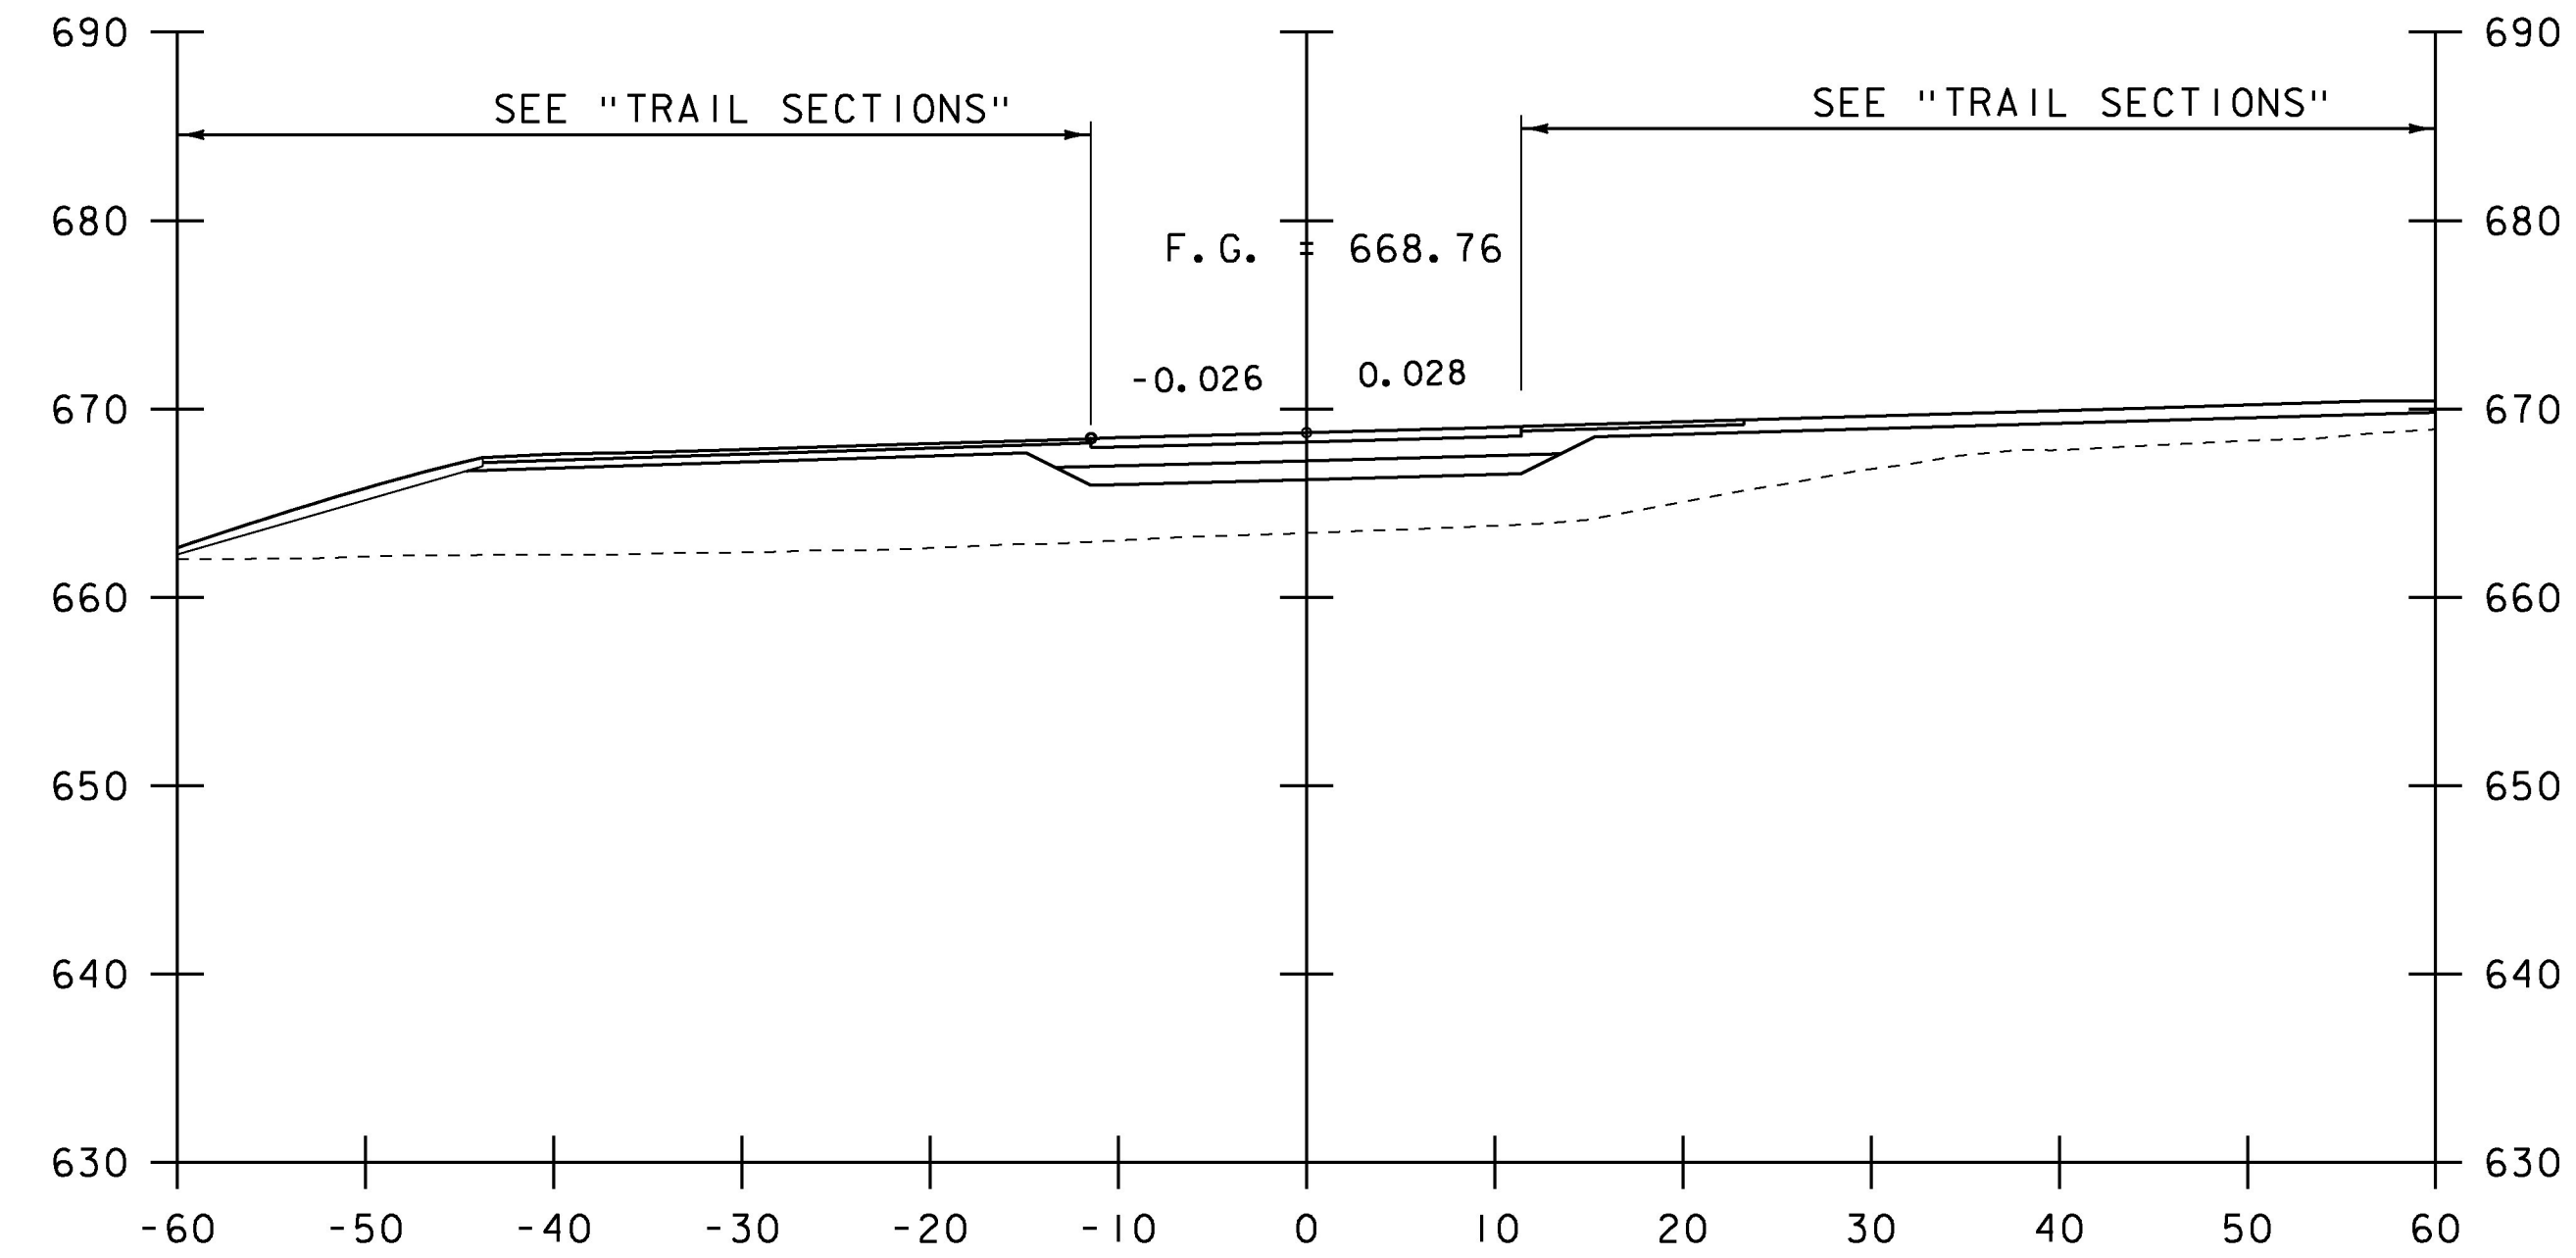



DI-1 NEW 48 INCH DIA.
 PRECAST REINFORCED CONCRETE DROP INLET
 SEE "PIPE 1 AND 2 PROFILE"
 ON THE "DRAINAGE SYSTEMS PROFILES" SHEET

② 24" PIPE
 SEE "PIPE 1 AND 2 PROFILE"
 ON THE "DRAINAGE SYSTEMS PROFILES" SHEET


③ 24" PIPE
 SEE "PIPE 1 AND 2 PROFILE"
 ON THE "DRAINAGE SYSTEMS PROFILES" SHEET

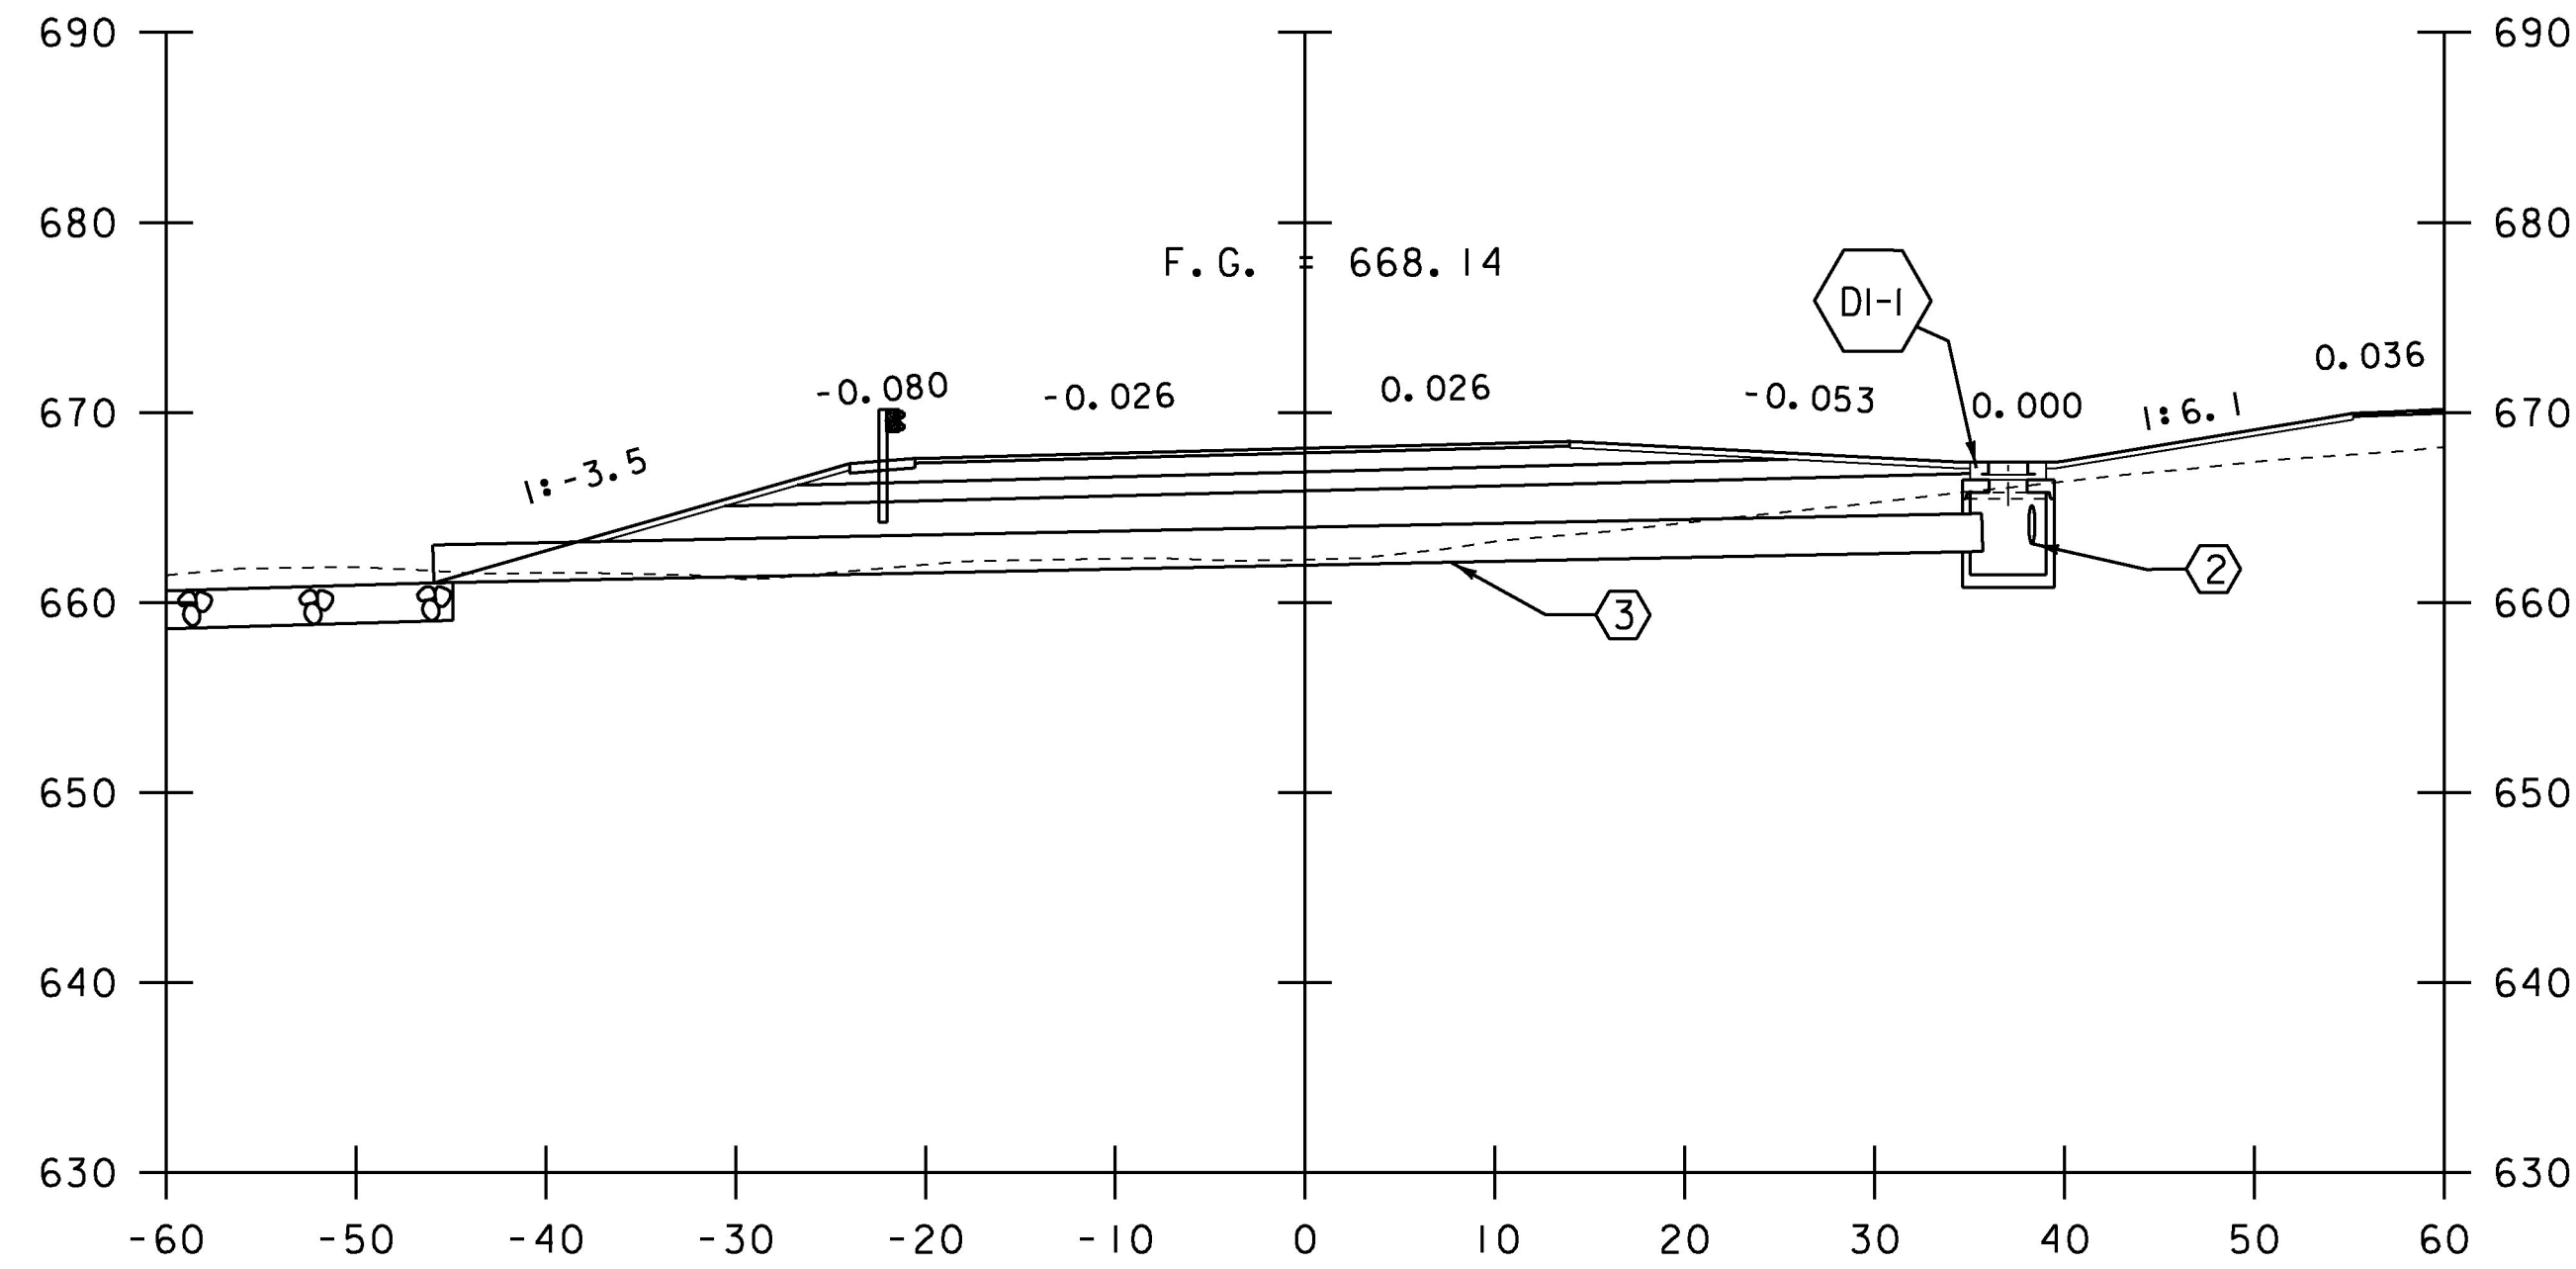

10+30
 SKEWED PIPE SECTION

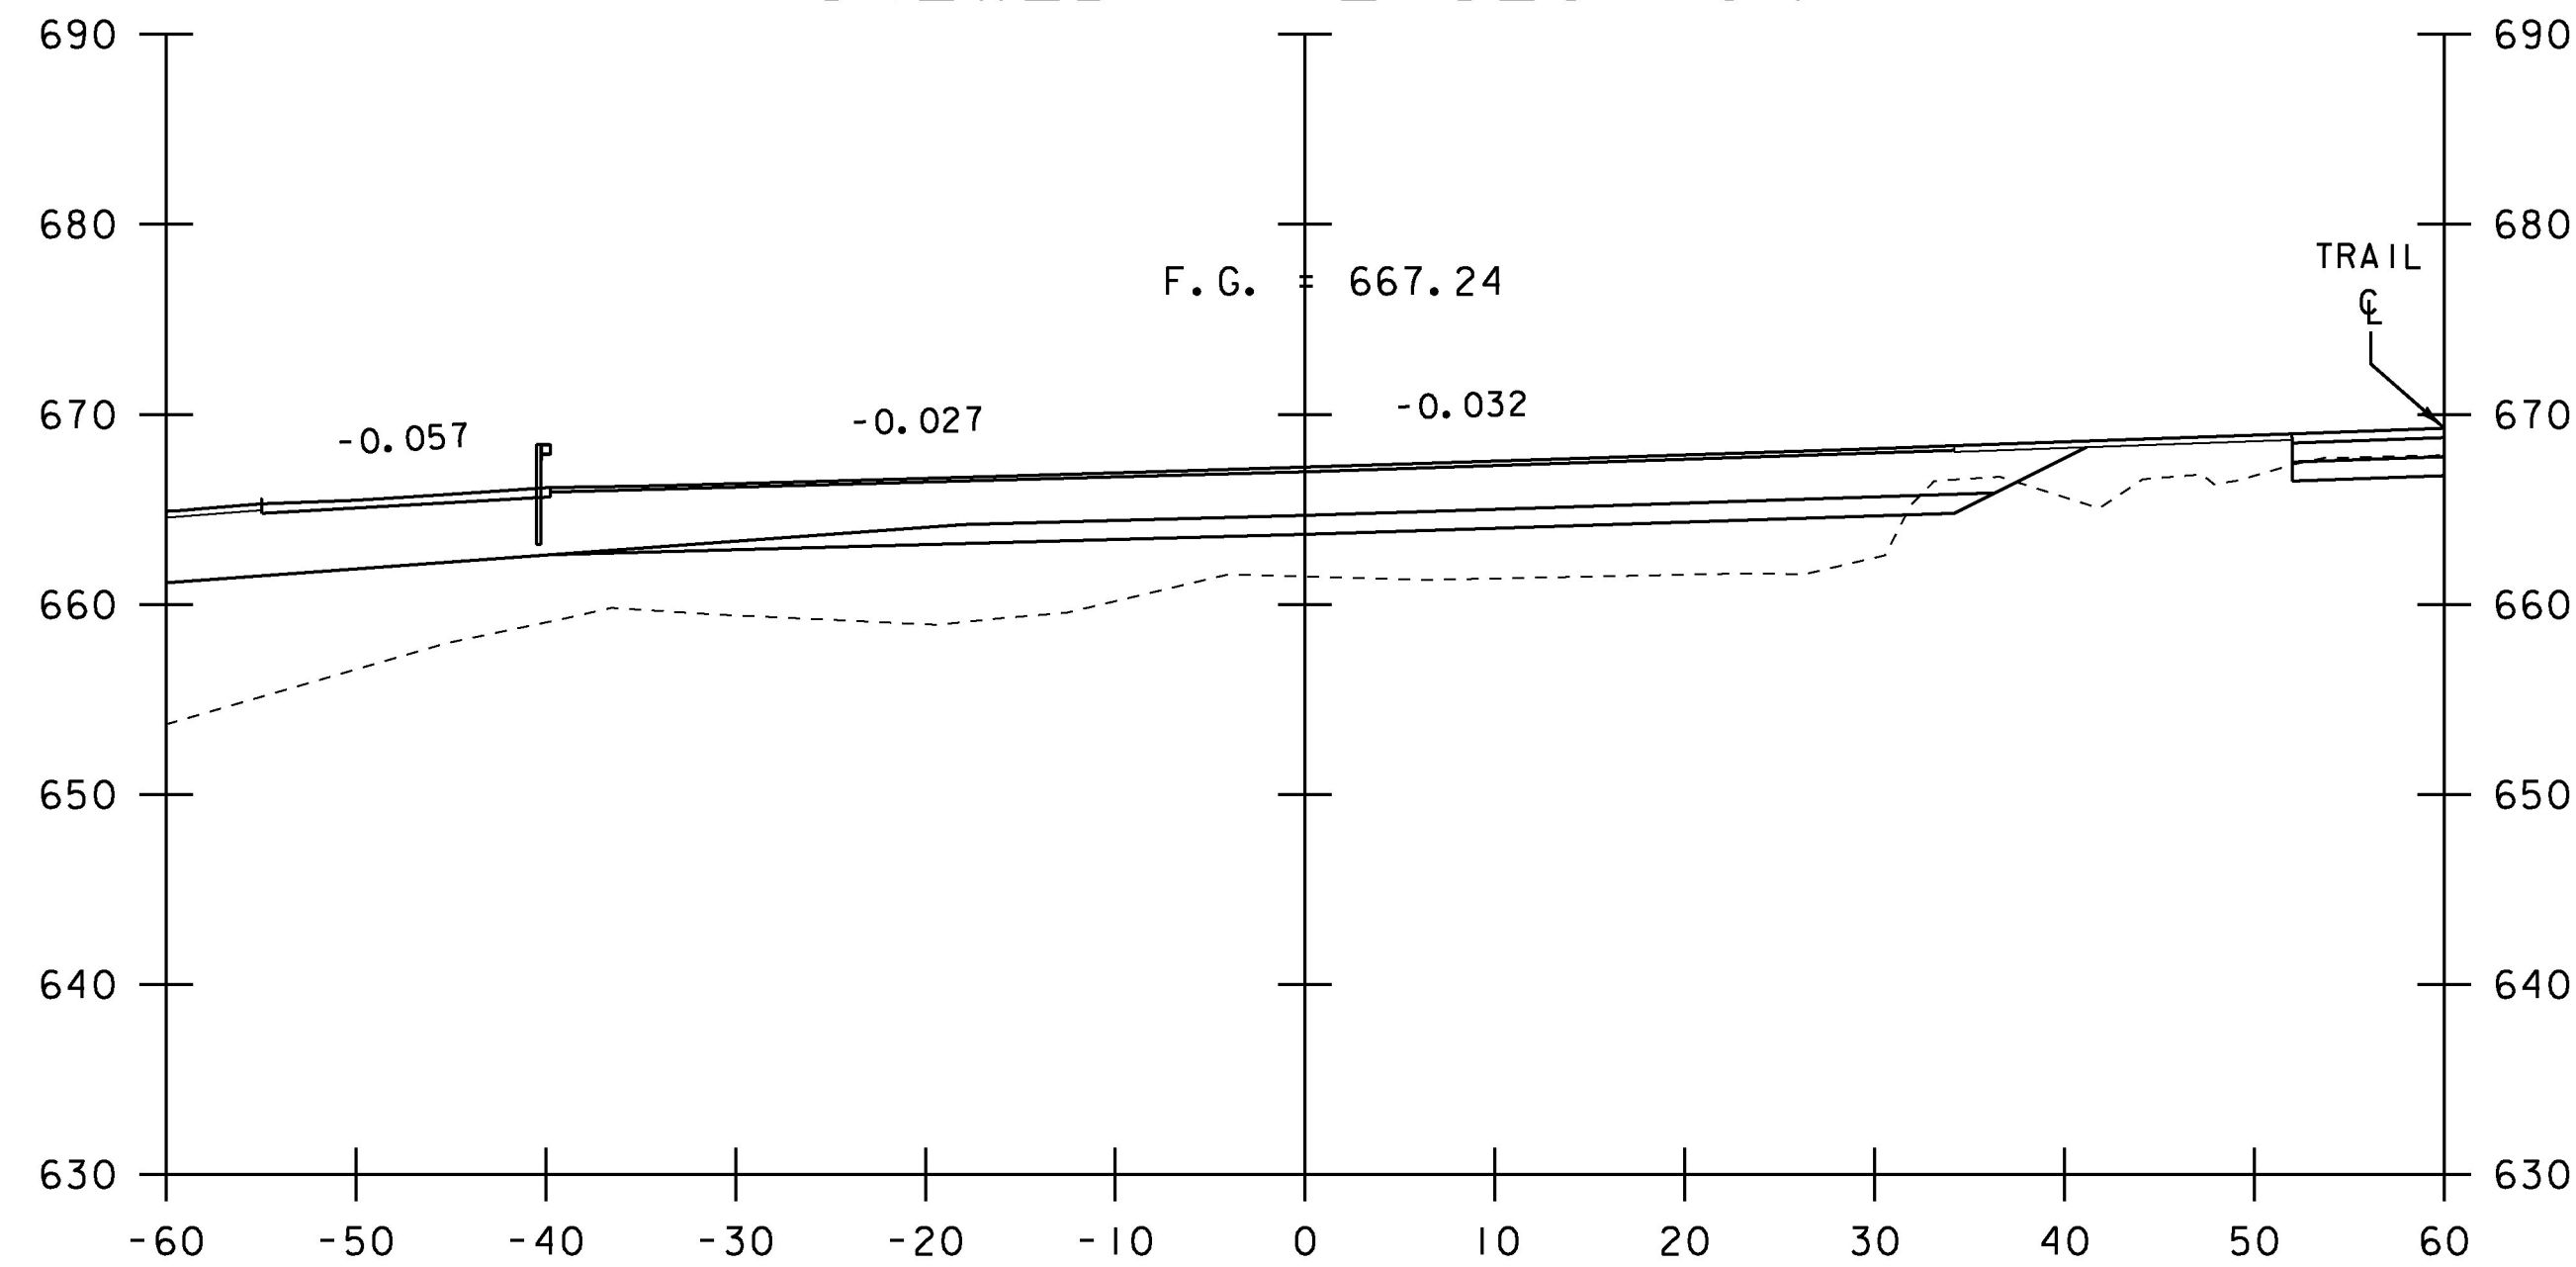

10+60
 TRAIL TO TH-22 CROSSING @ 15°

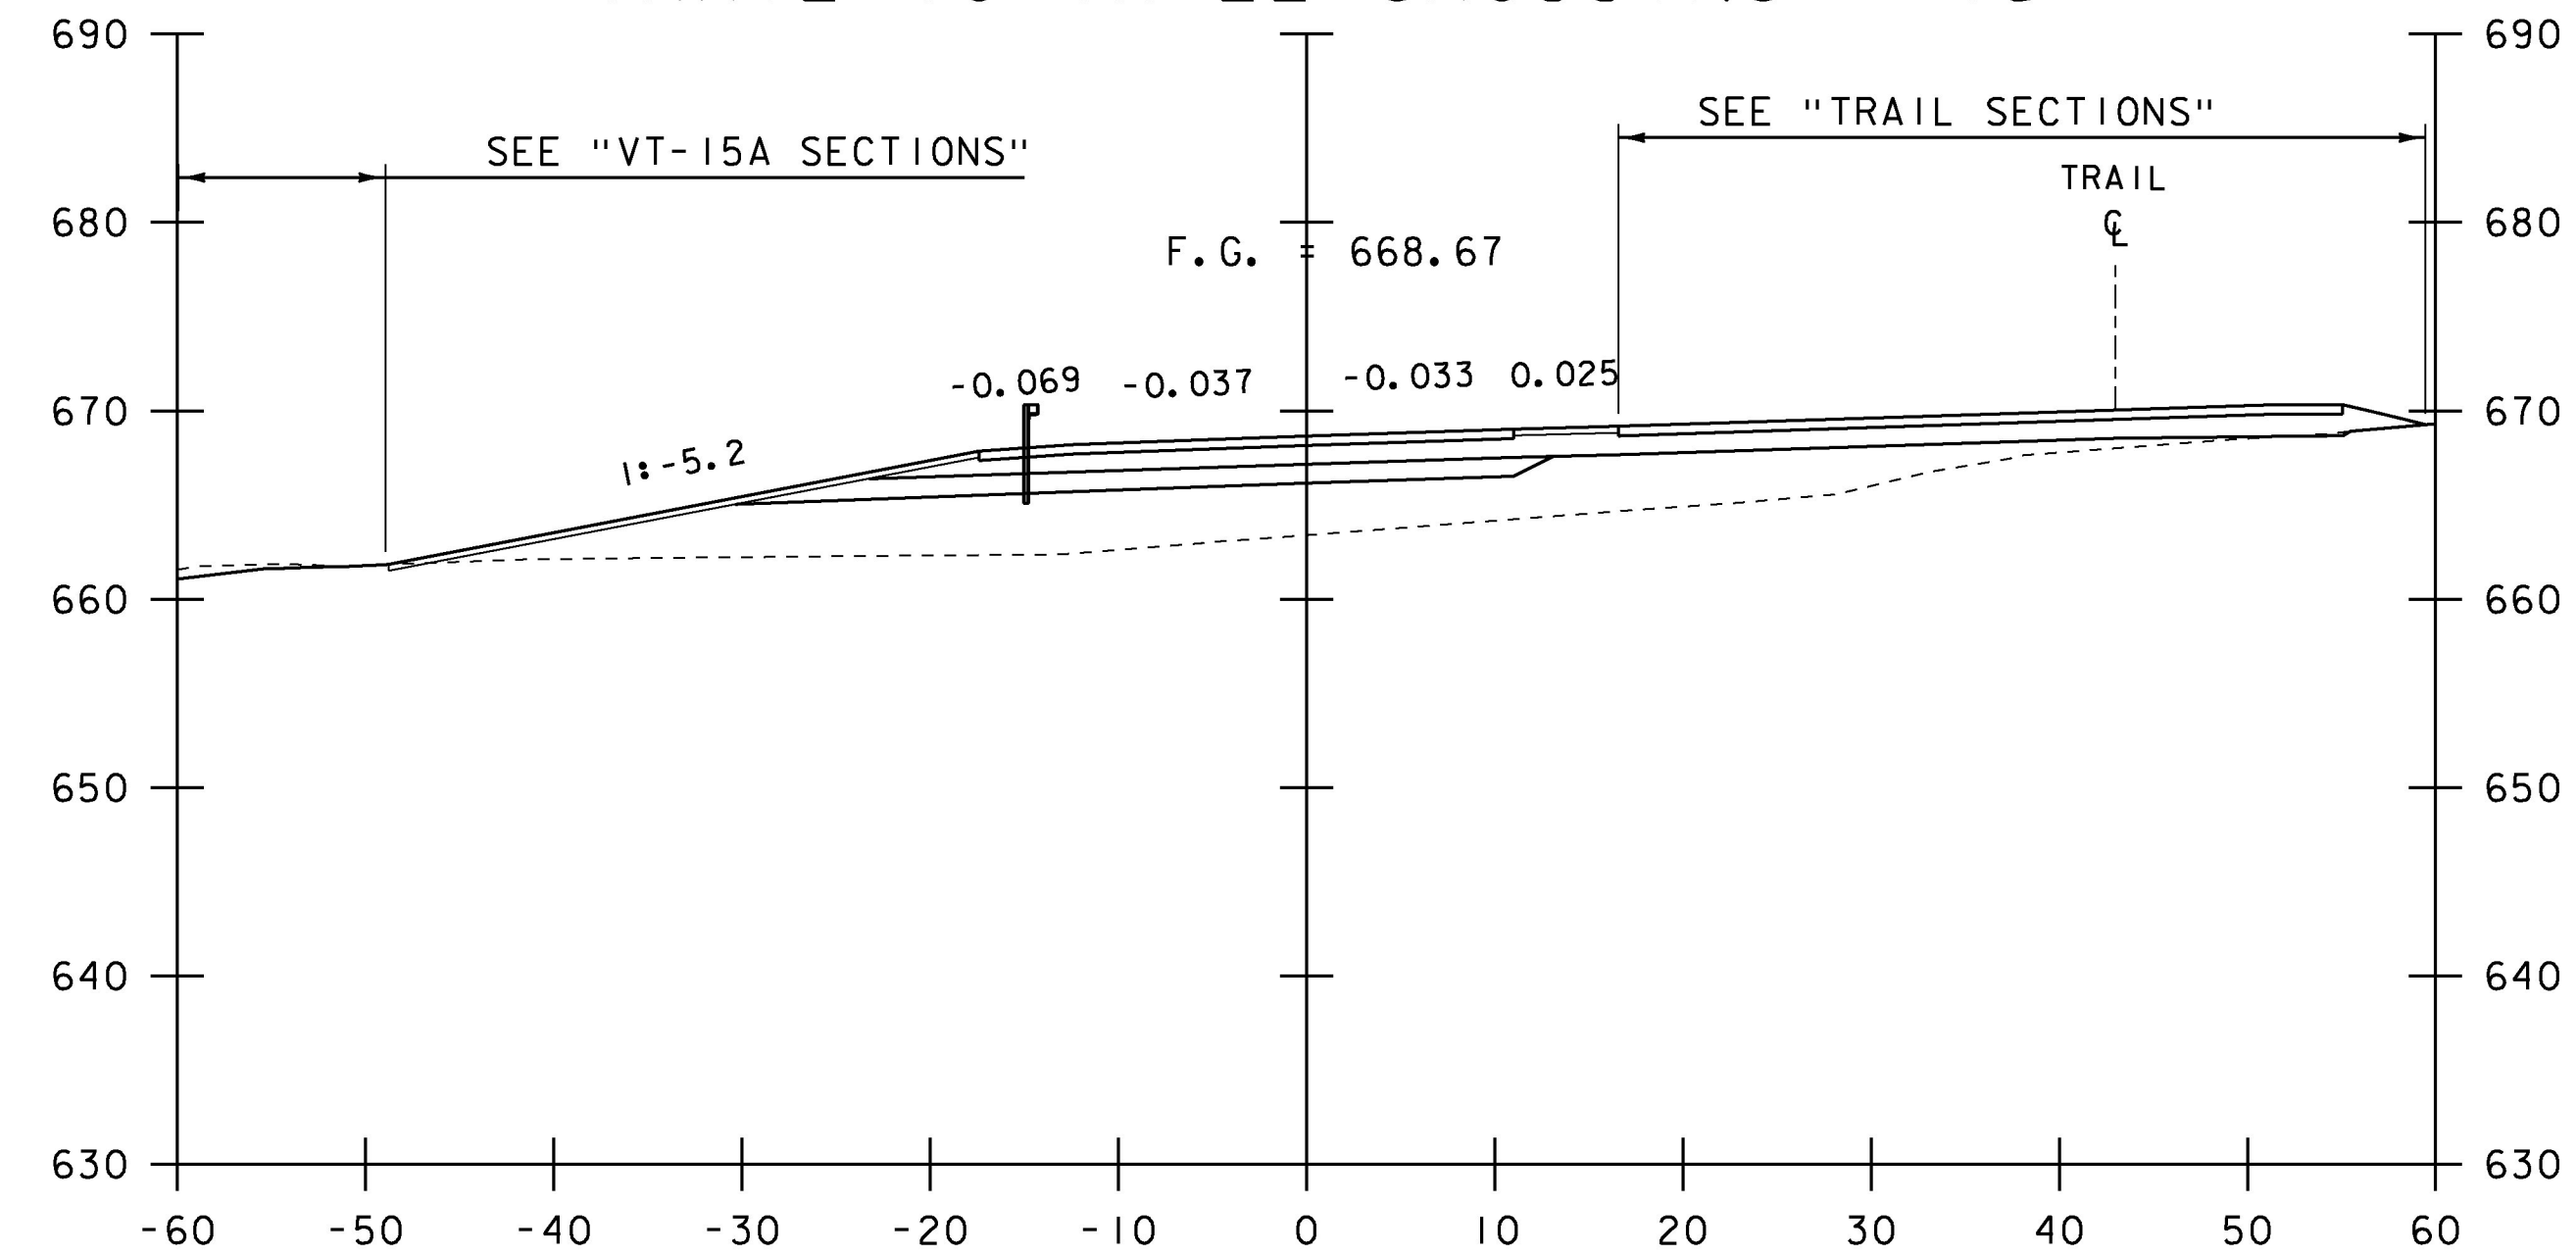

10+15
 EDGE OF VT-15A

10+50

STA. 10+15 TO STA. 10+60

PROJECT NAME:	MORRISTOWN
PROJECT NUMBER:	BRS 0240(3)S/STP HES 030-2(28)
FILE NAME:	s78f329xs.dgn
PROJECT LEADER:	C. CARLSON
DESIGNED BY:	C. BURRALL
TH 22 SECTIONS SHEET I	
PLOT DATE:	12-APR-2017
DRAWN BY:	G. ROKES
CHECKED BY:	J. LACROIX
SHEET	122 OF 175